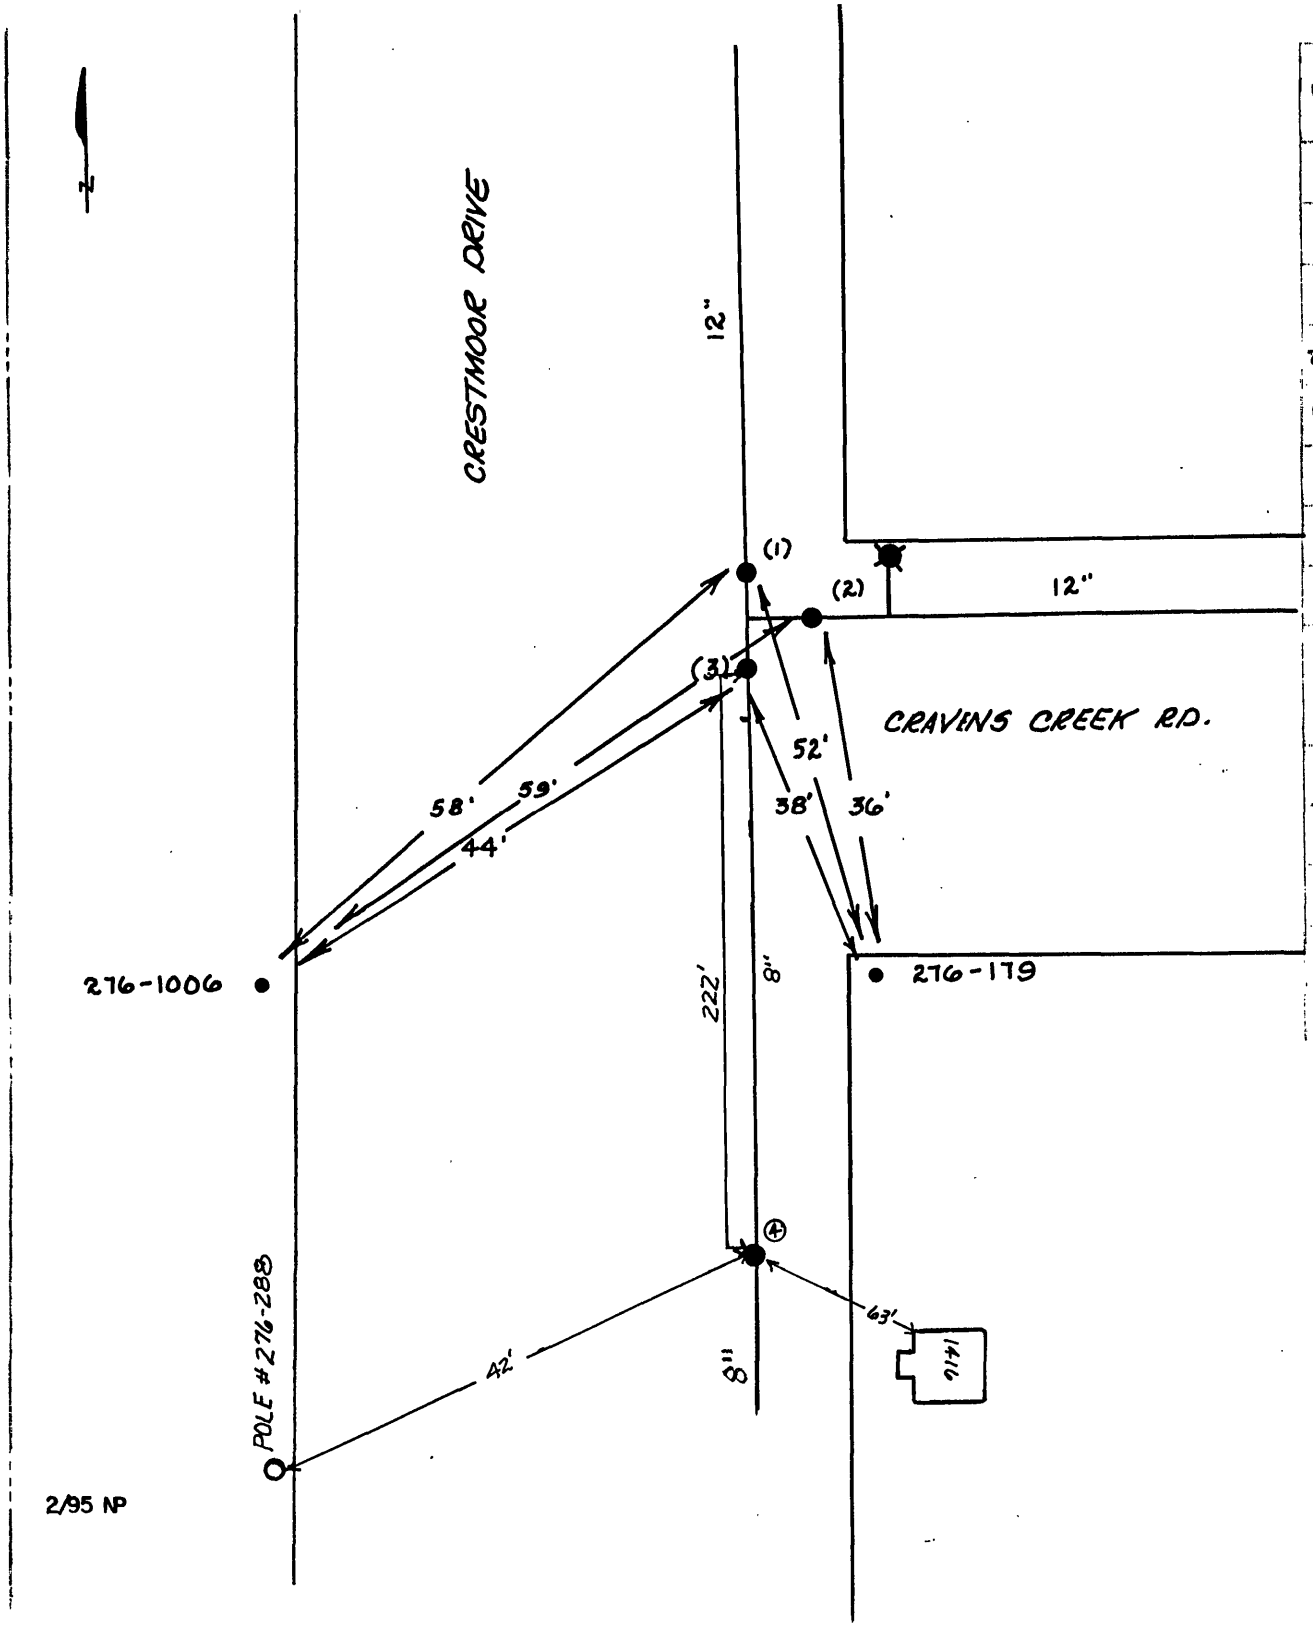

DATE	NO	SIZE	MAKE	OPEN	TURNS
11-77	1	12"	MUELLER	R	
11-77	2	12"	MUELLER	R	
11-77	3	8"	MUELLER	R	
~~6-78~~	~~4~~	~~2"~~	~~MISC.~~	~~BLOWOFF~~	
1985	4	8"		R	21

CITY OF ROANOKE--WATER DEP'T

VALVE DIAGRAM

CRAVENS CREEK ROAD AND

CRESTMOOR DRIVE

SEC. MAP 517

DATE PAGE NO.

2/95 NP