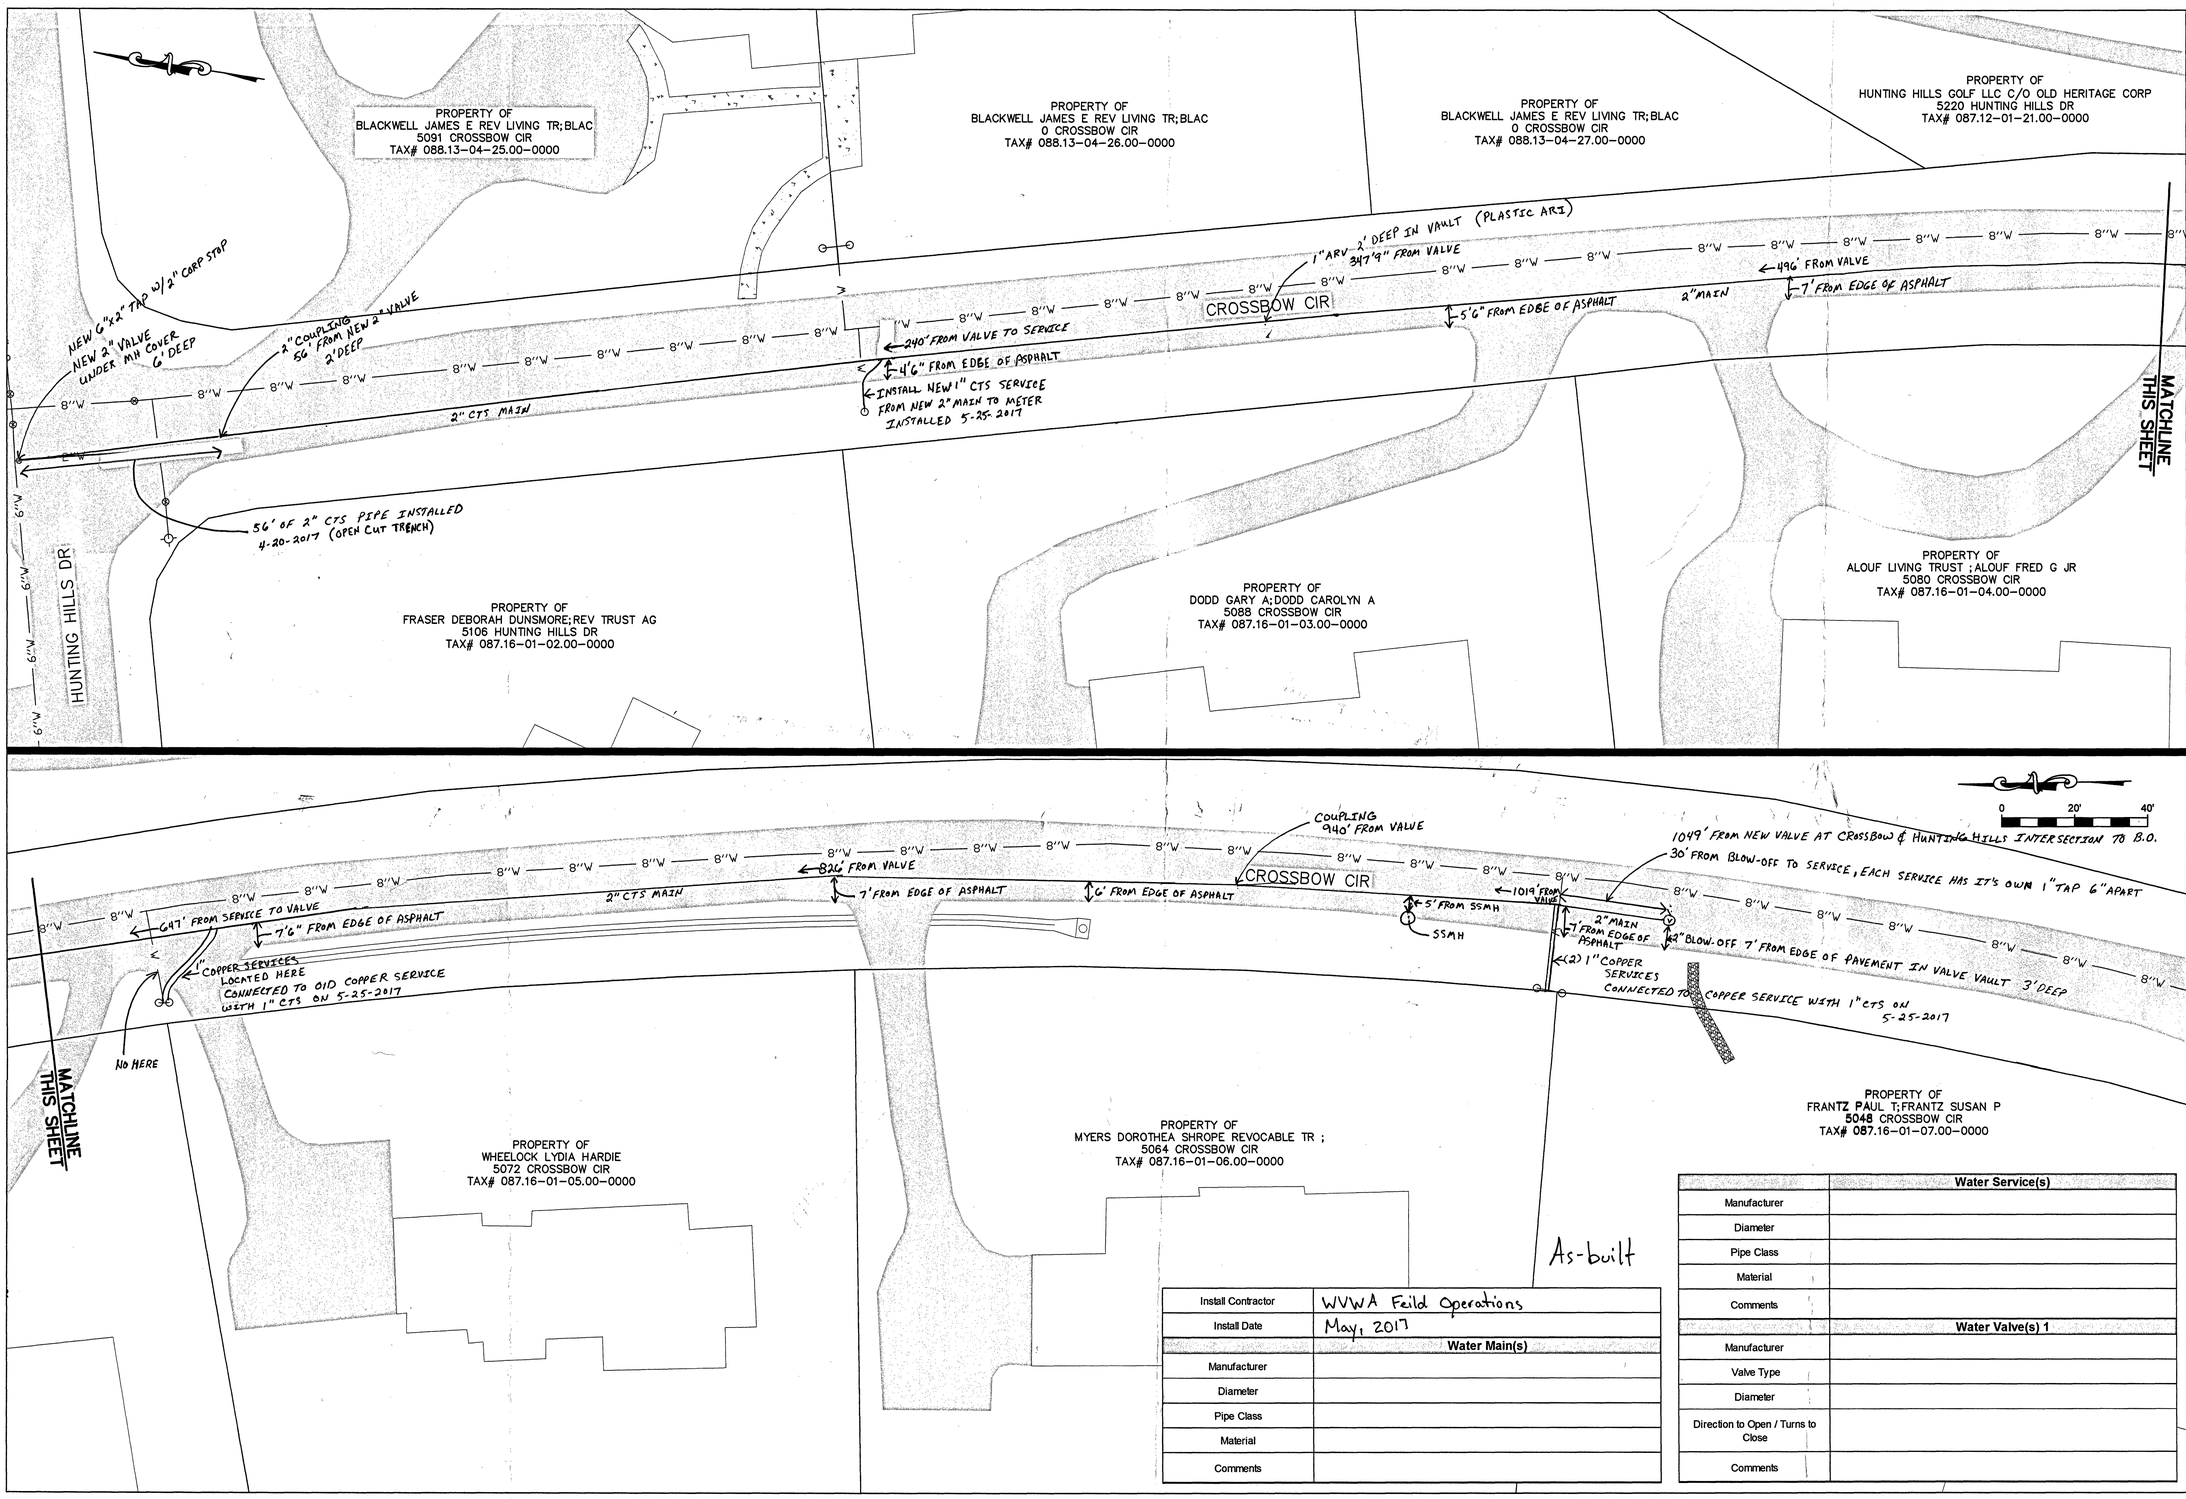

As-built

Install Contractor	WVWA Feild Operations
Install Date	May, 2017
Water Main(s)	
Manufacturer	
Diameter	
Pipe Class	
Material	
Comments	

Water Service(s)	
Manufacturer	
Diameter	
Pipe Class	
Material	
Comments	
Water Valve(s) 1	
Manufacturer	
Valve Type	
Diameter	
Direction to Open / Turns to Close	
Comments	

WESTERN VIRGINIA WATER AUTHORITY
ENGINEERING SERVICES
601 S JEFFERSON ST, SUITE 300
ROANOKE, VA 24011
540-853-5700

CROSSBOW CIRCLE HIGH PRESSURE WATERLINE

PLAN

Rev	Description	Date	By

Designed:
Drawn: DRJ
Checked:
Approved:
Date: MAY 2017
Project:

1

Sheet 1 of 1