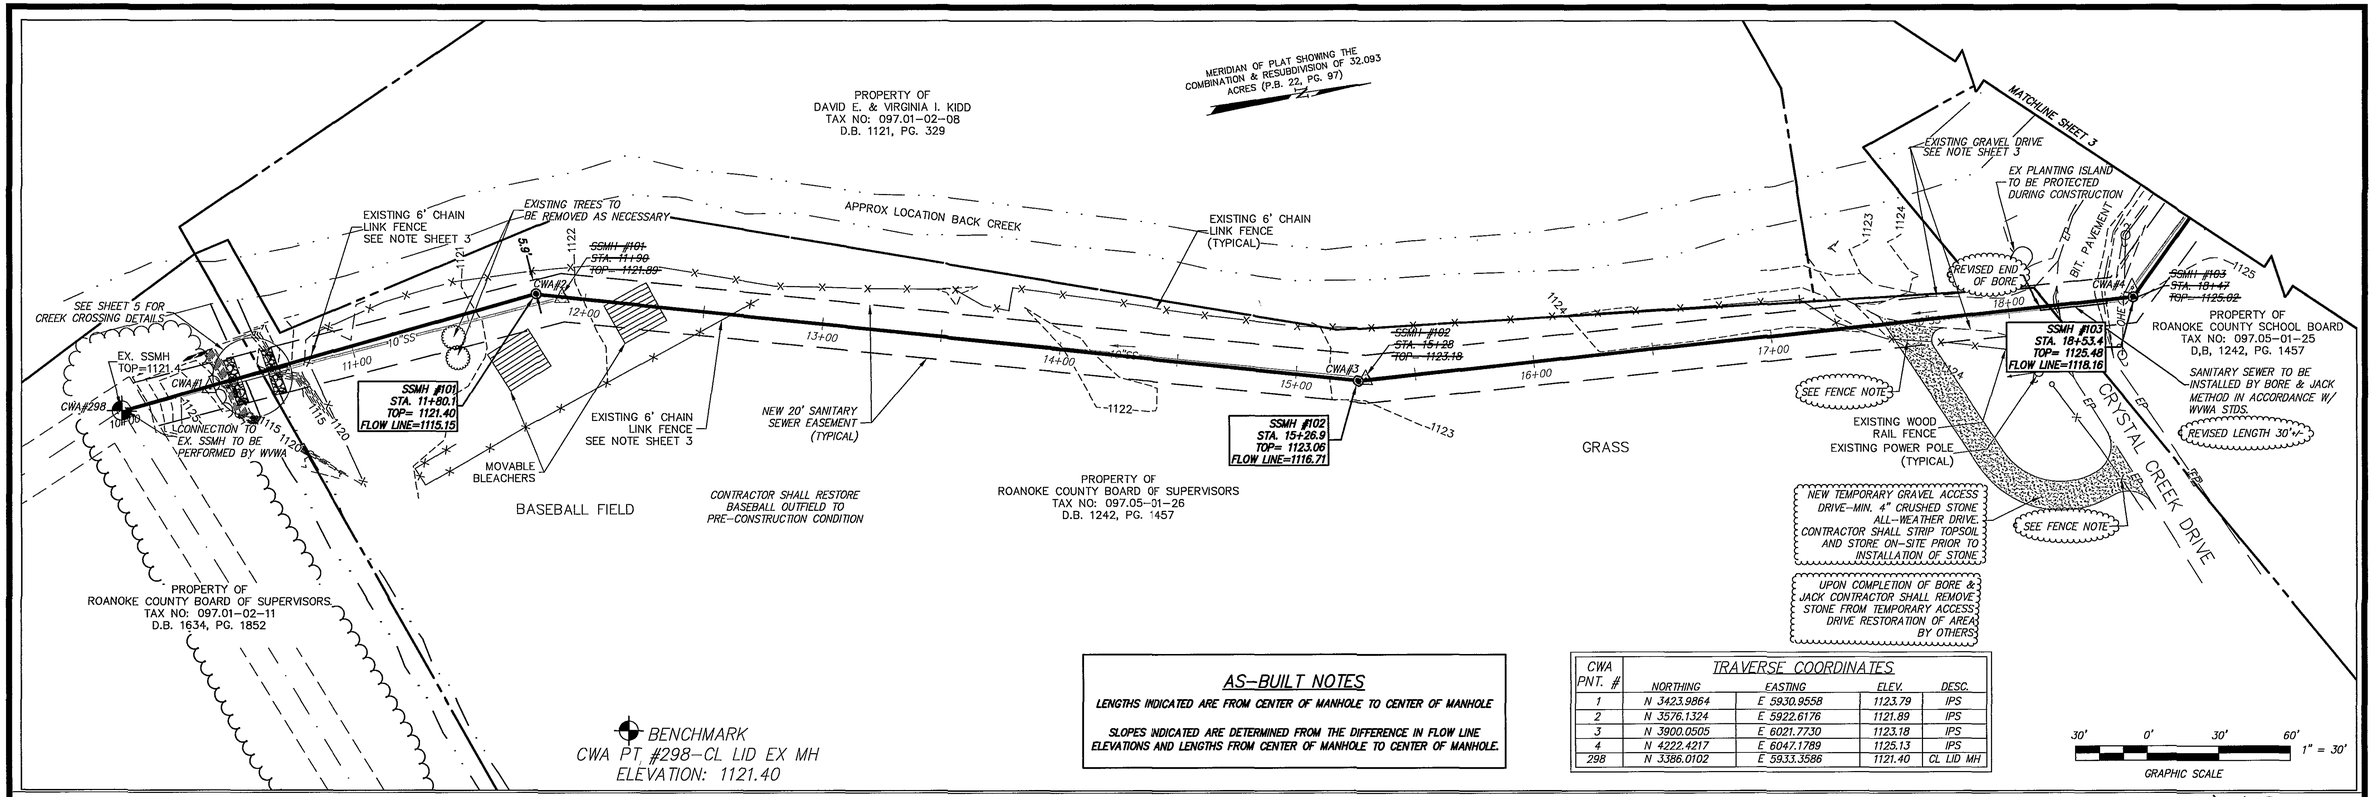

AS-BUILT NOTES

LENGTHS INDICATED ARE FROM CENTER OF MANHOLE TO CENTER OF MANHOLE

SLOPES INDICATED ARE DETERMINED FROM THE DIFFERENCE IN FLOW LINE ELEVATIONS AND LENGTHS FROM CENTER OF MANHOLE TO CENTER OF MANHOLE.

TRAVERSE COORDINATES

CWA PNT. #	NORTHING	EASTING	ELEV.	DESC.
1	N 3423.9864	E 5930.9558	1123.79	IPS
2	N 3576.1324	E 5922.6176	1121.89	IPS
3	N 3900.0505	E 6021.7730	1123.18	IPS
4	N 4222.4217	E 6047.1789	1125.13	IPS
298	N 3386.0102	E 5933.3586	1121.40	CL LID MH

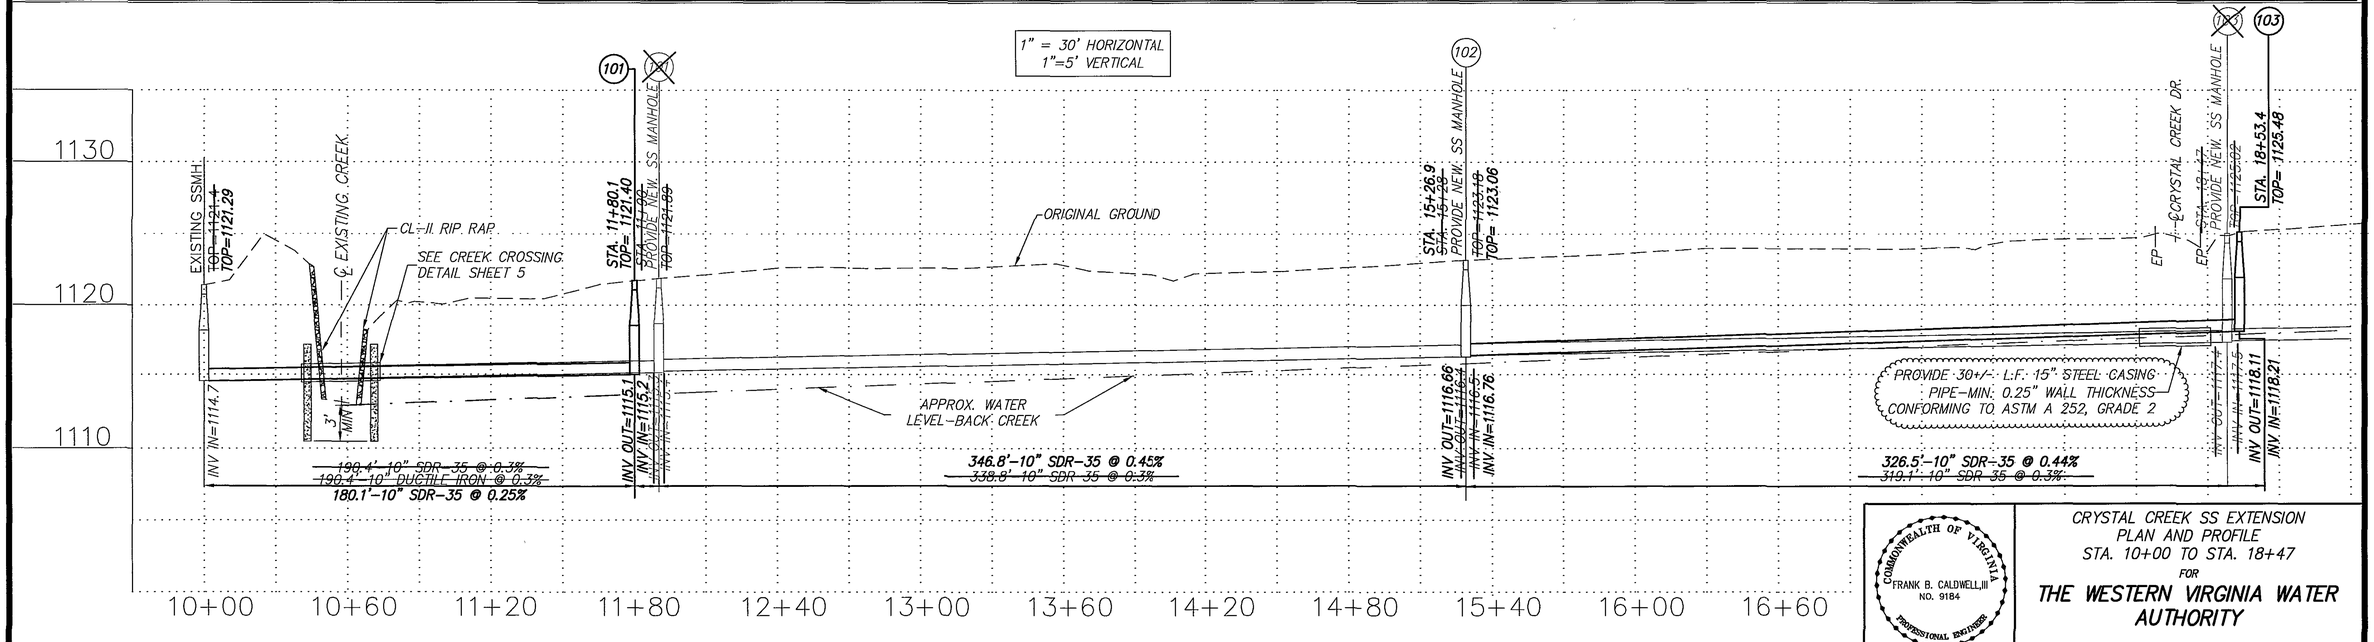

AS-BUILT CONDITIONS
JUNE 6, 2005

COMMONWEALTH OF VIRGINIA
FRANK B. CALDWELL, III
NO. 9184
PROFESSIONAL ENGINEER

CRYSTAL CREEK SS EXTENSION
PLAN AND PROFILE
STA. 10+00 TO STA. 18+47
FOR
THE WESTERN VIRGINIA WATER AUTHORITY
COUNTY OF ROANOKE, VA.

Designed: JWK
Drawn: JWK
Checked: FBC
Date: October 19, 2004
Rev: January 12, 2005
Scale: As Shown
Tax Parcel: 097.05-01-25, 26 / 097.01-02-02, 11
W.O. No.: 04-0101

CWA
CALDWELL WHITE ASSOCIATES
ENGINEERS / SURVEYORS / PLANNERS
1054 OLD COUNTRY CLUB ROAD
P.O. BOX 6340
ROANOKE, VIRGINIA 24017
(540) 342-7094
FAX: (540) 981-0699