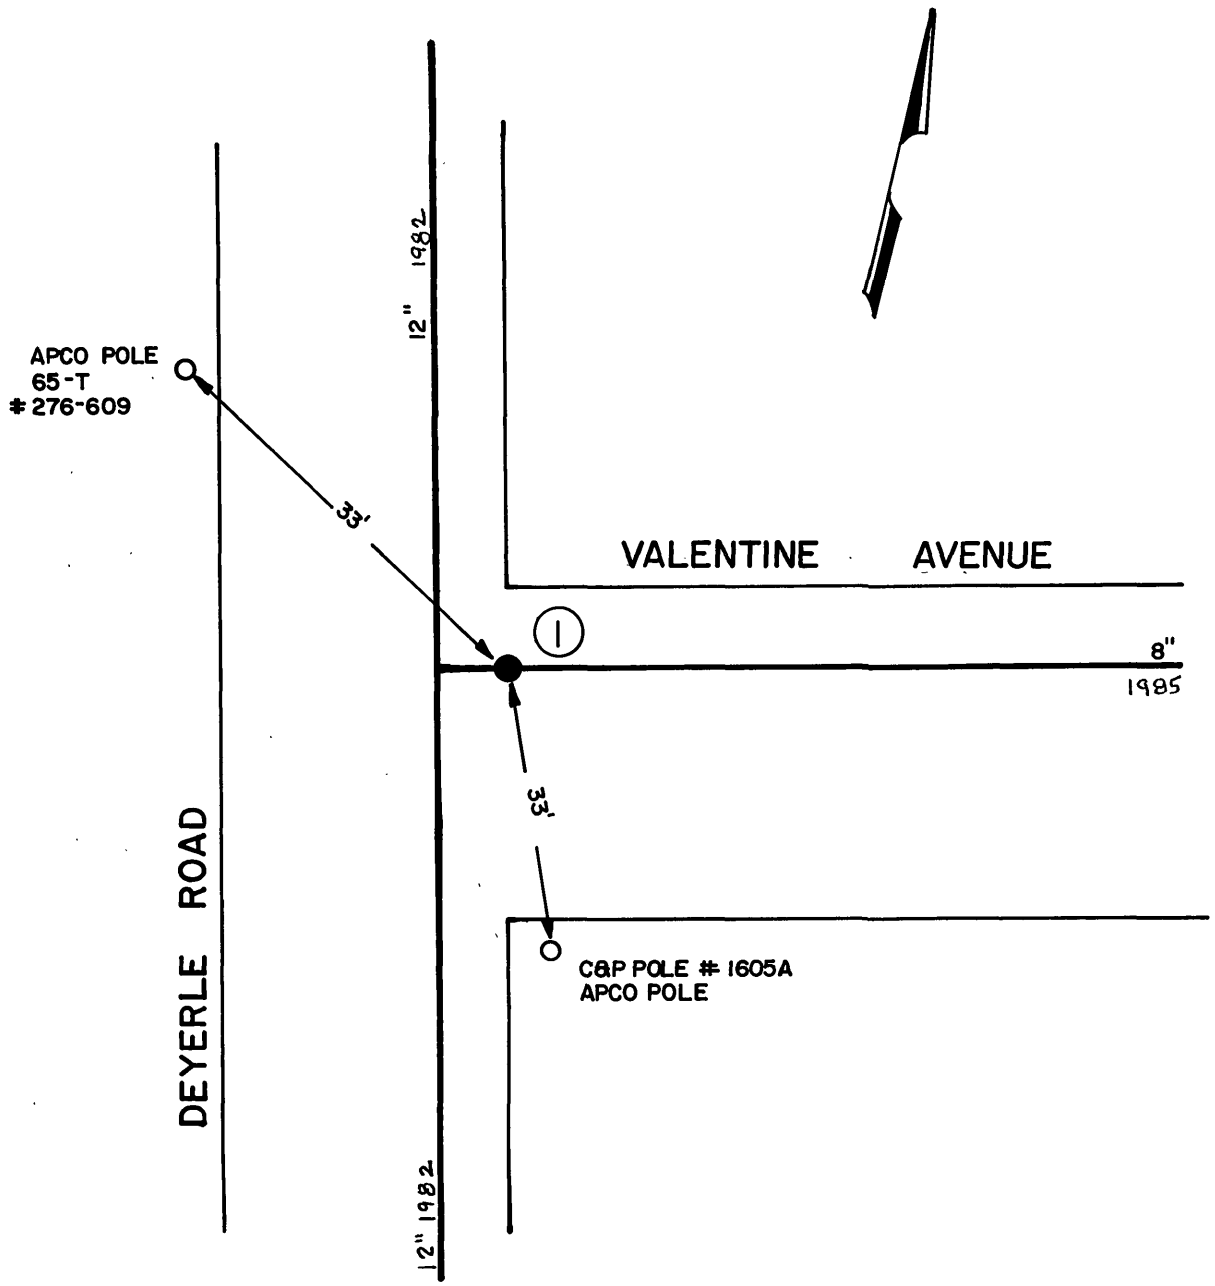

DATE	NO.	SIZE	MAKE	OPEN	TURNS
4-85	1	8"	MUELLER	R	27

CITY OF ROANOKE—WATER DEP'T

VALVE DIAGRAM

DEYERLE ROAD &

VALENTINE AVENUE

SEC. MAP 507, 518 S.W.

DATE PAGE NO.

10/91 NP