NOTES:
1. FOR EXISTING UTILITIES, SEE SHEET 7 OF 14.
2. FOR GRADING AND STORM DRAINAGE, SEE SHEET 3 OF 14.
3. SEE SHEET 14 OF 14 FOR TYPICAL STREET SECTION.

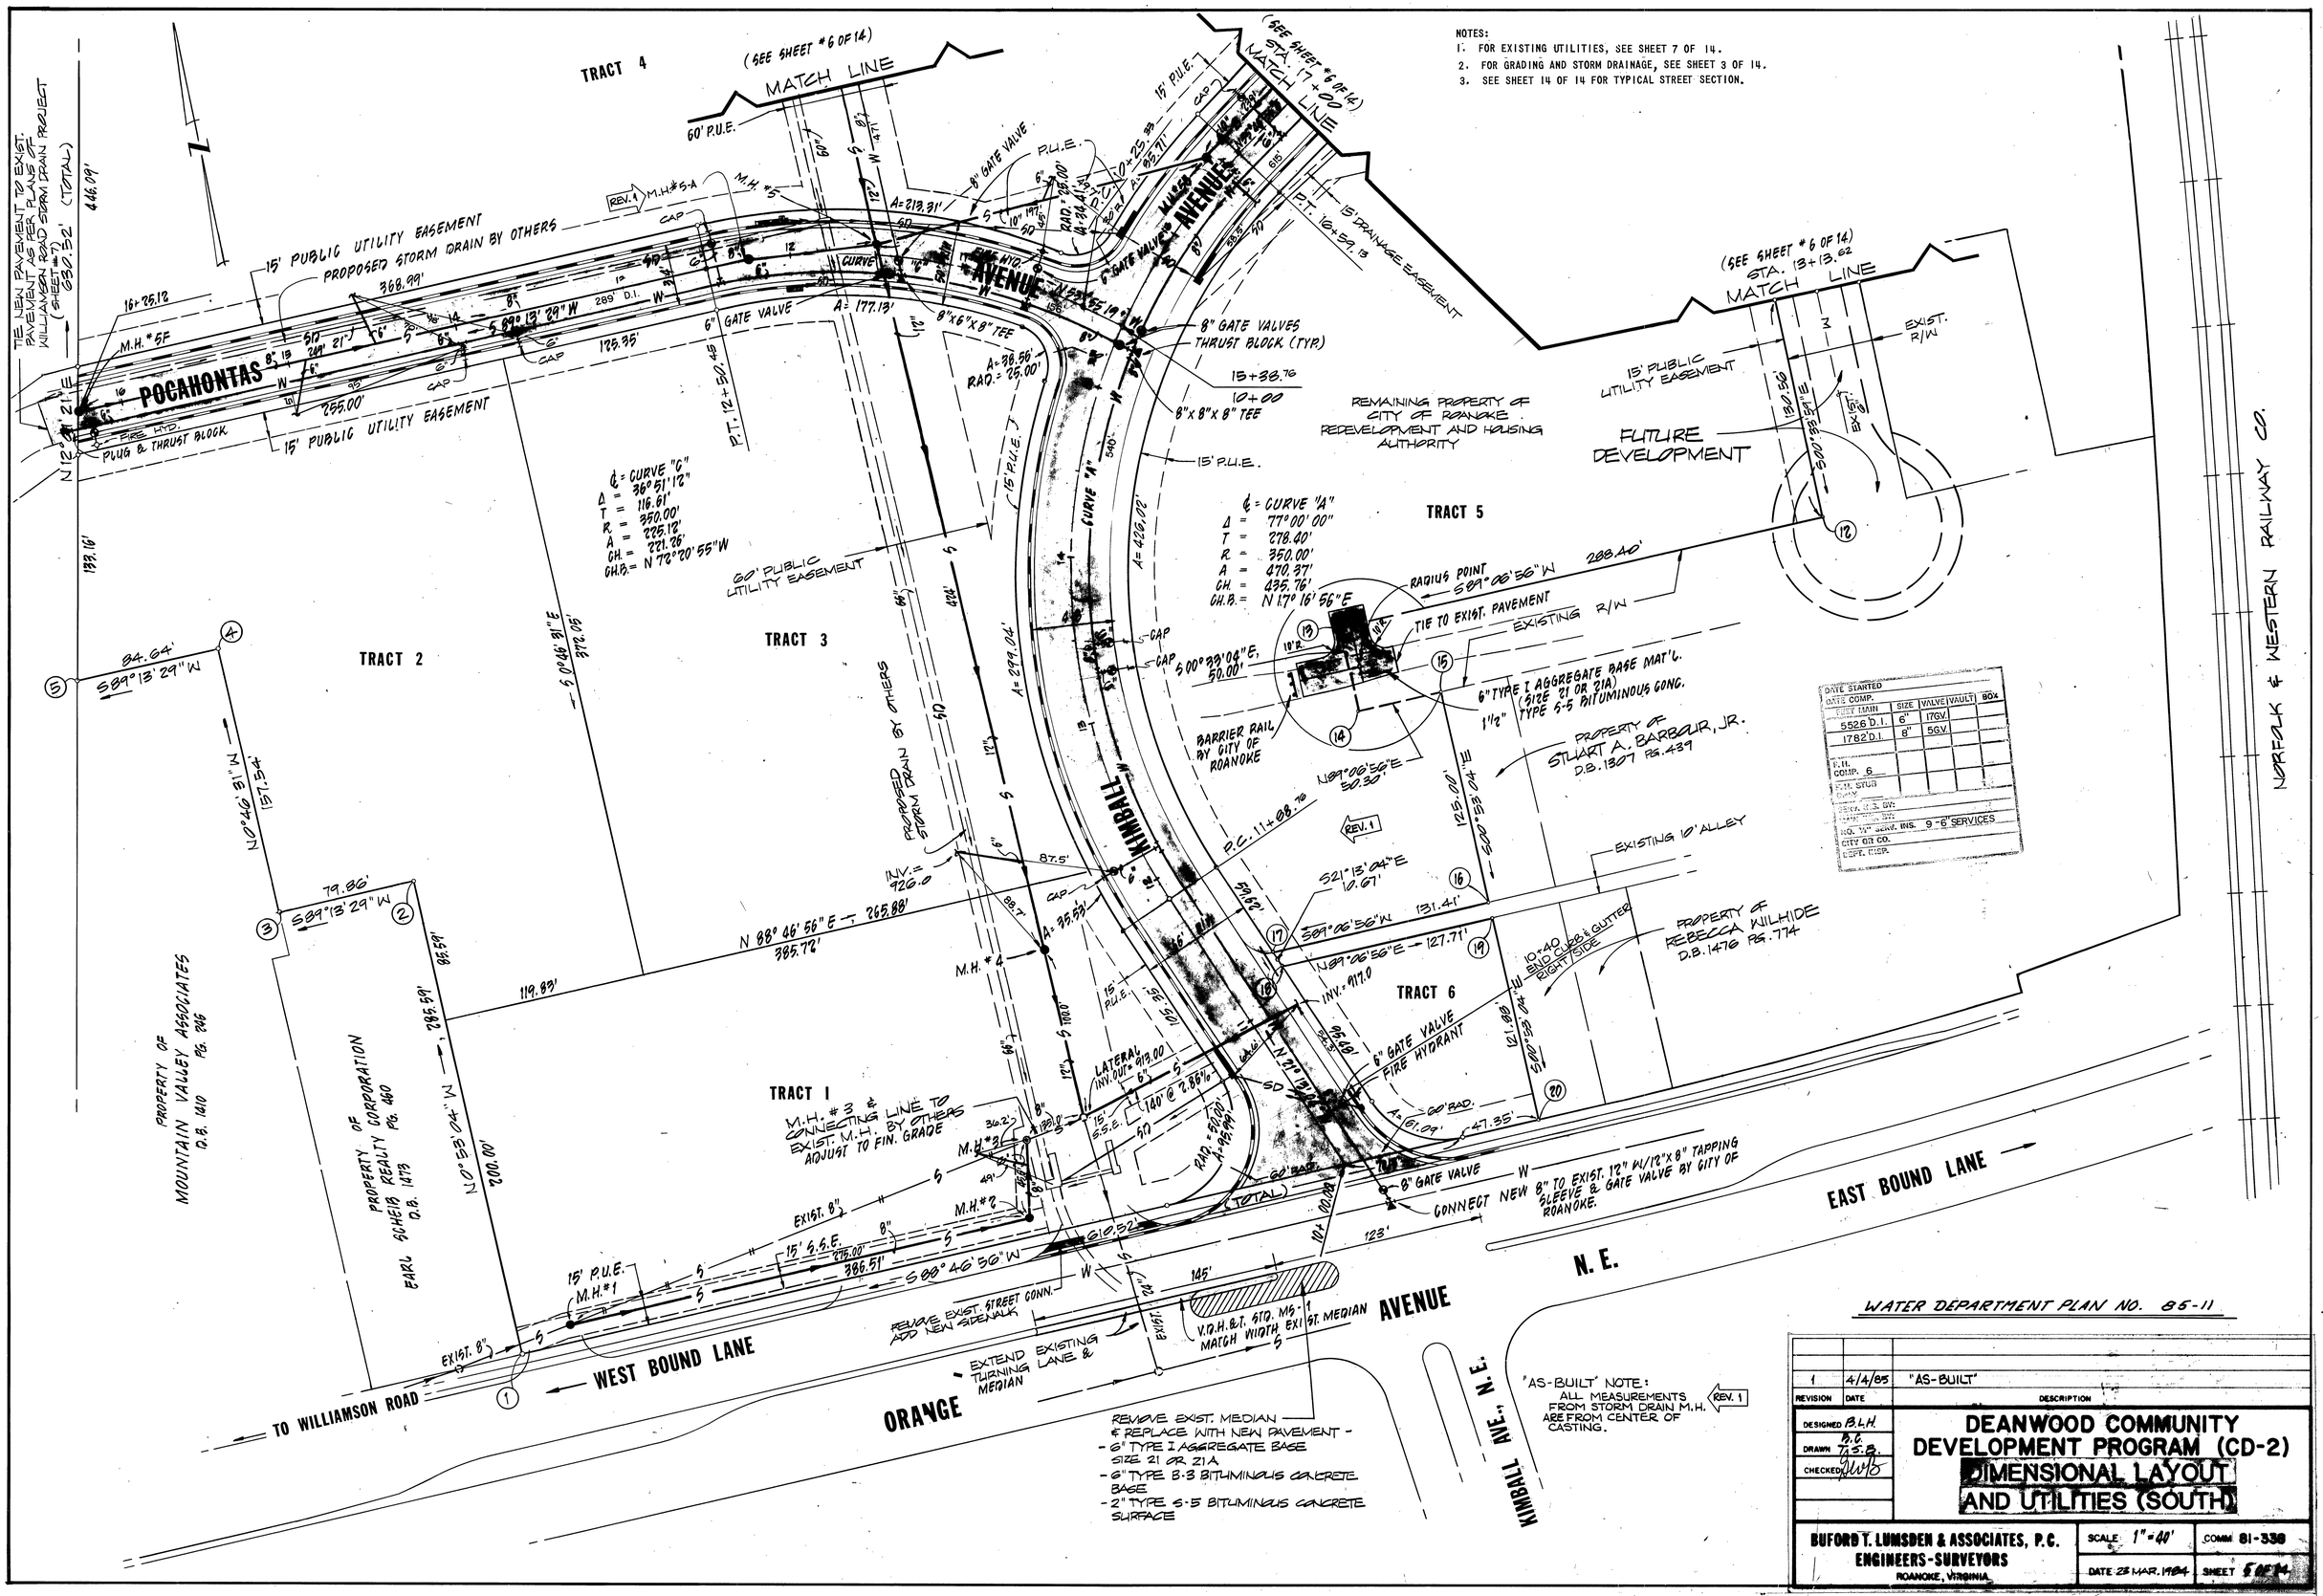

WATER DEPARTMENT PLAN NO. 85-11

REVISION	DATE	DESCRIPTION
1	4/4/85	"AS-BUILT"

DESIGNED B.L.H.
DRAWN B.C. J.S.B.
CHECKED

DEANWOOD COMMUNITY DEVELOPMENT PROGRAM (CD-2)
DIMENSIONAL LAYOUT AND UTILITIES (SOUTH)

BUFORD T. LUMSDEN & ASSOCIATES, P.C.
ENGINEERS-SURVEYORS
ROANOKE, VIRGINIA

SCALE 1"=40'
DATE 23 MAR. 1984
COMM 81-338
SHEET 5 OF 14

PLAN NO. 5507