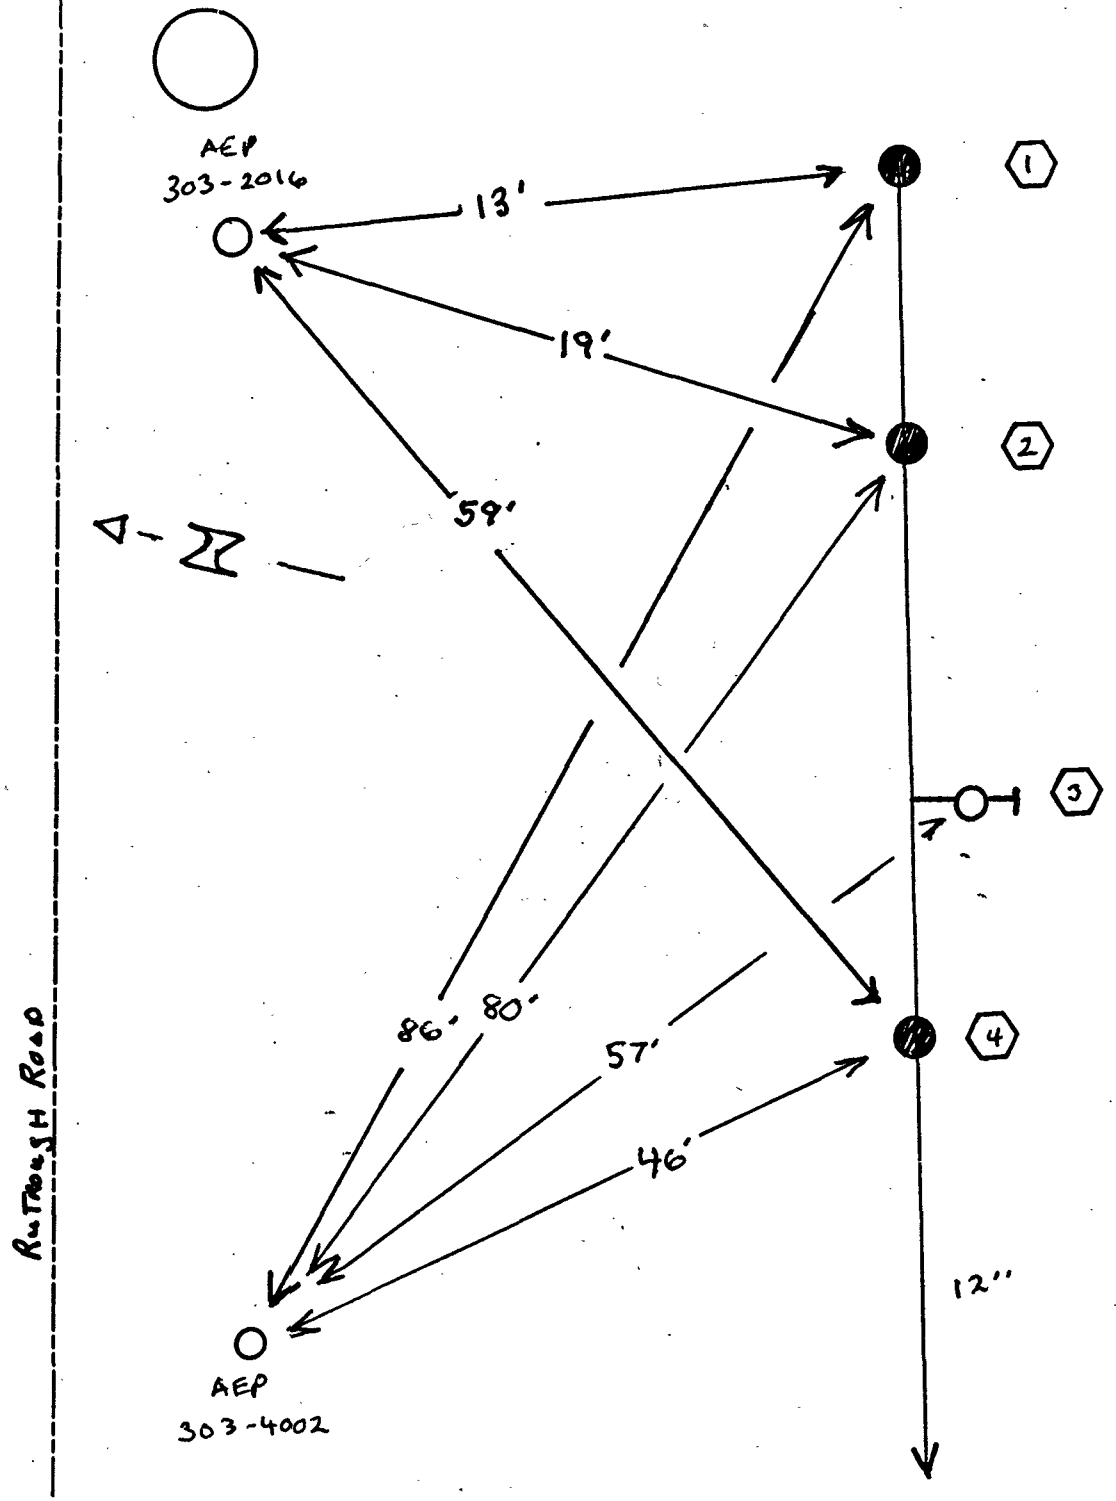

3211

DATE	NO.	SIZE	MAKE	OPEN	TURNS
8/09	1		BLOW OFF		
8/09	2	12"	AFC	L	39
8/09	3		FH STUB		
8/09	4		AIR RELEASE		

WESTERN VIRGINIA WATER AUTHORITY

VALVE DIAGRAM

3211 RUTROUGH ROAD

SECT. MAP SE. CO.

DATE 8-12-09