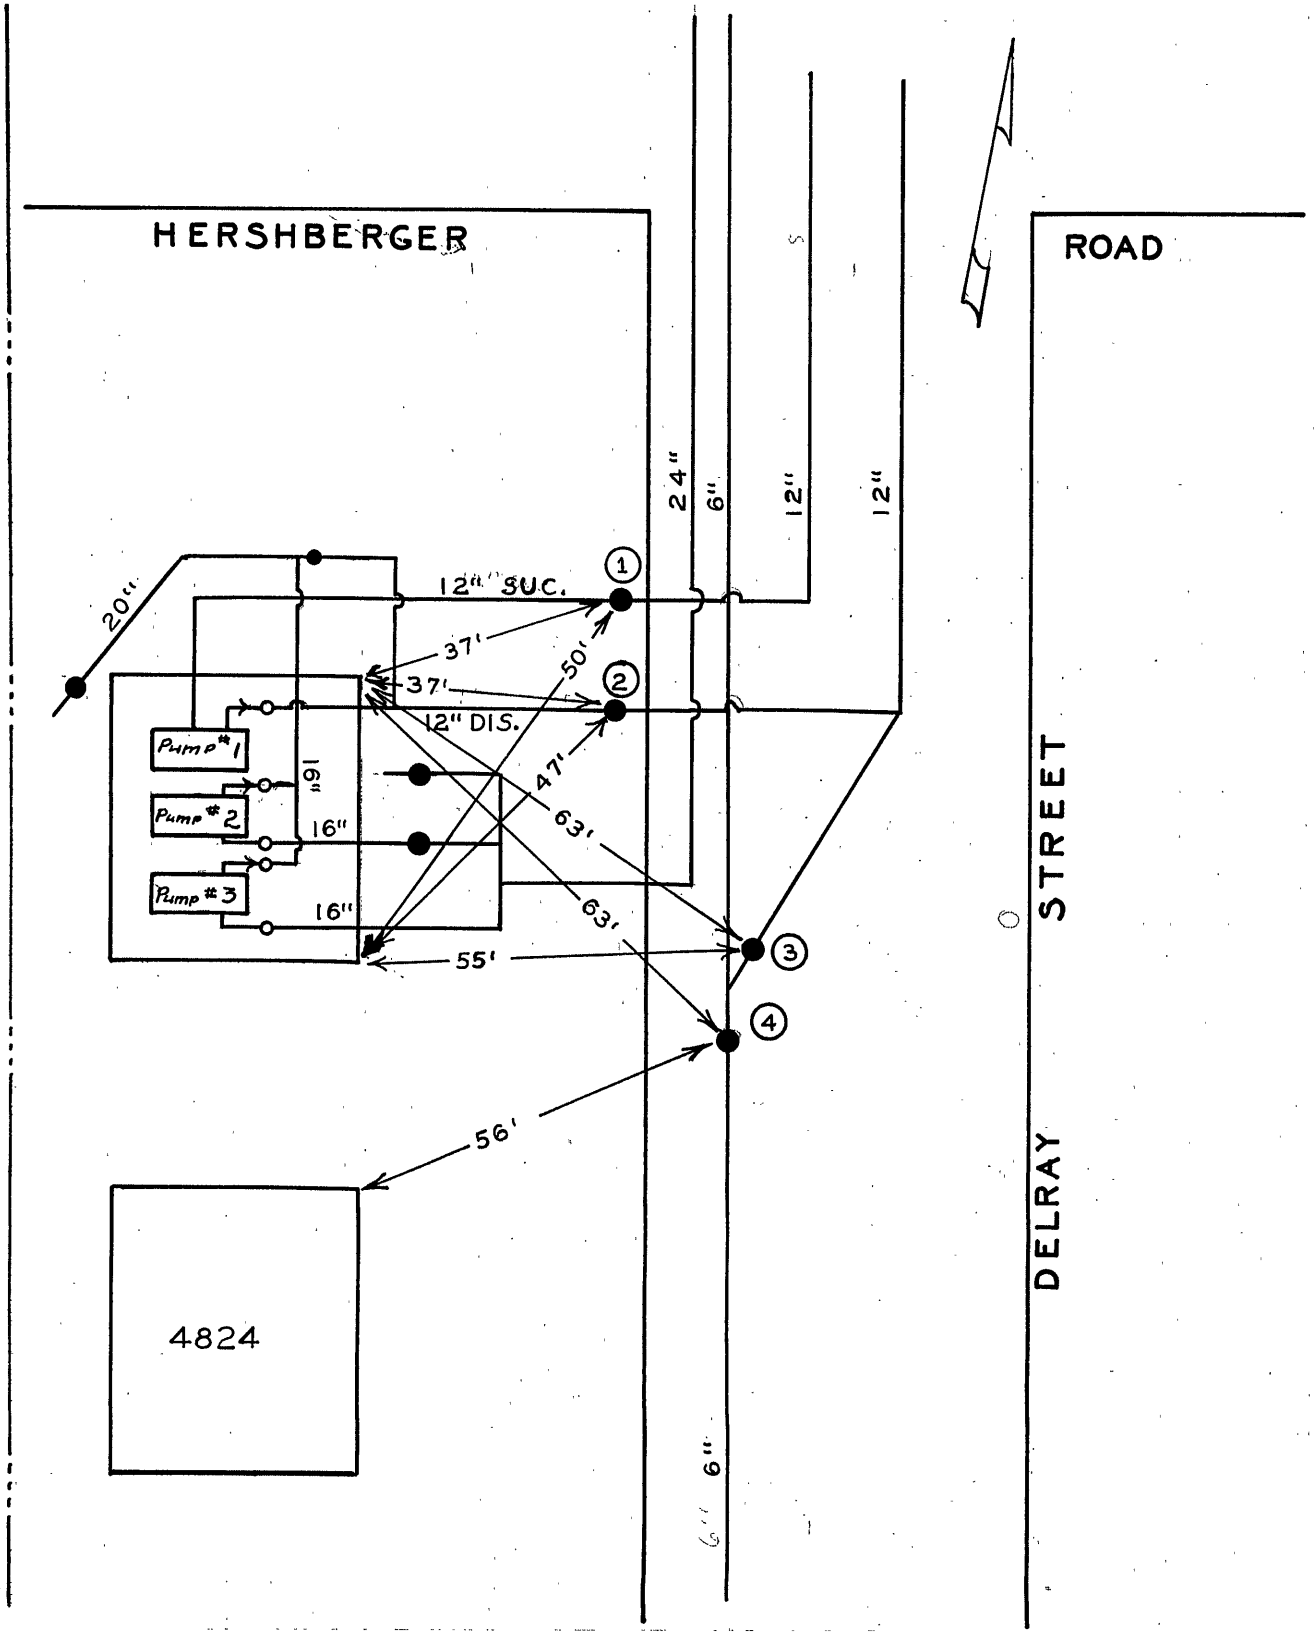

DATE	NO.	SIZE	MAKE	OPEN	TURNS
	1	12"		R	38
	2	12"		R	38
	3	6"		R	20
	4	6"		R	21

CITY OF ROANOKE—WATER DEPT.

VALVE DIAGRAM

DELRAY PUMPING

STATION N.W.

SEC. MAP 228

DATE **PAGE NO.**