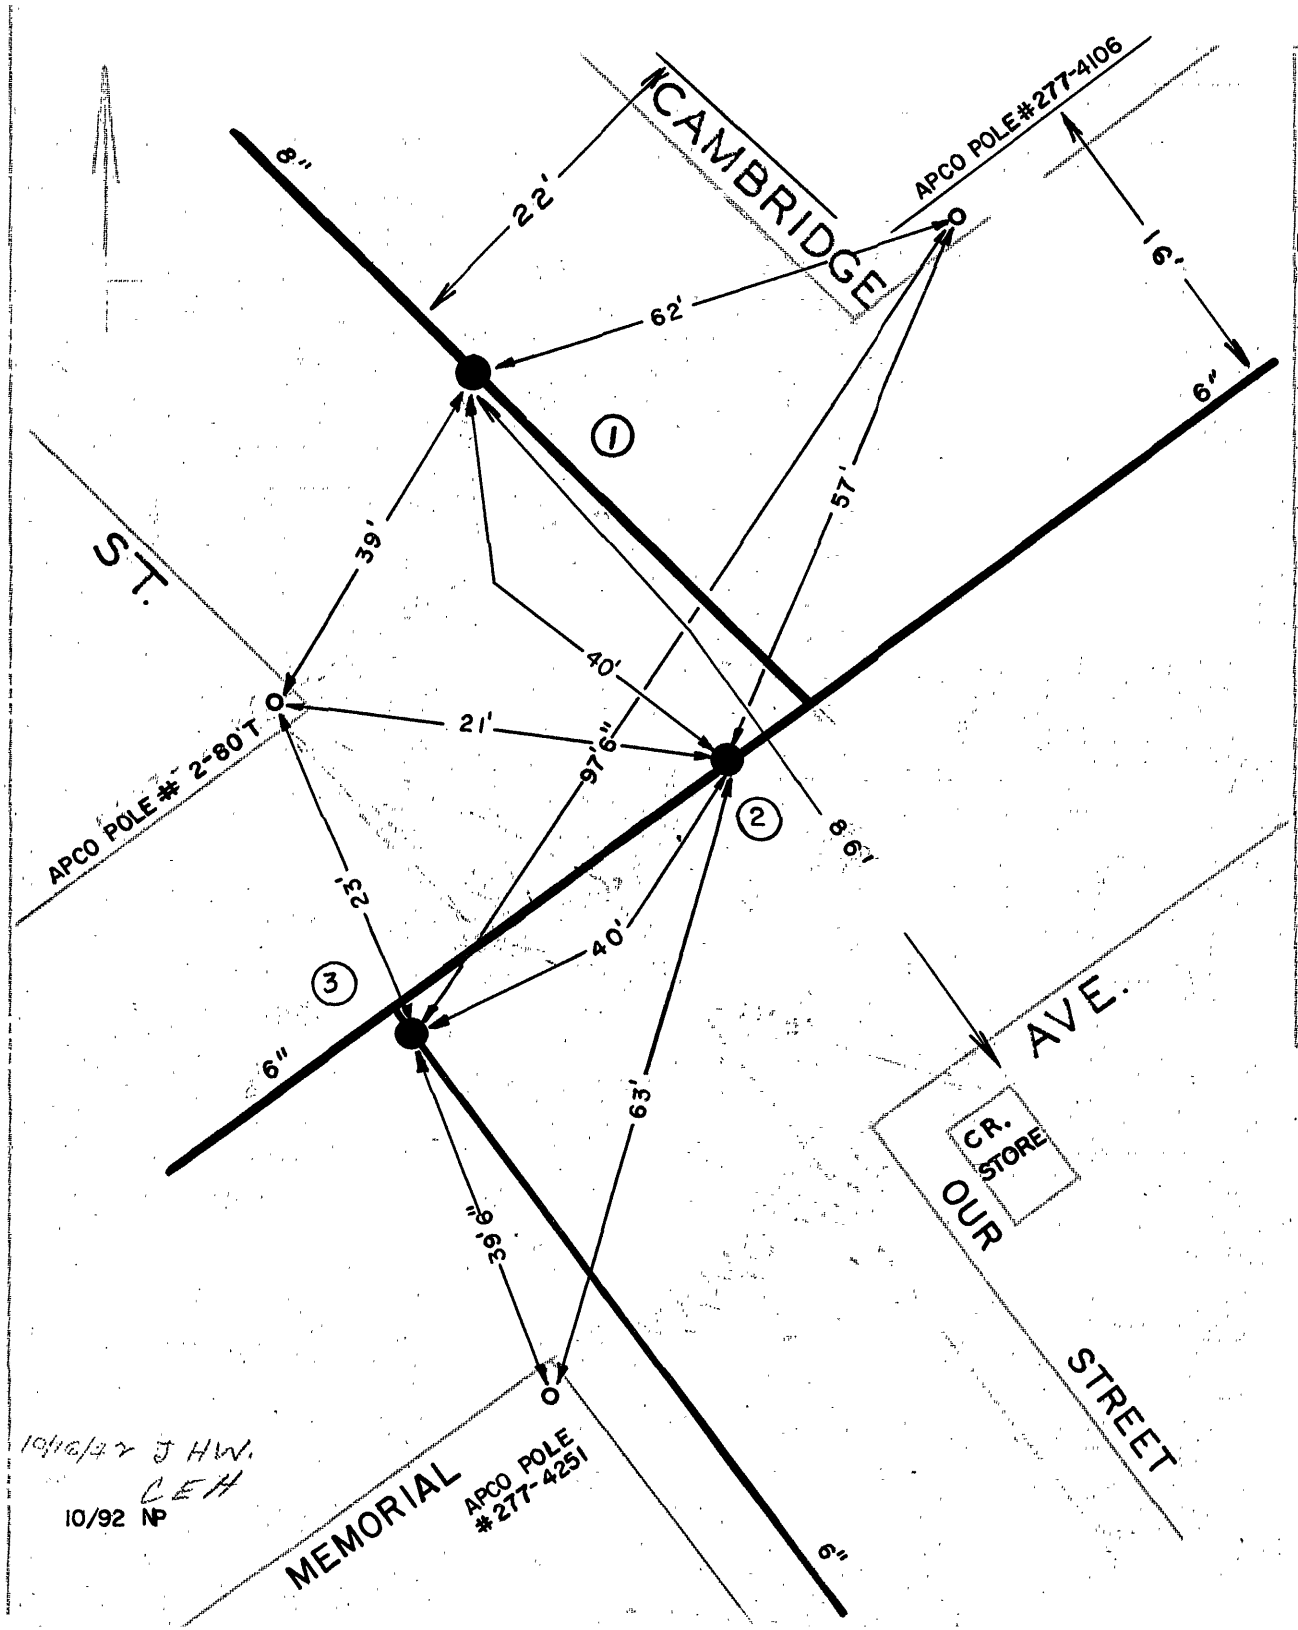

DATE	NO.	SIZE	MAKE	OPEN	TURNS
1892	1	8"		R	28
1892	2	6"		R	13
1992	3	6"	~~MUELLER~~ DARLING	R	21
	1	34'-N	NPL		
	2	16'-E	WPL		

CITY OF ROANOKE—WATER DEP'T

VALVE DIAGRAM

CAMBRIDGE ST.

MEMORIAL AVE.

OUR ST.

SEC. MAP 133 S.W.

DATE PAGE NO S.W.363