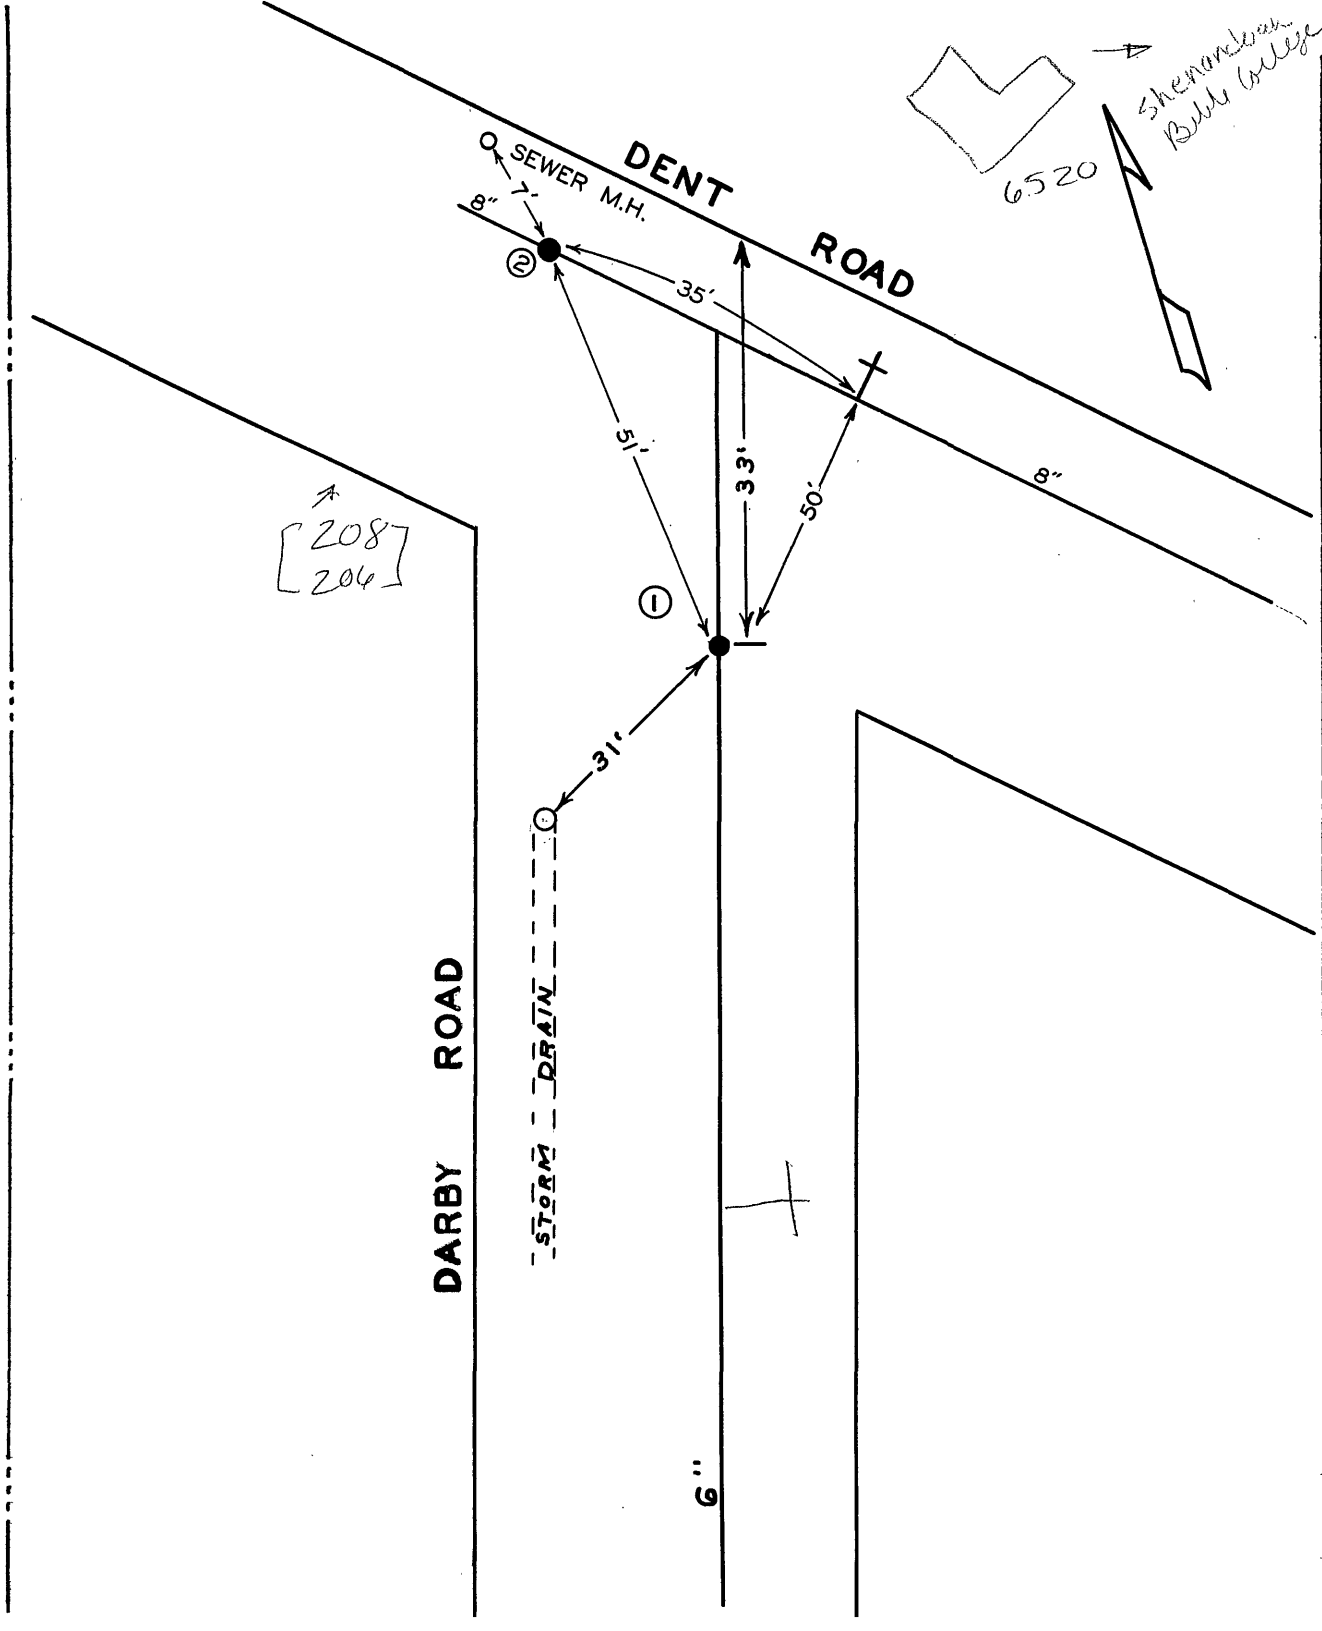

DATE	NO.	SIZE	MAKE	OPEN	TURNS
4-65	1	6"	MUELLER	R	
73	2	8"	MUELLER	R	
	1	0	S.P.L.		

CITY OF ROANOKE—WATER DEPT.

VALVE DIAGRAM

DARBY ROAD & DENT ROAD N.W.

SEC. MAP 2

DATE PAGE NO.