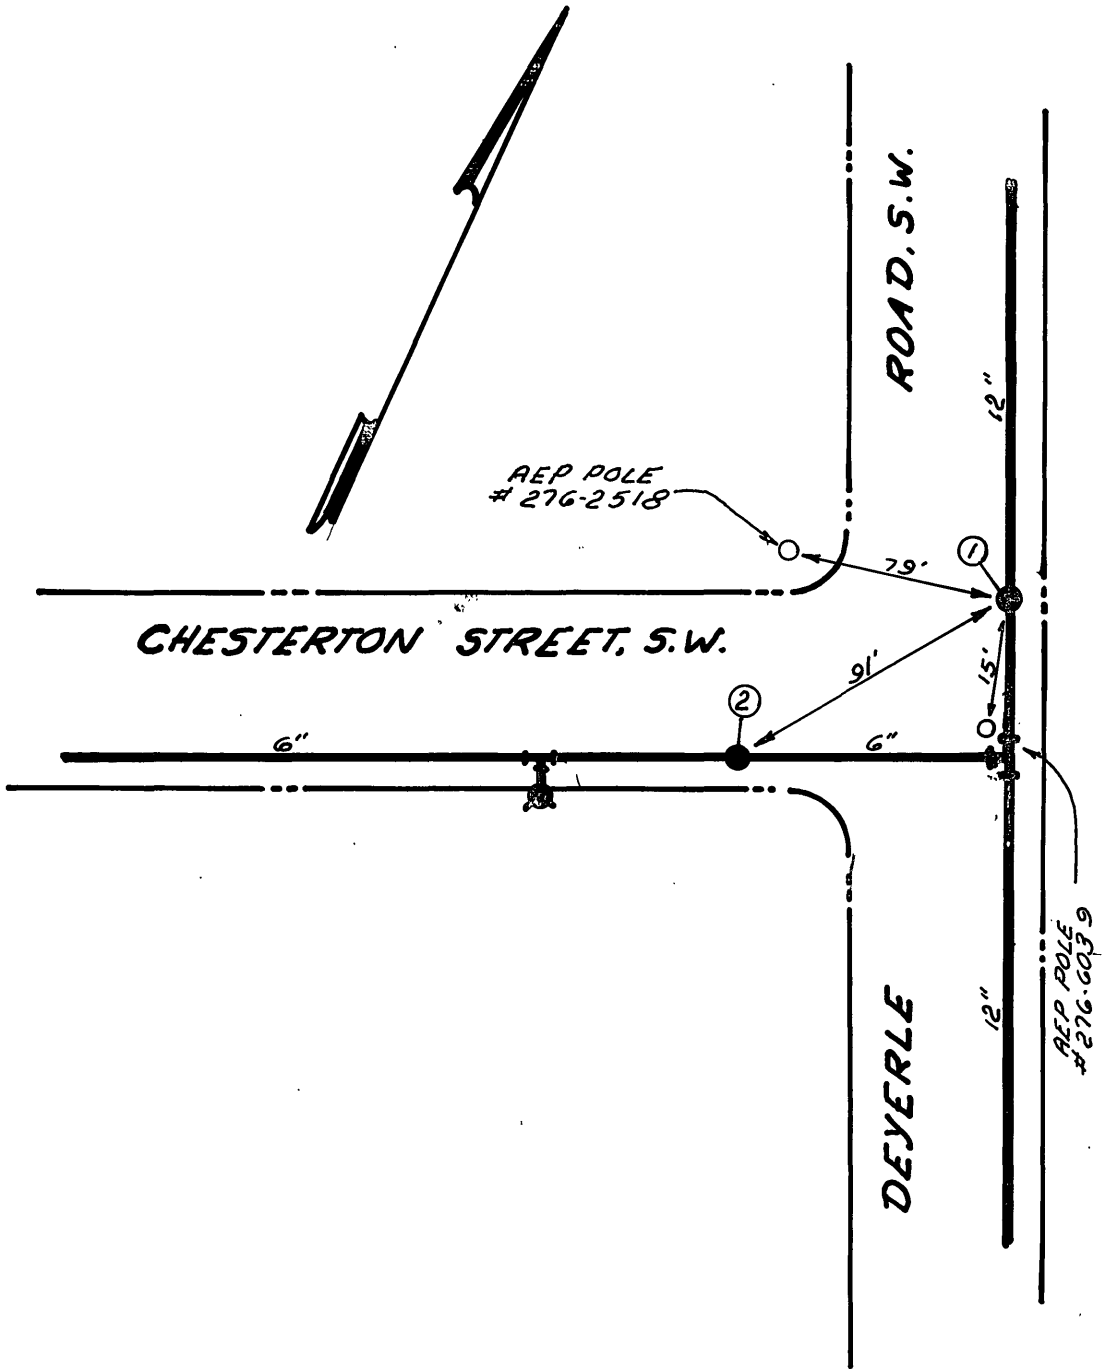


| DATE | NO. | SIZE | MAKE | OPEN | TURNS |
|---|---|---|---|---|---|
| 6/82 | 1 | 12" | KENEDY | R | 39 |
| 6/82 | 2 | 6" | MUL. | L | 21 |
| | | | | | |
| | | | | | |
CITY OF ROANOKE—WATER DEP'T

VALVE DIAGRAM

CHESTERTON STREET

& DEYERLE ROAD

S. W.

SEC. MAP 507

DATE 6-24-85 PAGE NO. 1