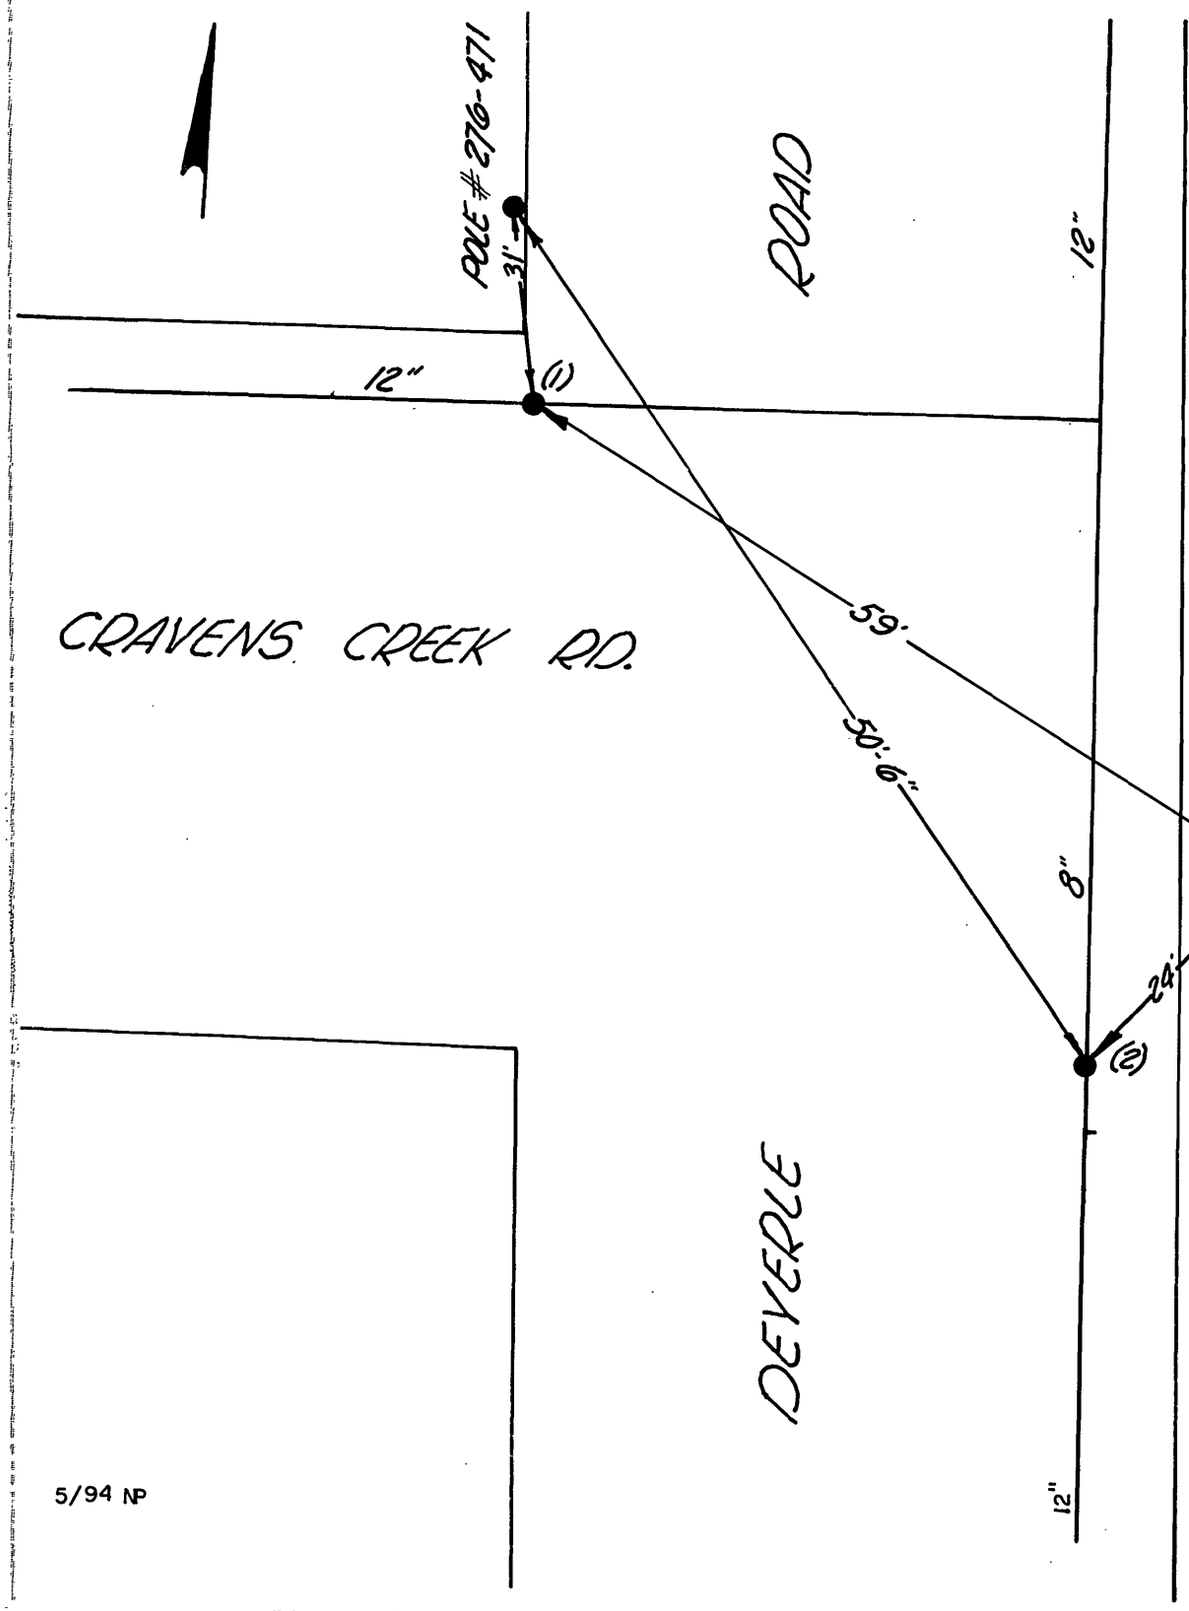

DATE	NO.	SIZE	MAKE	OPEN	TURNS
12-76	1	12"	MUELLER	R	
12-76	2	8"	MUELLER	R	

CITY OF ROANOKE—WATER DEPT

VALVE DIAGRAM

CRAVENS CREEK Rd. & DEVERLE Rd. S.W.

SEC. NO. 518

DATE PAGE NO.

5/94 NP