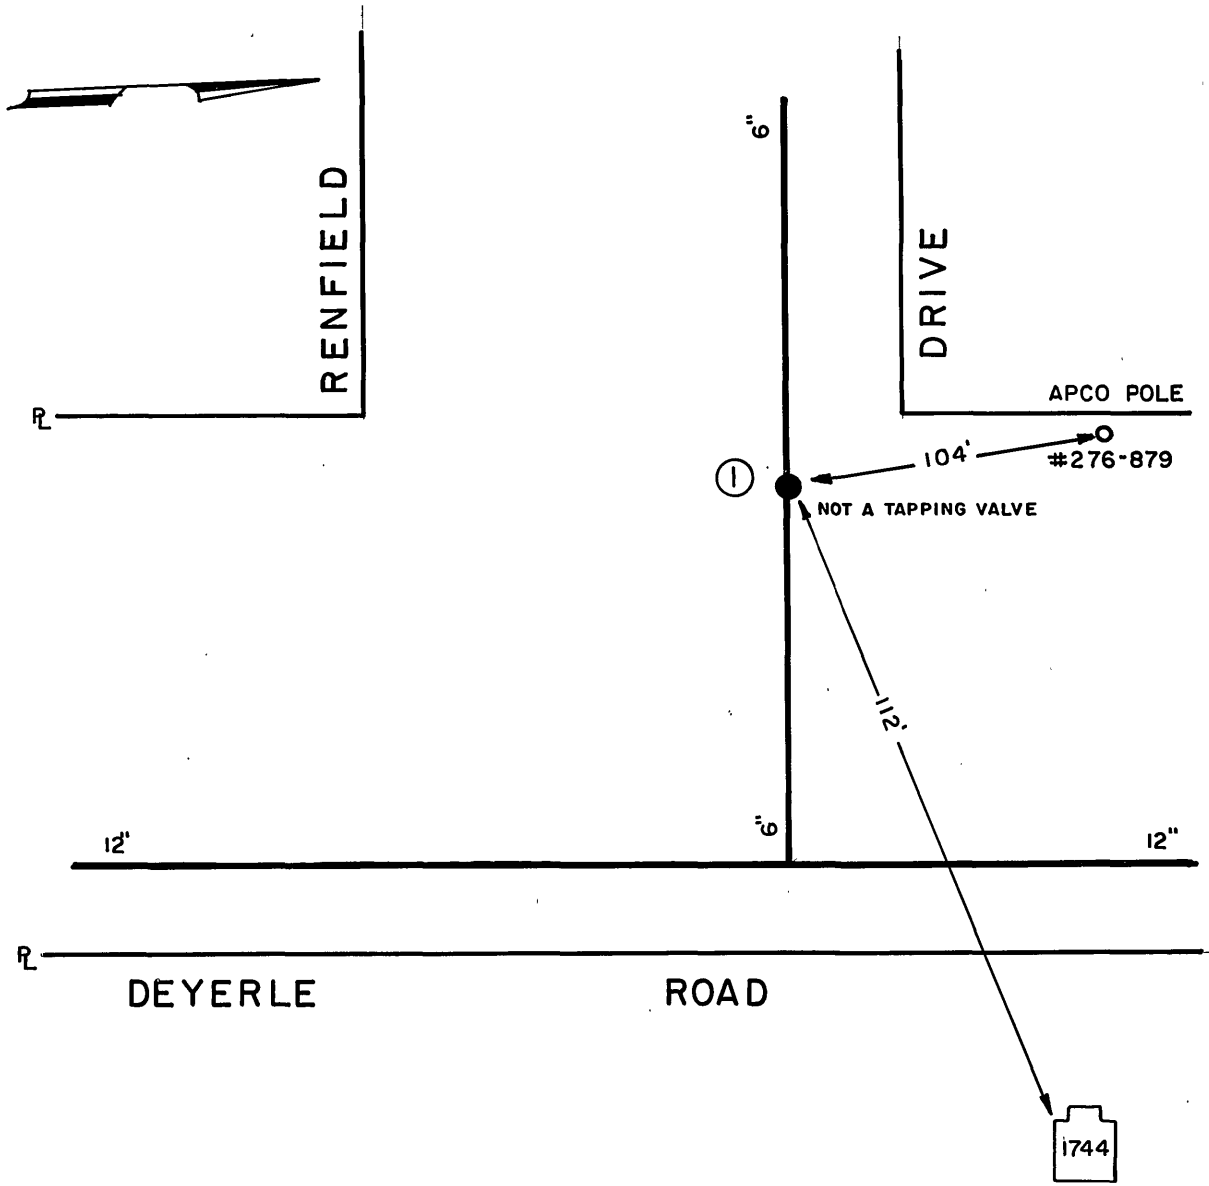

DATE	NO.	SIZE	MAKE	OPEN	TURNS
5-90	1	6"	MUELLER	R	21

CITY OF ROANOKE - WATER DEP'T.
VALVE DIAGRAM
DEYERLE ROAD (1700 BLK.)
RENFIELD DRIVE
SEC. MAP 507 S.W
DATE: PAGE NO.

11/91 NP