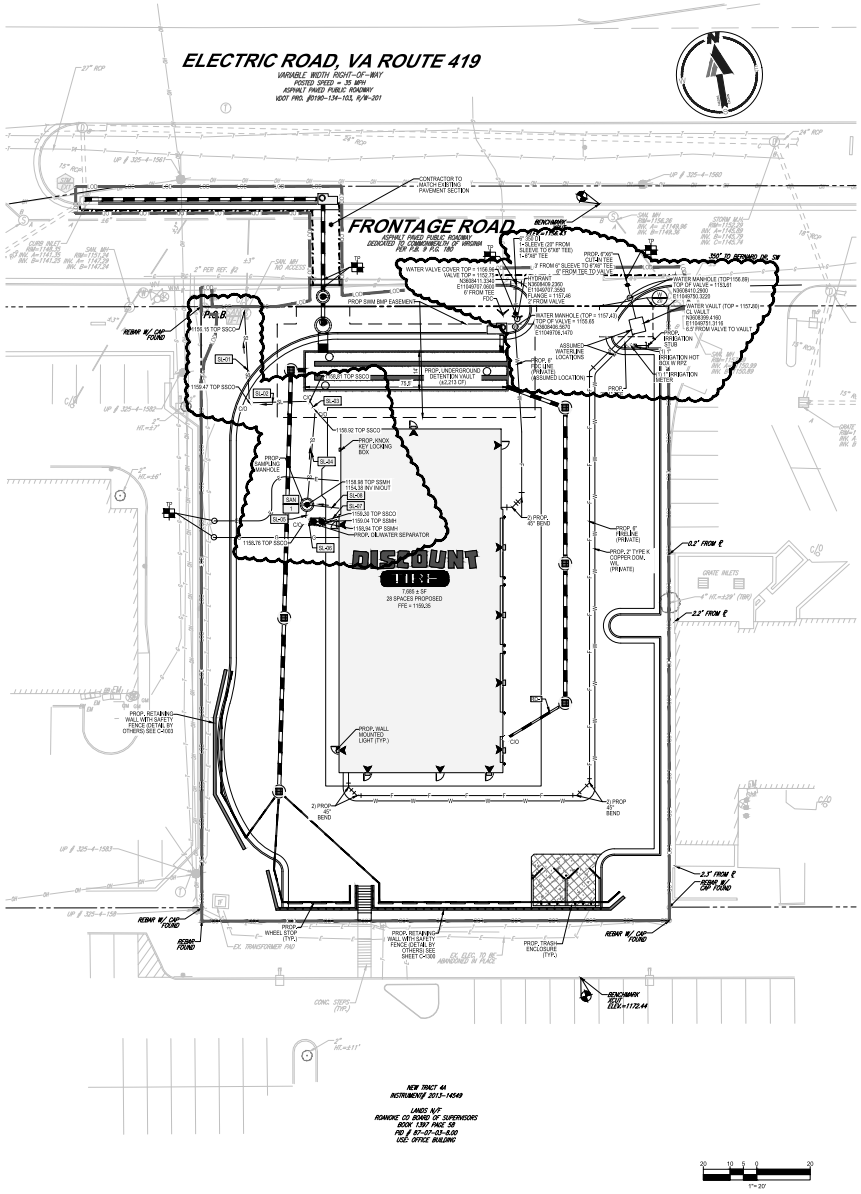

AS-BUILT NOTE:

AS-BUILT DRAWING FOR WATER AND SANITARY SEWER IMPROVEMENTS ARE FOR AS-UTILITY PURPOSES ONLY. NO IMPROVEMENTS OTHER THAN WATER AND SANITARY SEWER STRUCTURES WERE AS-BUILT OR INDICATED AS SUCH ON THE SUBJECT PLAN SET. CLEANOUT INVERTS AND UNDERGROUND PIPING WERE NOT LOCATED. LOCATION SHOWN IS APPROXIMATE BASED ON SURFACE FEATURES AND INFORMATION PROVIDED BY CONTRACTOR.

ROOF DRAIN SCHEDULE

Pipe	Invert Elev. Upper (ft)	Invert Elev. Lower (ft)	Length (ft)	Slope (%)	Dia. (in)	Material
RD-1	1156.93	1156.40	25.70	2.06%	8	PVC

SANITARY LATERAL SCHEDULE

Pipe	Invert Elev. Upper (ft)	Invert Elev. Lower (ft)	Length (ft)	Slope (%)	Dia. (in)	Material
SL-07	1155.35	1155.20	5.20	1.24%	6	PVC
CWS	1155.30	1155.20	N/A	N/A	N/A	N/A
SL-06	1155.30	1155.28	2.20	1.24%	6	PVC
SL-05	1155.28	1154.28	6.17	14.54%	6	PVC
SL-06	1155.35	1154.38	12.50	7.76%	6	PVC
SL-04	1154.38	1152.12	36.67	6.16%	6	PVC
SL-03	1152.12	1152.09	3.00	1.24%	6	PVC
SL-02	1152.09	1151.90	15.17	1.24%	6	PVC
SL-01	1151.90	1151.84	34.23	1.24%	6	PVC

BOHLER ENGINEERING

SITE CIVIL AND CONSULTING ENGINEERING
LAND DEVELOPMENT
PROGRAM MANAGEMENT
LANDSCAPE ARCHITECTURE
ENVIRONMENTAL SERVICES
PERMITTING SERVICES
TRANSPORTATION SERVICES

THIS DRAWING IS PROPRIETARY TO BOHLER ENGINEERING AND MAY NOT BE REPRODUCED OR TRANSFERRED WITHOUT WRITTEN PERMISSION.

REVISIONS

REV	DATE	COMMENT	APPROVED

THE SIGNING OF THIS DRAWING DOES NOT IMPLY THE GRANTING OF ZONING, SITE PLAN AND/OR OTHER LOCAL GOVERNMENT APPROVALS. IT IS NOT INTENDED TO BE A CONSTRUCTION DOCUMENT UNTIL IT BEARS THE APPROVAL STAMP.

811 Know what's below. Call before you dig.
ALWAYS CALL 811
It's fast, It's free, It's the law.

APPROVED FOR CONSTRUCTION

PROJECT No.: V192122
DRAWN BY: PCM
CHECKED BY: RTY
DATE: 12/19/22
CAD I.D.: UTP-0

PROJECT:
ENGINEERING AS-BUILT PLAN
FOR
DISCOUNT TIRE

LOCATION OF SITE
3843 ELECTRIC ROAD
CAVE SPRING
MAGISTERIAL DISTRICT
ROANOKE COUNTY, VIRGINIA

BOHLER ENGINEERING
28 BLACKWELL PARK LANE, SUITE 201
WARRENTON, VIRGINIA 20186
Phone: (540) 349-4500
Fax: (540) 349-0321
VA@BohlerEng.com

COMMONWEALTH OF VIRGINIA
RYAN YAUCKER
Lic. No. 0402056625
12/19/2022
PROFESSIONAL ENGINEER

SHEET TITLE:
AS-BUILT UTILITY PLAN

SHEET NUMBER:
C-500

REVISION 0 - 12/19/22