DOVER DRIVE/KIPLING STREET
WATERLINE REPLACEMENT
ROANOKE, VIRGINIA
COMM. NO. 3770

Materials -

	U.S. Pipe		6" DIP CL350
Main - 8" DIP CL350 / 12" DIP CL350			
Services: 1" - Polyflex Endot			
Valves:	6" AFC	8" AFC	12" AFC
	18 Turns Right to Off	24 Turns Right to Off	36 Turns Right to Off
Inspector: Brian Whiteneck			
Contractor: Wells Construction			
PM: David Burnhart			
As-built 4/3/2020			

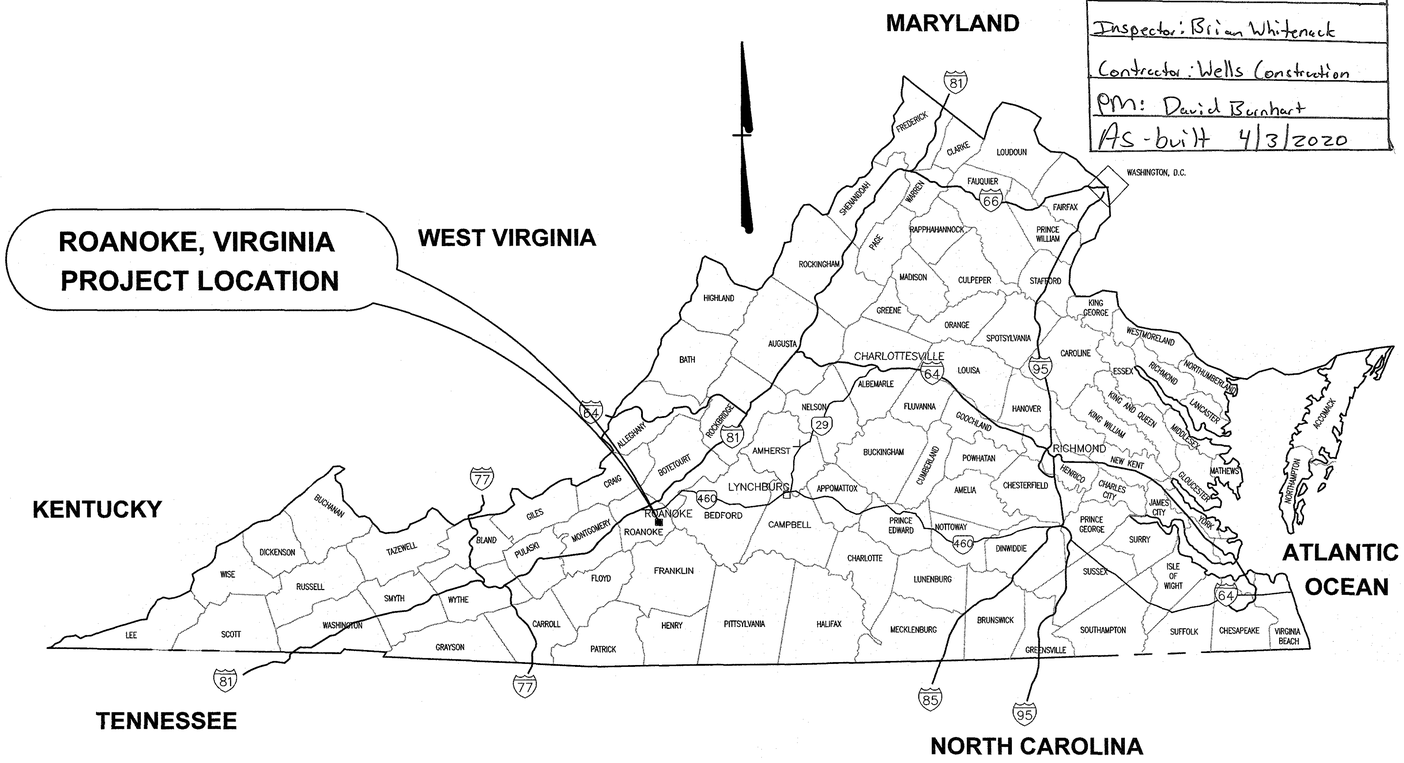

SHEET LIST

1 TITLE SHEET
2 ABBREVIATIONS AND LEGEND
3 SHEET INDEX AND GENERAL NOTES
4 PLAN AND PROFILE
5 PLAN AND PROFILE
6 PLAN AND PROFILE
7 PLAN AND PROFILE
8 DETAILS
9 DETAILS
10 FIRE HYDRANT COVERAGE EXHIBIT
11 MAINTENANCE OF TRAFFIC PLAN

PREPARED FOR:

WESTERN VIRGINIA WATER AUTHORITY

APPROVED FOR CONSTRUCTION

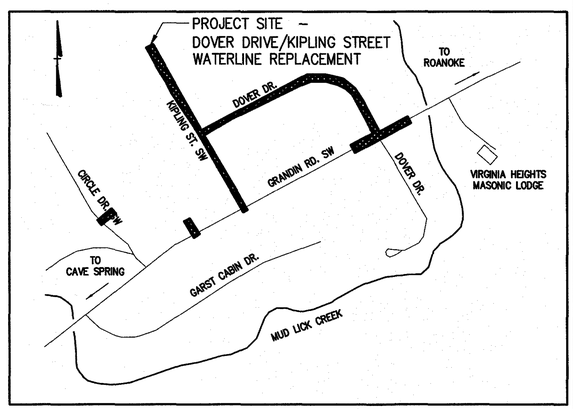

LOCATION MAP
NOT TO SCALE

COMMONWEALTH OF VIRGINIA
BRADLEY C. CRAIG
Lic. No. 023879
PROFESSIONAL ENGINEER
02/28/19

Revisions	Date

Issue Date: 02/28/19
Drawn By: DBL
Designed By: DBL
Checked By: BCC
Date: 02/22/19

Mattern & Craig
ENGINEERS•SURVEYORS
701 FIRST STREET, S.W.
ROANOKE, VIRGINIA 24011
(540) 345-9342
FAX (540) 345-7891

DOVER DR./KIPLING ST. WATERLINE REPLACEMENT

TITLE SHEET

ROANOKE, VIRGINIA

Vertical Scale:

Horizontal Scale:

Commission Number: 3770

Sheet No.: 1