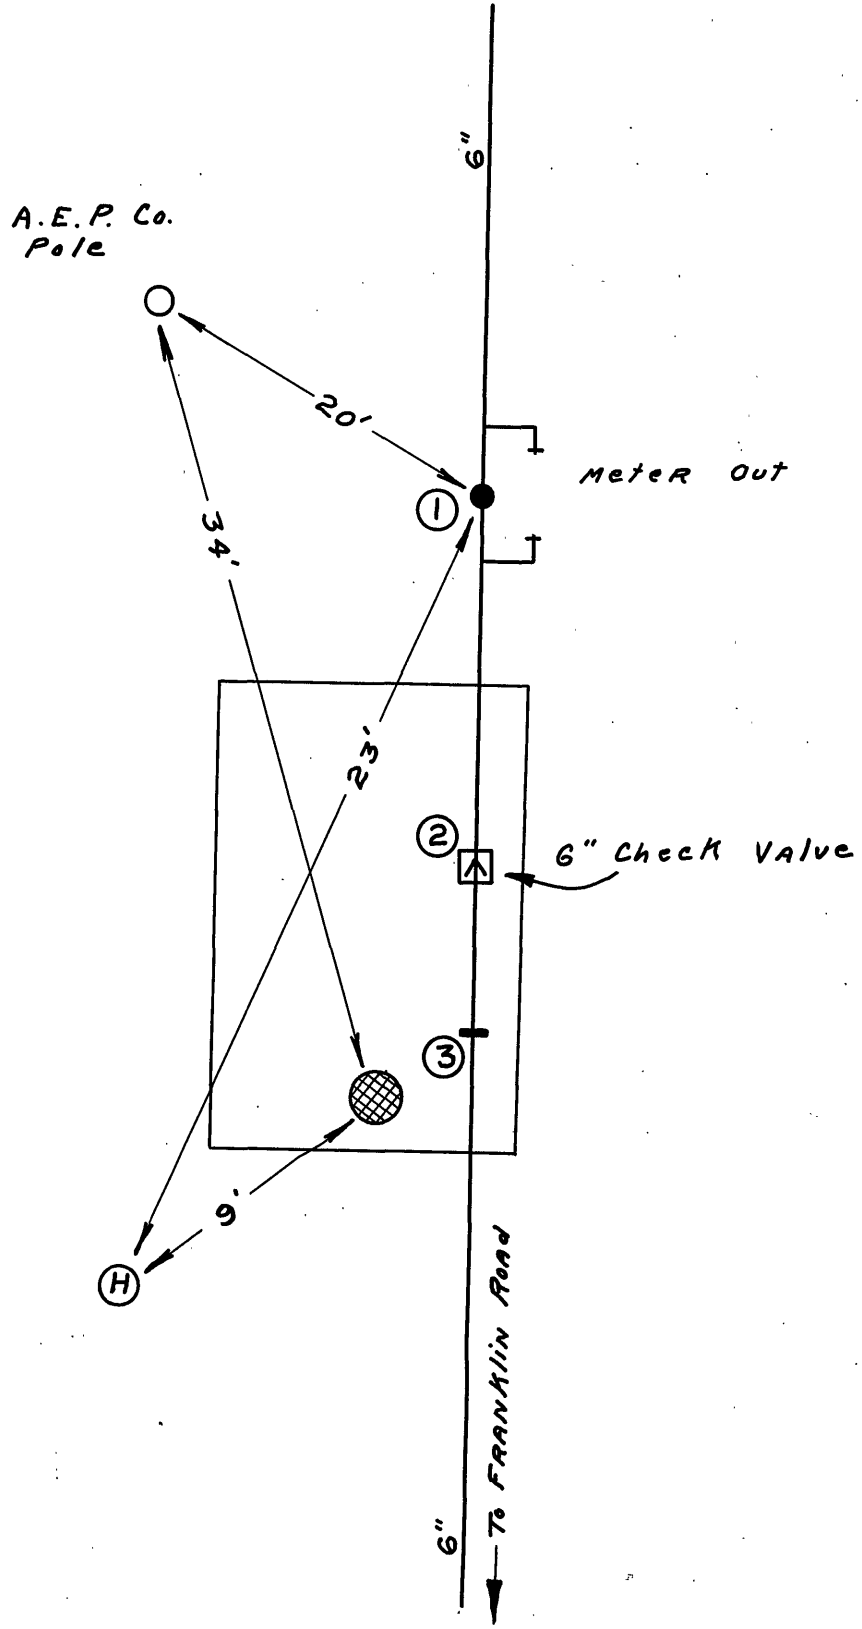


| DATE | NO. | SIZE | MAKE | OPEN | TURNS |
|---|---|---|---|---|---|
| | 1 | 6" | | R | |
| | 2 | 6" | CHECK VALVE | | |
| | 3 | 6" | | R | |
| | | | | | |
| | | | | | |
CITY OF ROANOKE — WATER DEPT.

VALVE DIAGRAM

EDGE HILL PUMPING STATION S. W.

SEC. MAP. 1

DATE

PAGE NO.

"IMPERIAL" TRACING CLOTH
K. & E. CO., N. Y.