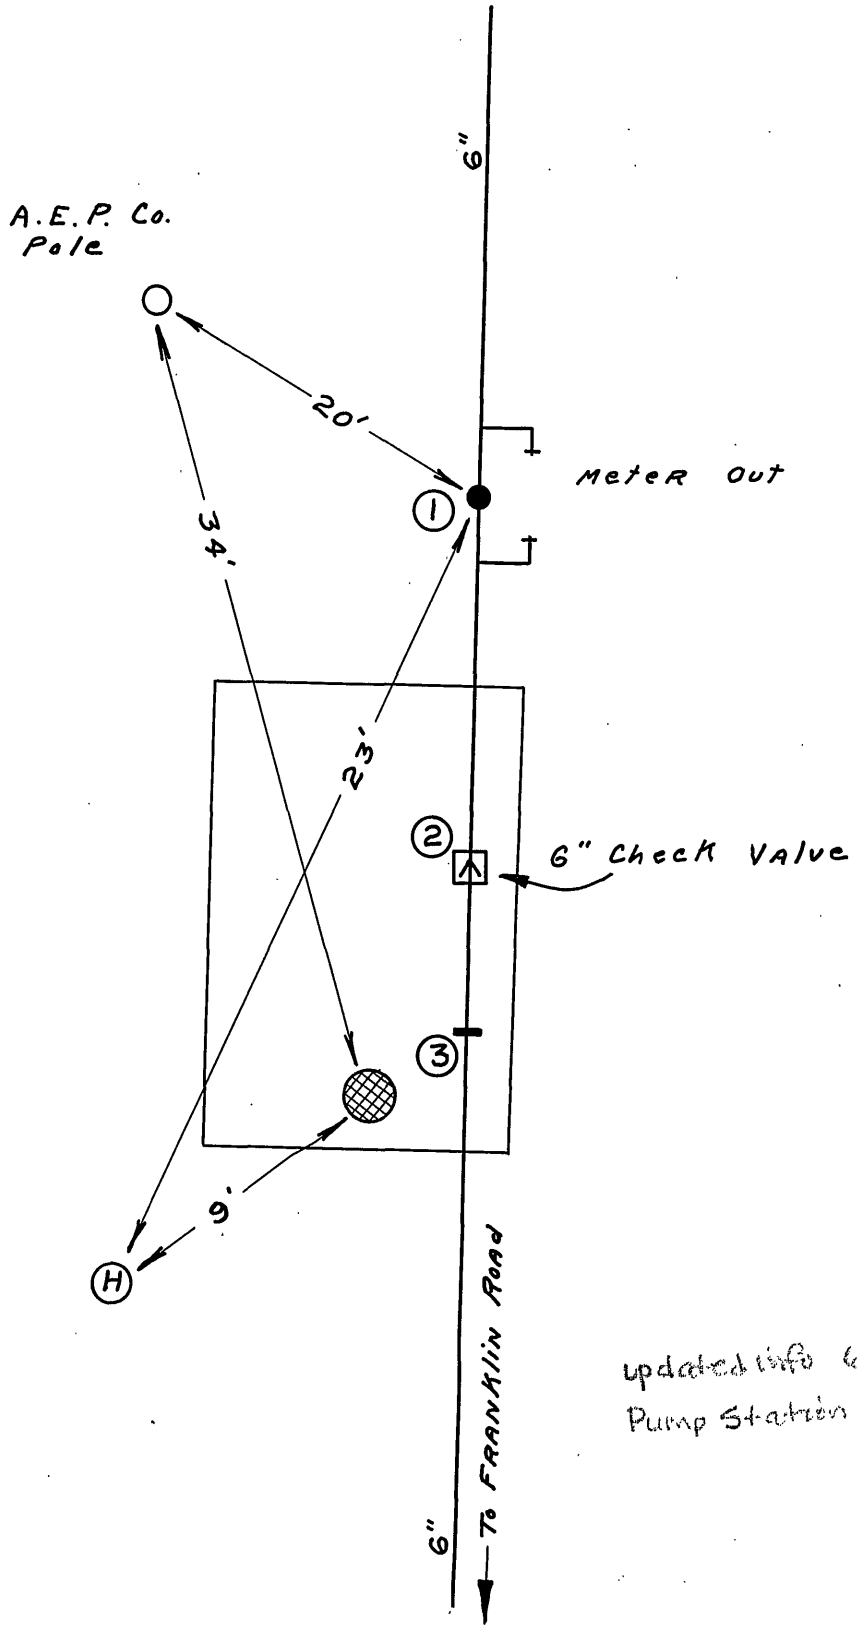

updated info 6/2005
Pump Station abandoned

DATE	NO.	SIZE	SERVICE	OPEN	TURNS
	1	6"		R	
	2	6"	CHECK VALVE		
	3	6"		R	

VALVE DIAGRAM
EDGE HILL PUMPING STATION S. W.
(near Franklin Rd.)
DWG. NO. 1
DATE
PAGE NO.

HUBBARD TRACING CLOTH
H. & E. CO., N.Y.