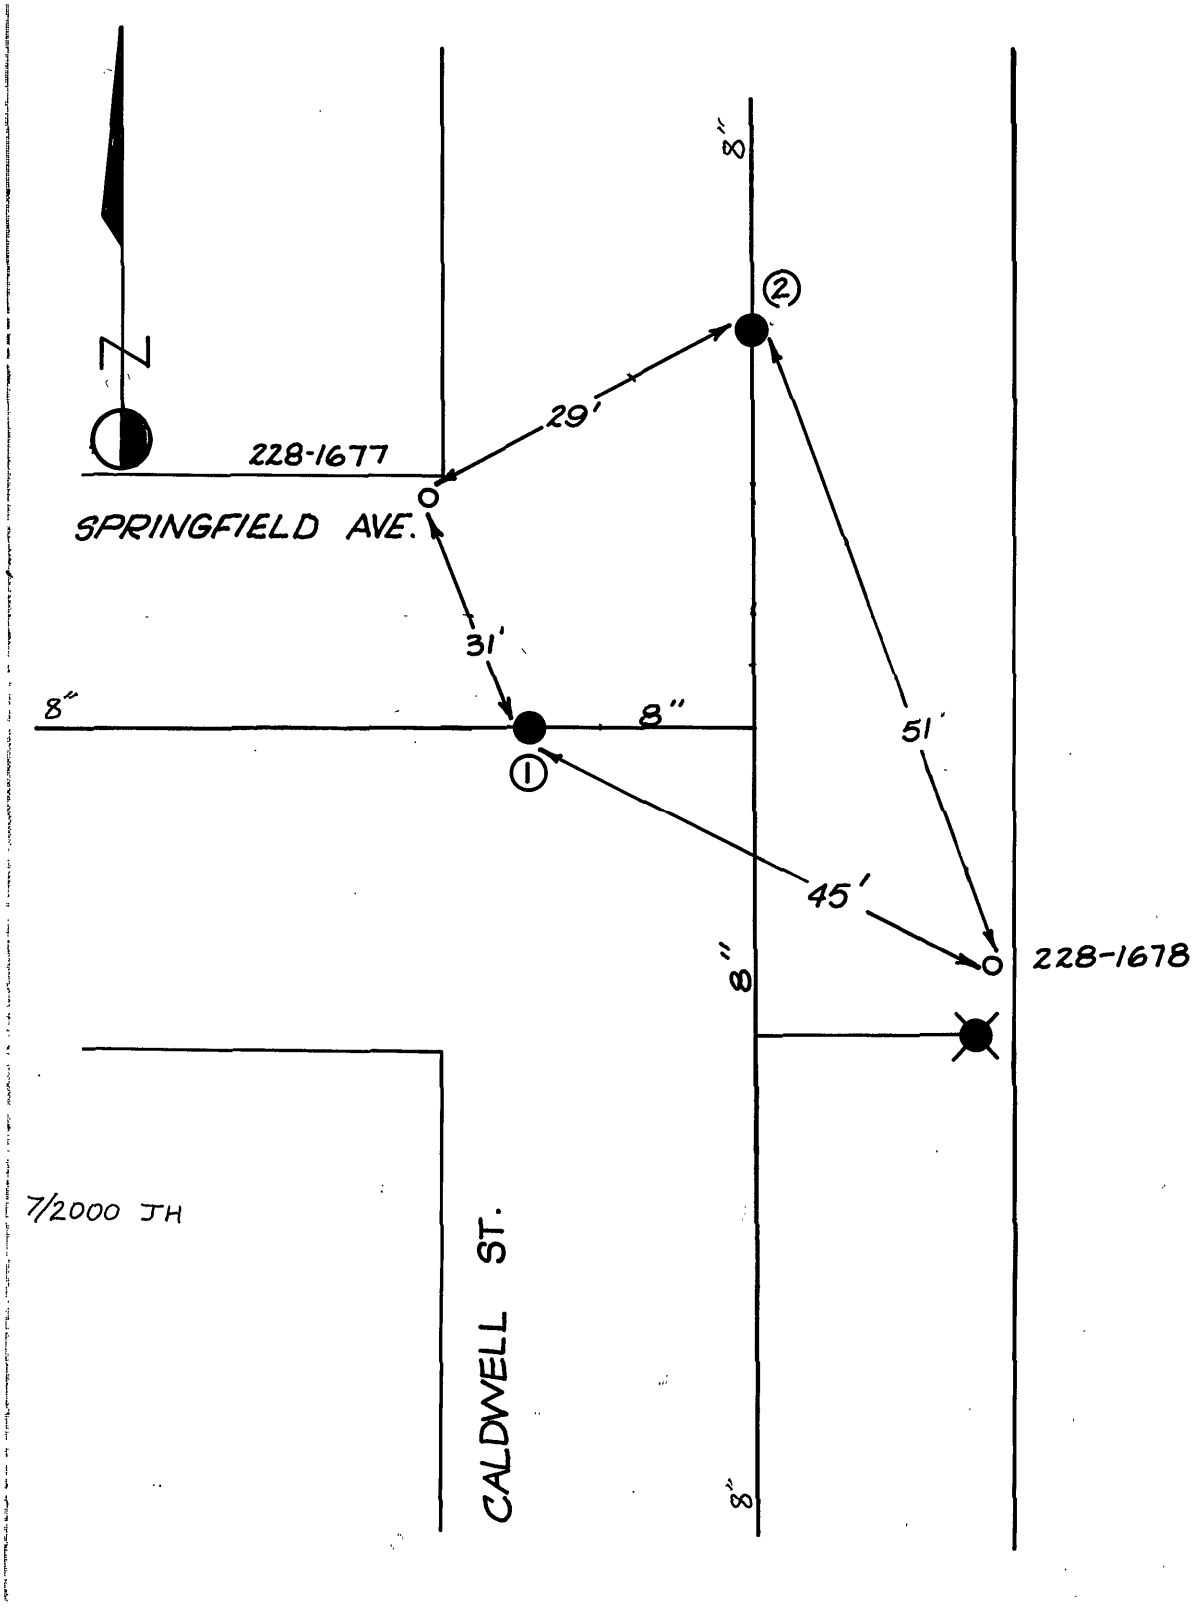


| DATE | NO. | SIZE | MAKE | OPEN | TURNS |
|---|---|---|---|---|---|
| 5-77 | 1 | 8" | MUELLER | R | |
| 5-77 | 2 | 8" | MUELLER | R | |

CITY OF ROANOKE—WATER DEPT

VALVE DIAGRAM

CALDWELL STREET N.W.

SPRINGFIELD AVE. N.W.

SEC. MAP 609

DATE PAGE NO.