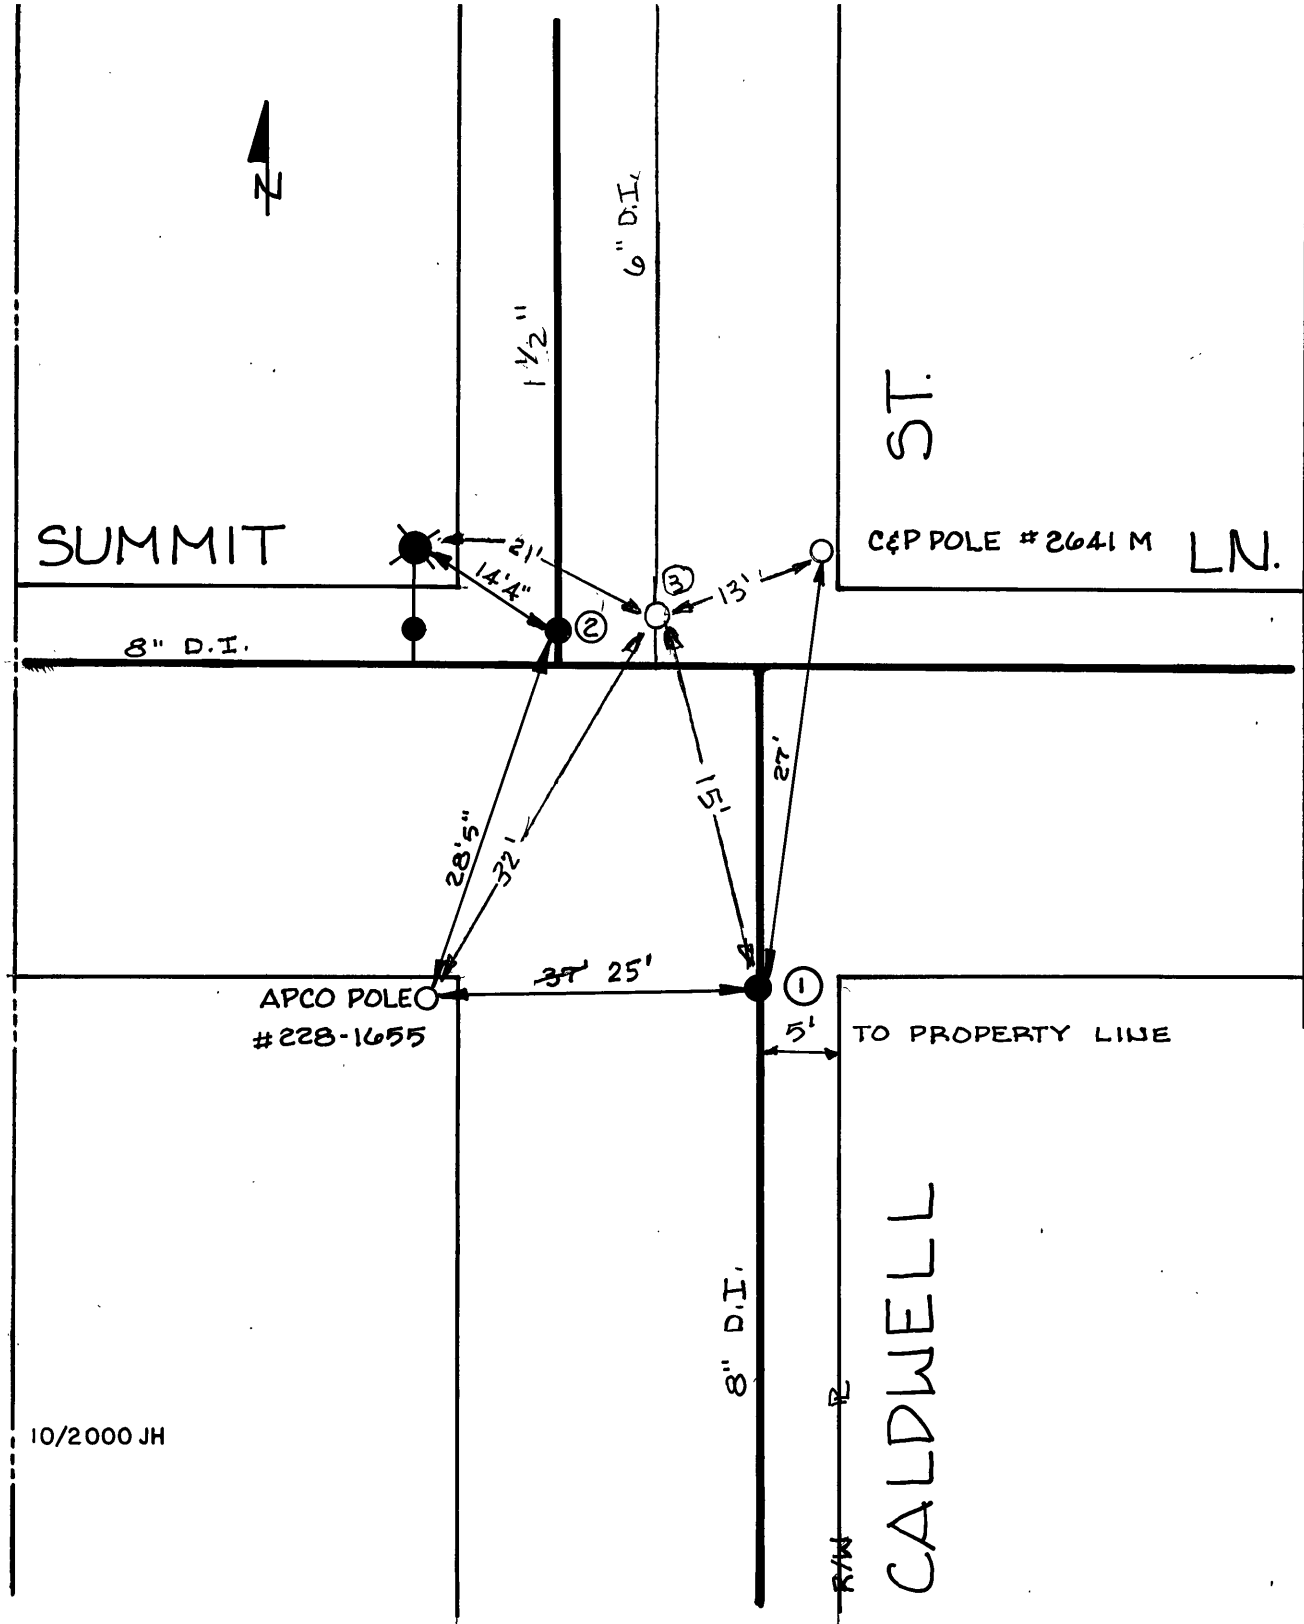

DATE	NO.	SIZE	MAKE	OPEN	TURNS
10-81	1	8"	MUELLER	R	24
10-81	2	1½"	MISC.	L	5
9-95	3	6"	Darling	R	21
1	3'	S	SPL		

CITY OF ROANOKE—WATER DEP'T

VALVE DIAGRAM

CALDWELL STREET AND SUMMIT LANE

N.W.

SEC. MAP 609

DATE 10-81 PAGE NO.