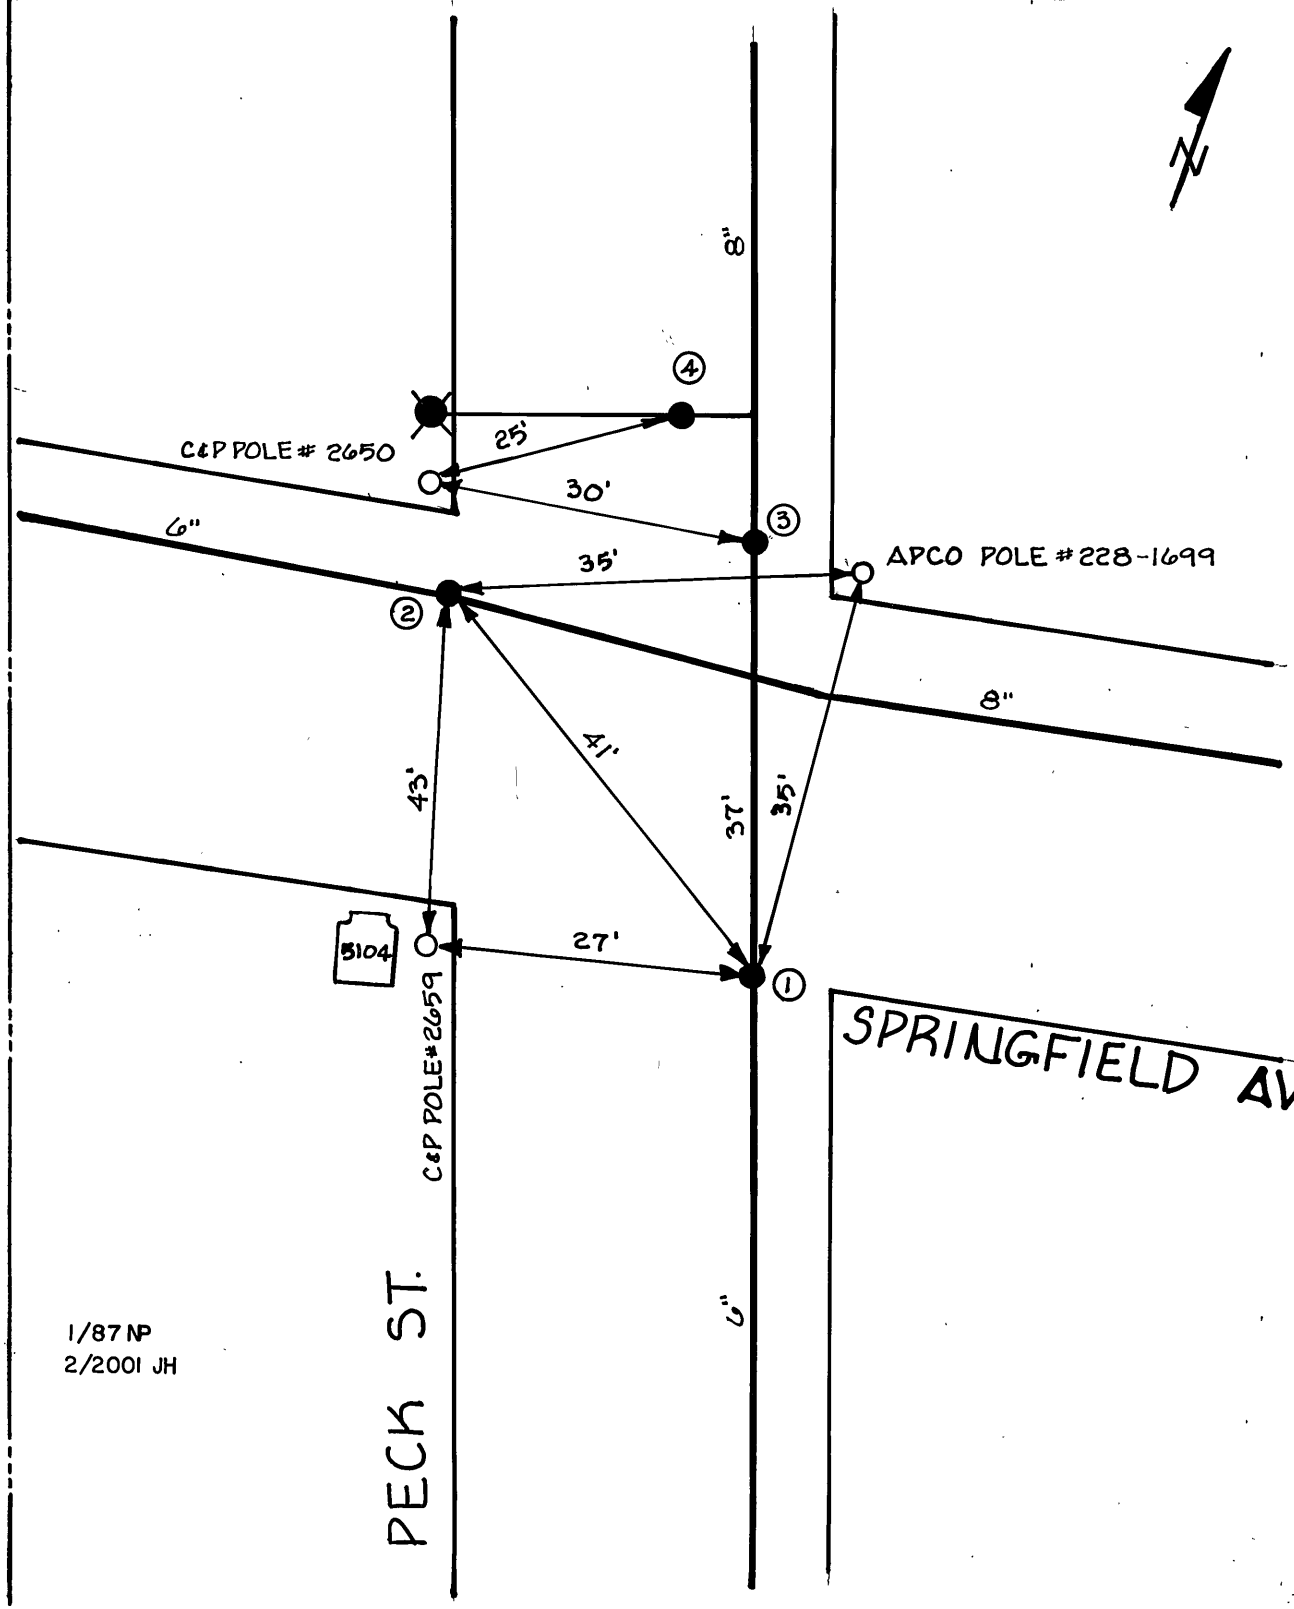

DATE	NO.	SIZE	MAKE	OPEN	TURNS
5-81	1	6"	MUELLER	R	
1981	2	6"	MUELLER	R	
1981	3	8"	MUELLER	R	
1981	4	6"	MUELLER	R	
#1	1'S	SPL			
#2	3'W	EPL			
#3	3'N	NPL			
#4	15'N	NPL			

1/87 NP
2/2001 JH

CITY OF ROANOKE—WATER DEP'T

VALVE DIAGRAM

PECK STREET AND

SPRINGFIELD AVENUE

N.W.

SEC. MAP 609

DATE 6-81 PAGE NO.