NOTES:
1. CONTRACTOR SHALL CONFIRM EXISTING SERVICES MARKED FOR DEMOLITION ARE INACTIVE PRIOR TO DEMOLITION. OWNER WILL ASSIST CONTRACTOR WITH VERIFICATION.
2. CONTRACTOR SHALL PERFORM EXPLORATORY EXCAVATIONS AT UTILITY CROSSINGS TO VERIFY DEPTH PRIOR TO CONSTRUCTION AS DIRECTED BY PROJECT MANUAL.

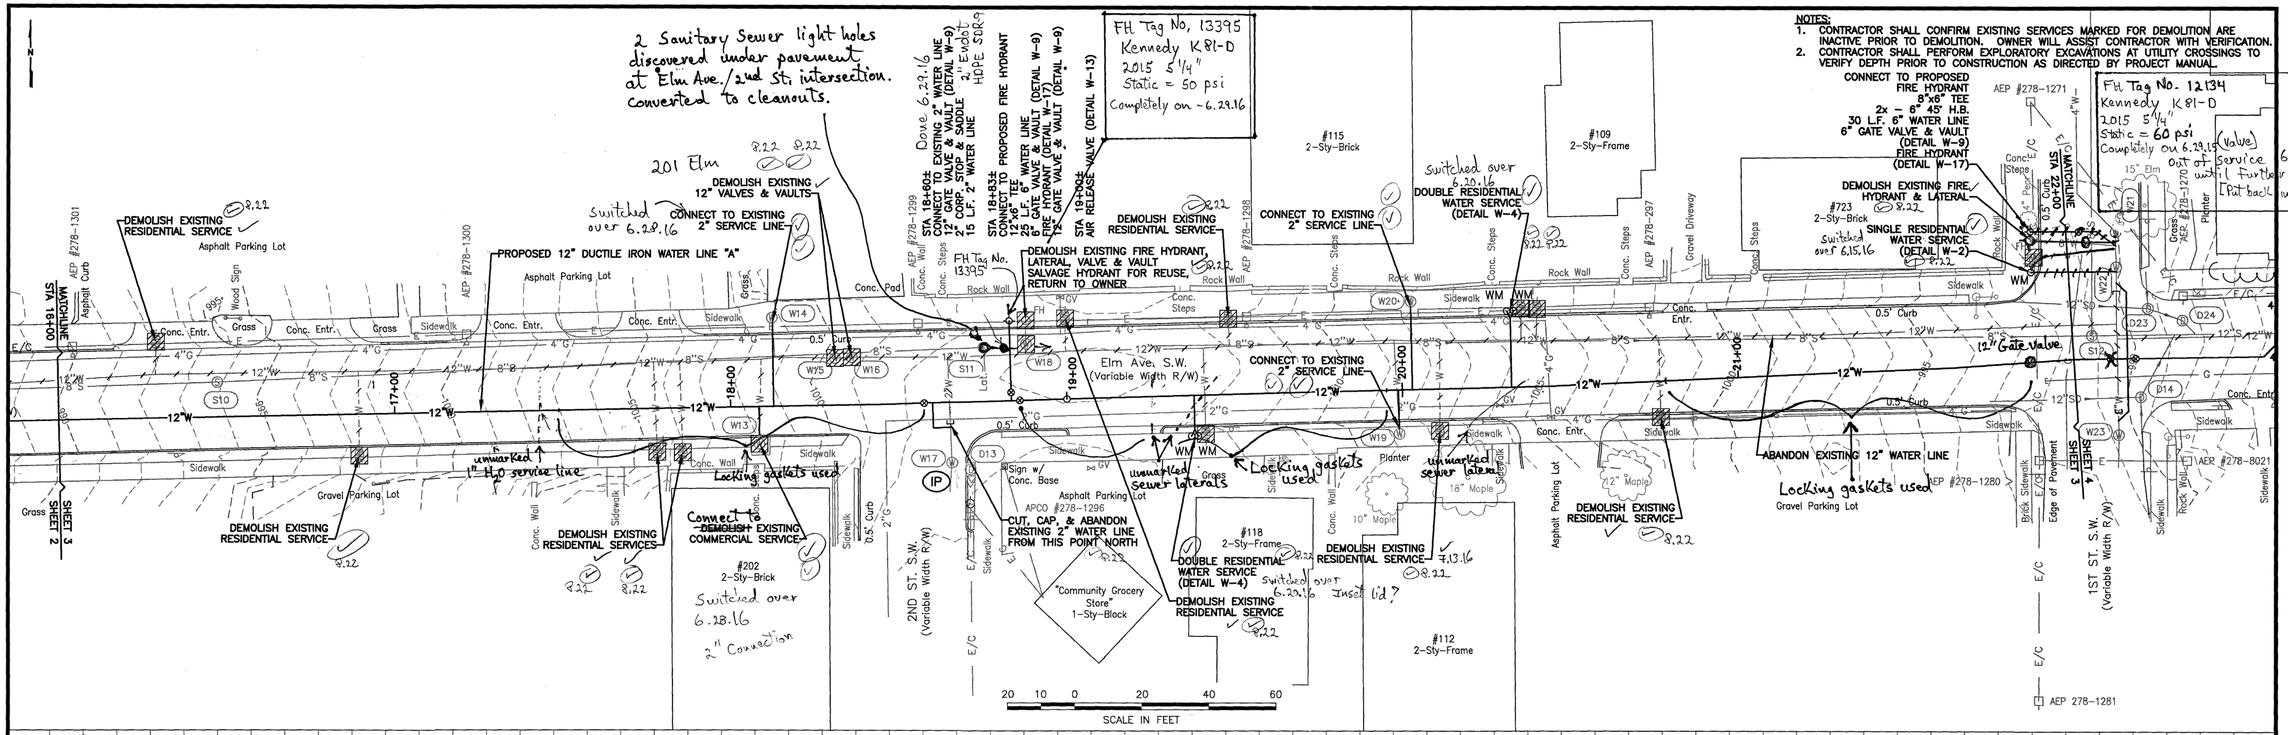

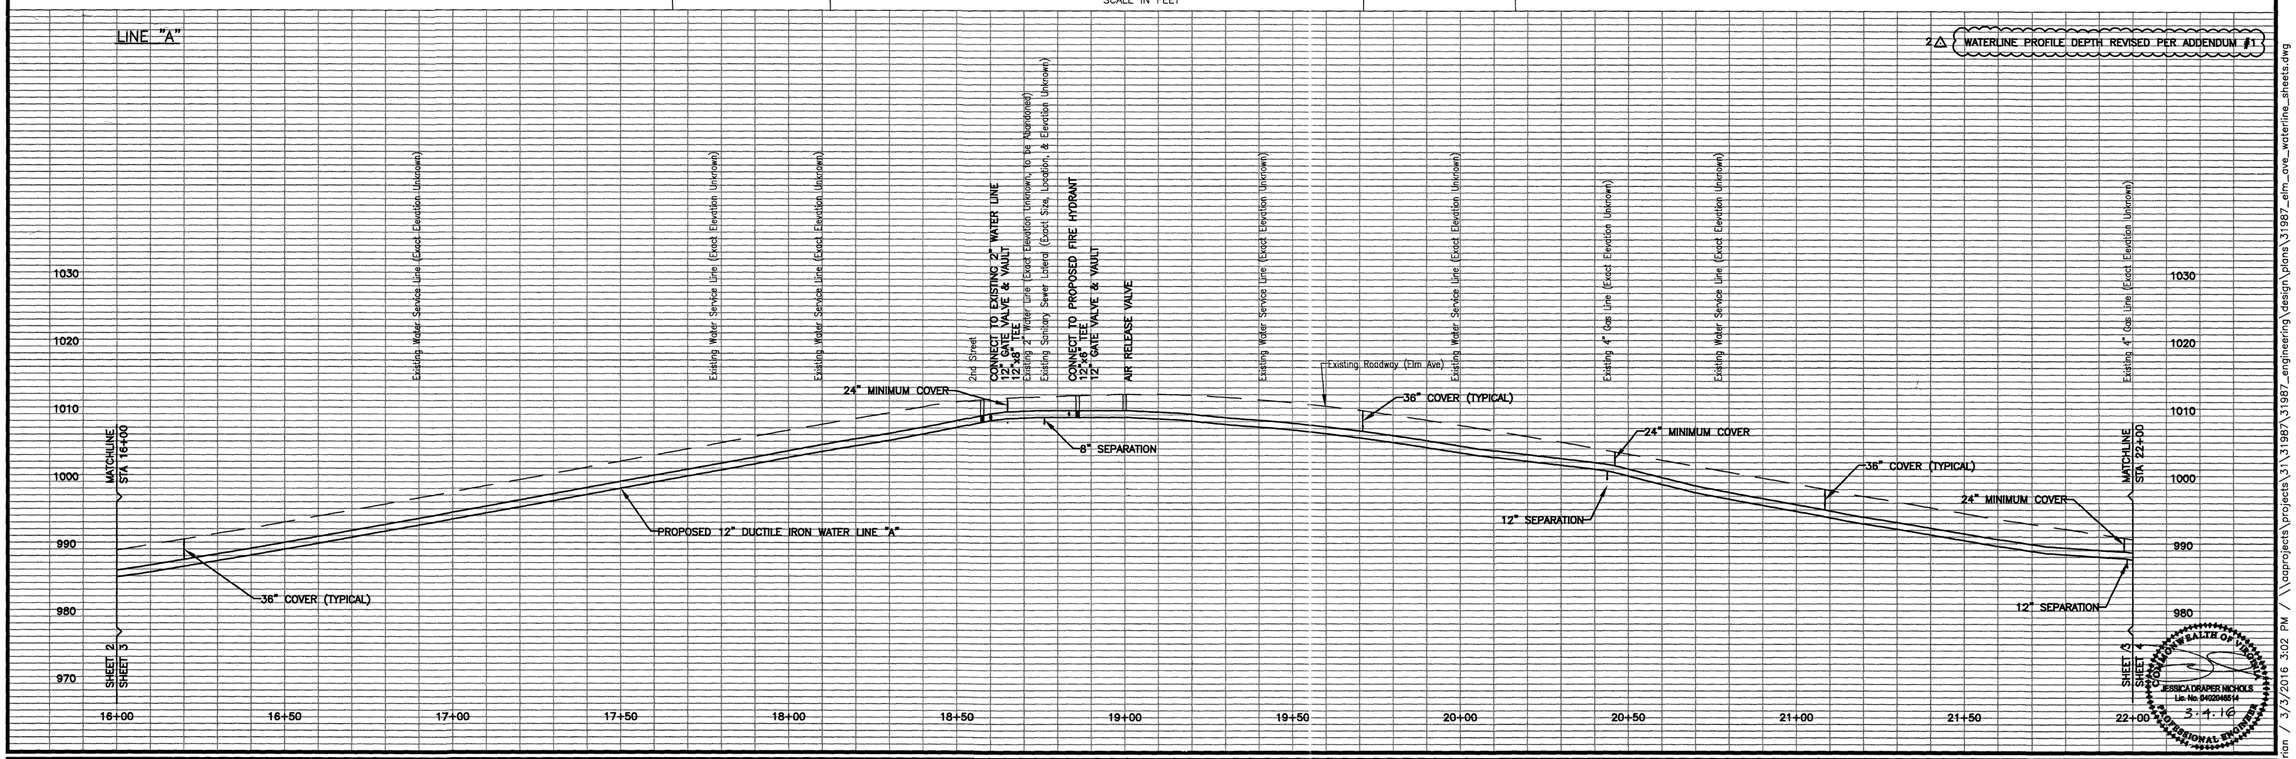

JESSICA DRAPER NICHOLS
Lic. No. 0402040514
3-4-16
COMMONWEALTH OF VIRGINIA
PROFESSIONAL ENGINEER

ANDERSON & ASSOCIATES, INC.
Professional Design Services
www.andassoc.com
100 Ardmore St.
Blacksburg, Va. 24060
540-552-5592

DATE	29 JAN 16
DESIGNED:	BJM
DRAWN	BJM
CHECKED :	DAA
QA / QC :	DAA

REV. #	COMMENTS	DATE
1	WVWA COMMENTS	17 FEB 16
2	ADDENDUM #1	04 MAR 16

ELM AVENUE WATER MAIN REPLACEMENT - PHASE 1
WESTERN VIRGINIA WATER AUTHORITY

WATER PLAN & PROFILE SHEET
LINE "A" STA 16+00 TO STA 22+00

DOCUMENT NO. 31987 – 018
SHEET 3 OF 7

McNinney, Brian / 3/3/2016 3:02 PM / \\caprojects\projects\31\31987\31987_engineering\design\plans\31987_elm_ave_waterline_sheets.dwg

As-Built Substantial Completion 9.21.16 K. Winslow