NOTES:
1. CONTRACTOR SHALL CONFIRM EXISTING SERVICES MARKED FOR DEMOLITION ARE INACTIVE PRIOR TO DEMOLITION. OWNER WILL ASSIST CONTRACTOR WITH VERIFICATION.
2. CONTRACTOR SHALL PERFORM EXPLORATORY EXCAVATIONS AT UTILITY CROSSINGS TO VERIFY DEPTH PRIOR TO CONSTRUCTION AS DIRECTED BY PROJECT MANUAL.

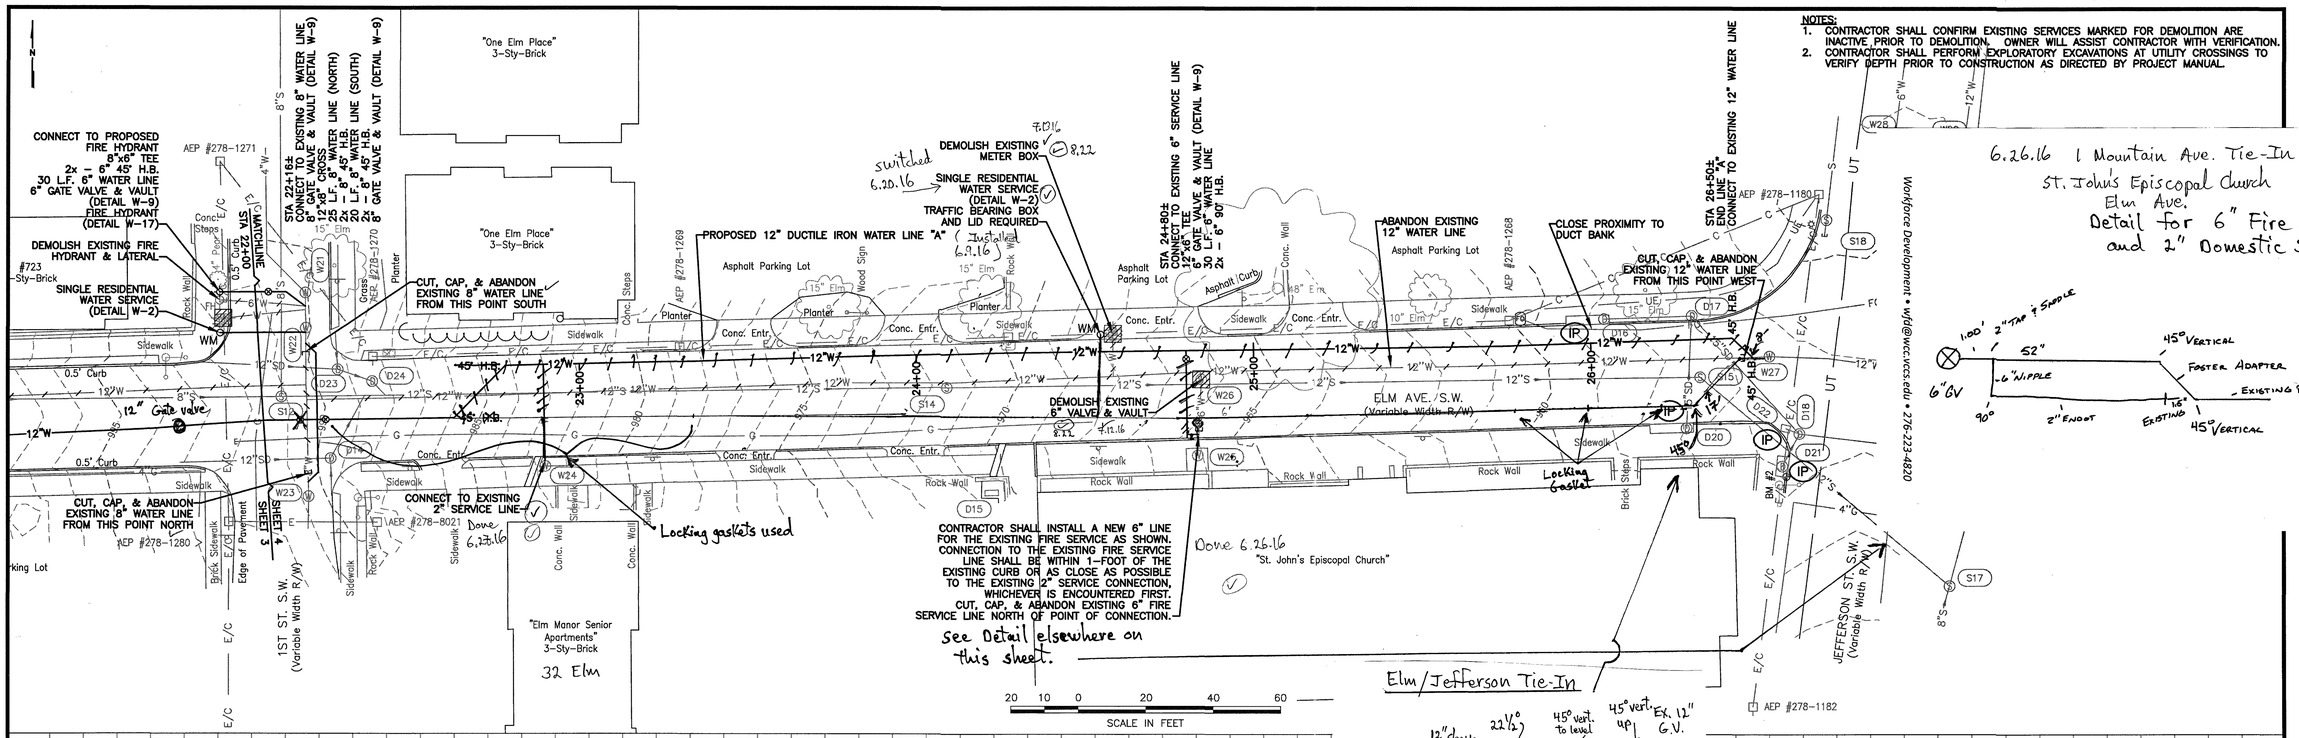

Wytheville Community College
Workforce Development
Workforce Development Office
WCC Wytheville Community College

McNinney, Brian / 3/3/2016 3:02 PM / \\coaprojects\projects\31\31987\31987_engineering\design\plans\31987_elm_ave_waterline_sheets.dwg

ANDERSON & ASSOCIATES, INC. Professional Design Services www.andassoc.com 100 Ardmore St. Blacksburg, Va. 24060 540-552-5592	DATE : 29 JAN 16 DESIGNED : BJM DRAWN : BJM CHECKED : DAA QA / QC : DAA	REV. # / COMMENTS / DATE 1 WVWA COMMENTS 17 FEB 16 2 ADDENDUM #1 04 MAR 16	ELM AVENUE WATER MAIN REPLACEMENT - PHASE 1 WESTERN VIRGINIA WATER AUTHORITY	WATER PLAN & PROFILE SHEET LINE "A" STA 22+00 TO END OF LINE	DOCUMENT NO. 31987 – 019 SHEET 4 OF 7

As-Built Substantial Completion 9.21.16 K. Winslow