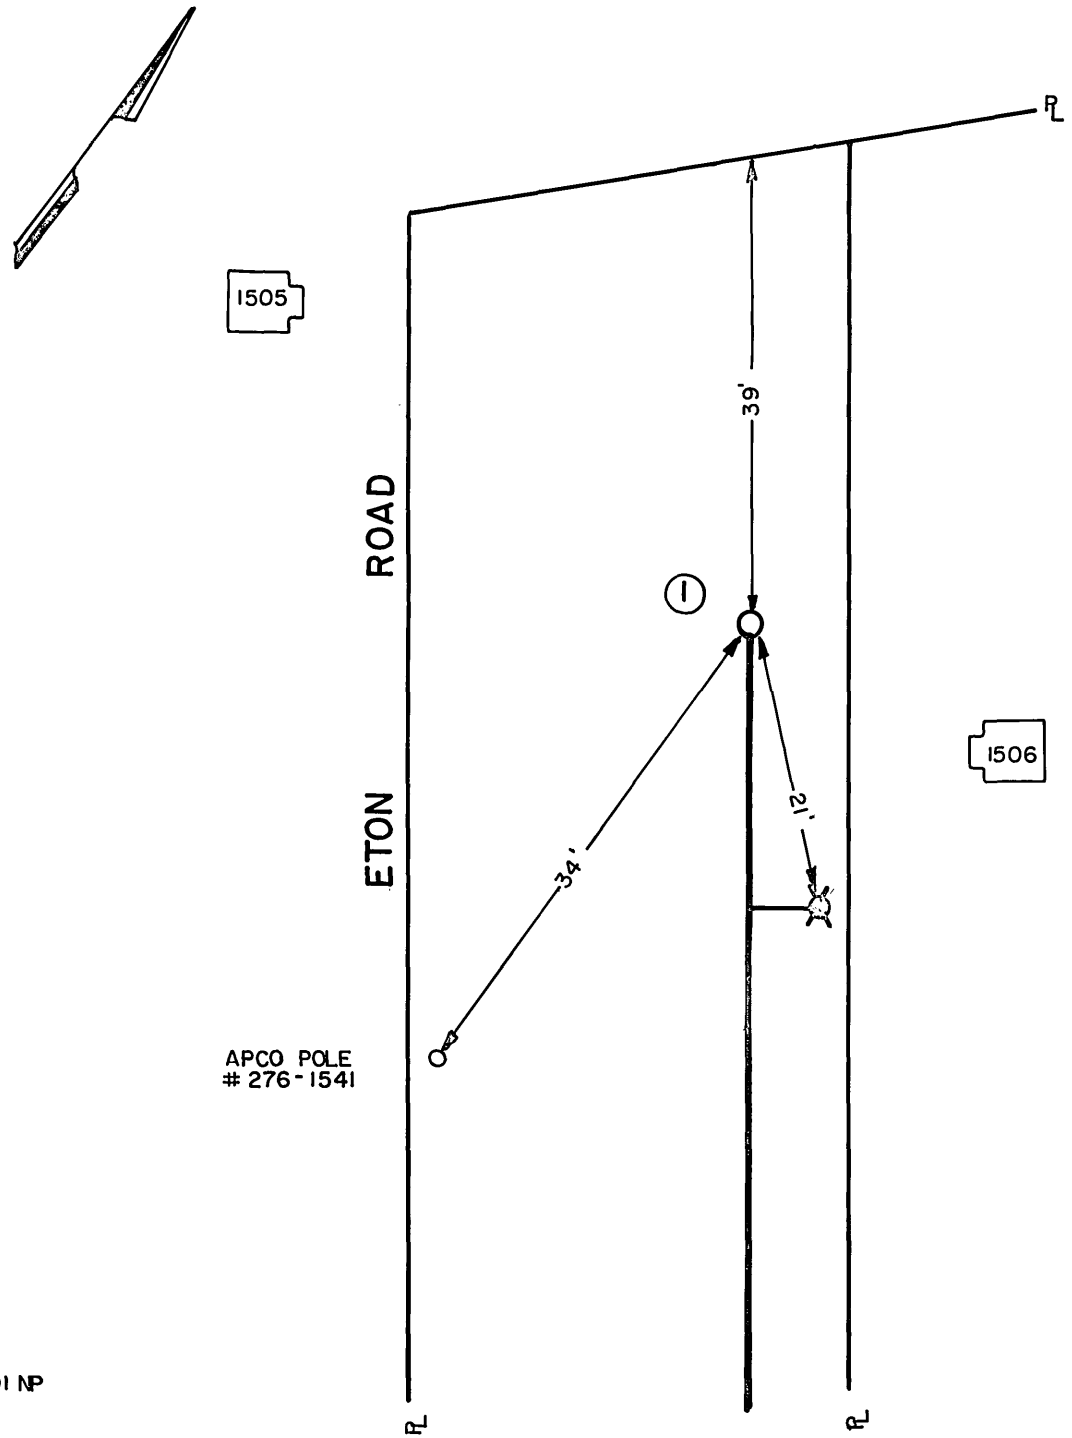

DATE	NO.	SIZE	MAKE	OPEN	TURNS
12-86	1	2"	BLOW OFF	L	

CITY OF ROANOKE—WATER DEP'T
VALVE DIAGRAM
1506 ETON ROAD
SEC. MAP 515 S.W.
DATE PAGE NO.

11/91 NP