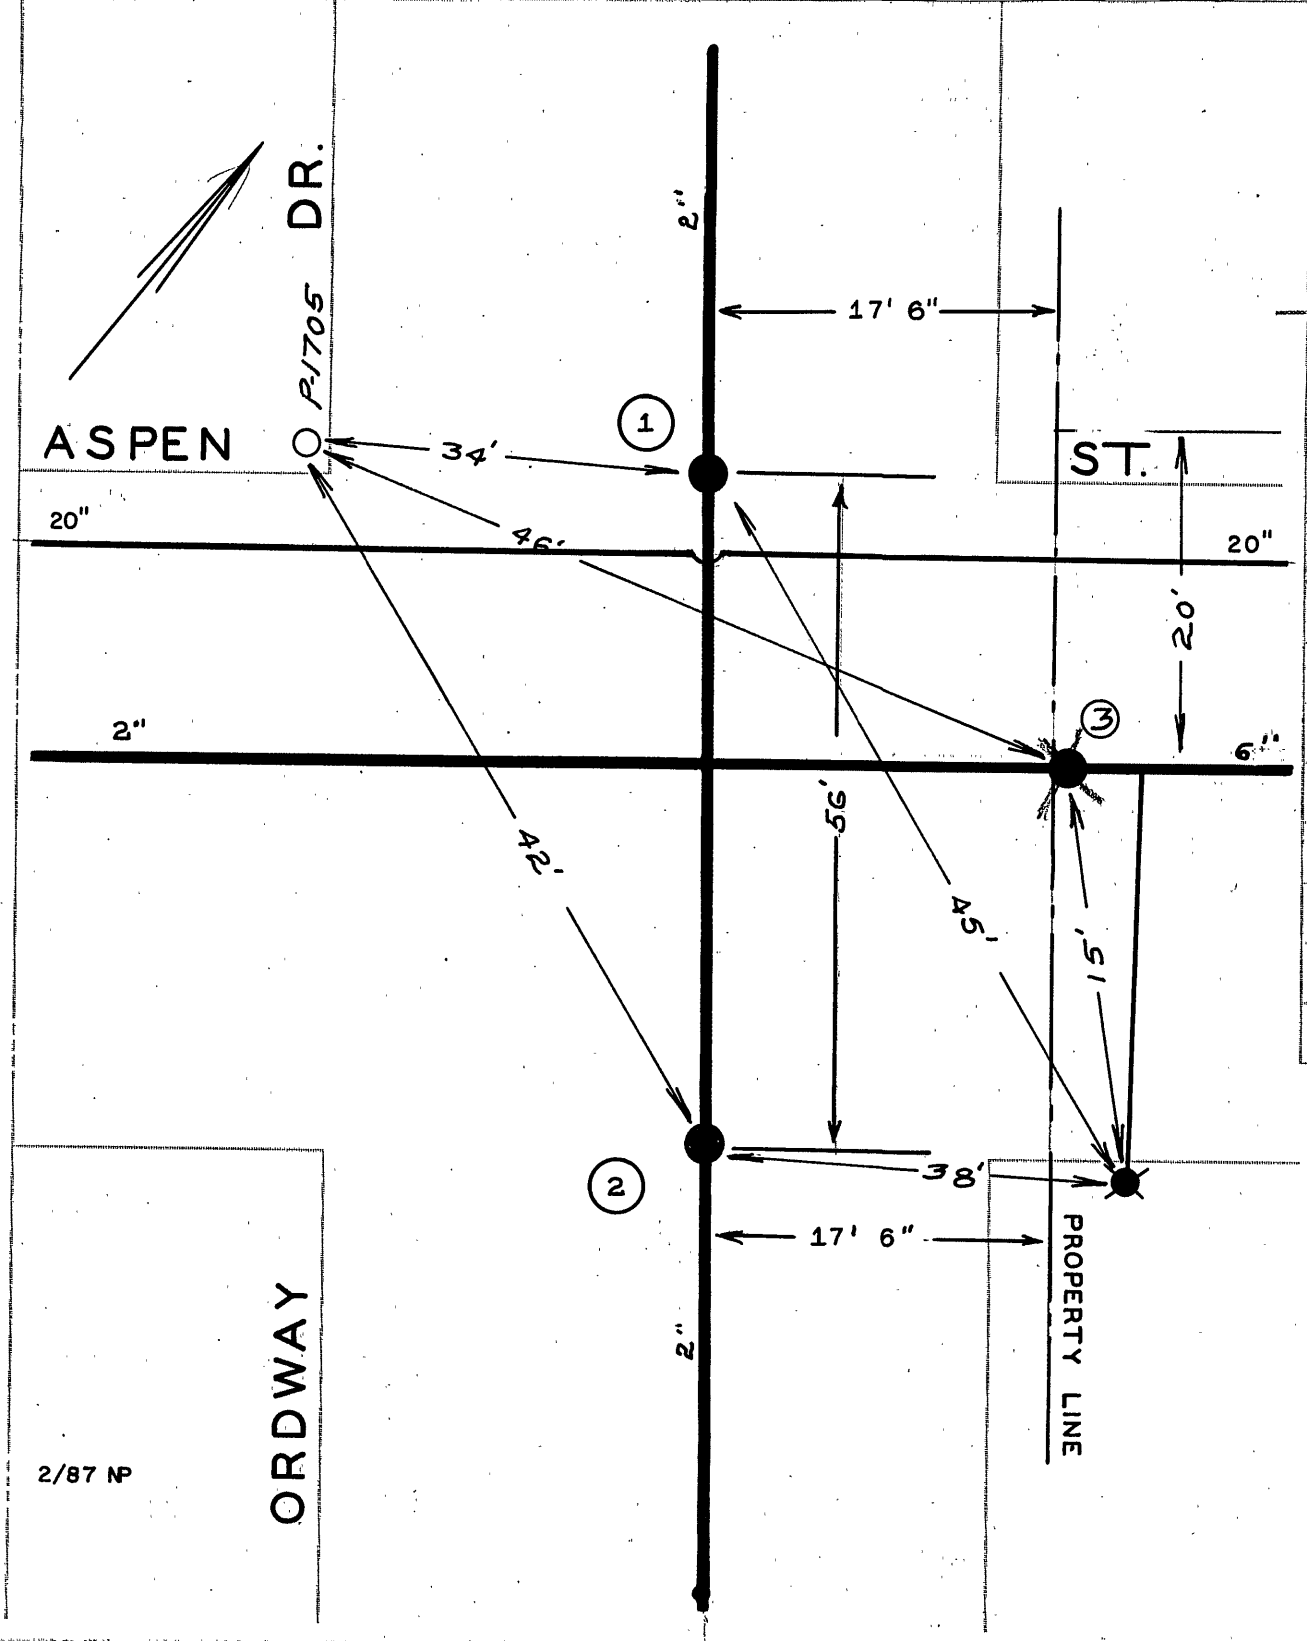

DATE	NO.	SIZE	MAKE	OPEN	TURNS
1947	1	2"	DARLING	R	7
1947	2	2"	DARLING	R	7
~~1952~~	~~3~~	~~2"~~	~~DARLING~~	~~R~~	~~7~~
	1	0	NPL		
	2	0	SPL		
	3	0	EPL		

(3) Valve broke 10/18/2000.
Did away w/ valve.
Tied the mains together.

CITY OF ROANOKE—WATER DEP'T
VALVE DIAGRAM
ASPEN ROAD &
ORDWAY DRIVE N.W.

SEC. MAP 247
DATE 5/8/47 PAGE NO. NW 288

2/87 NP

Scanned / Indexed