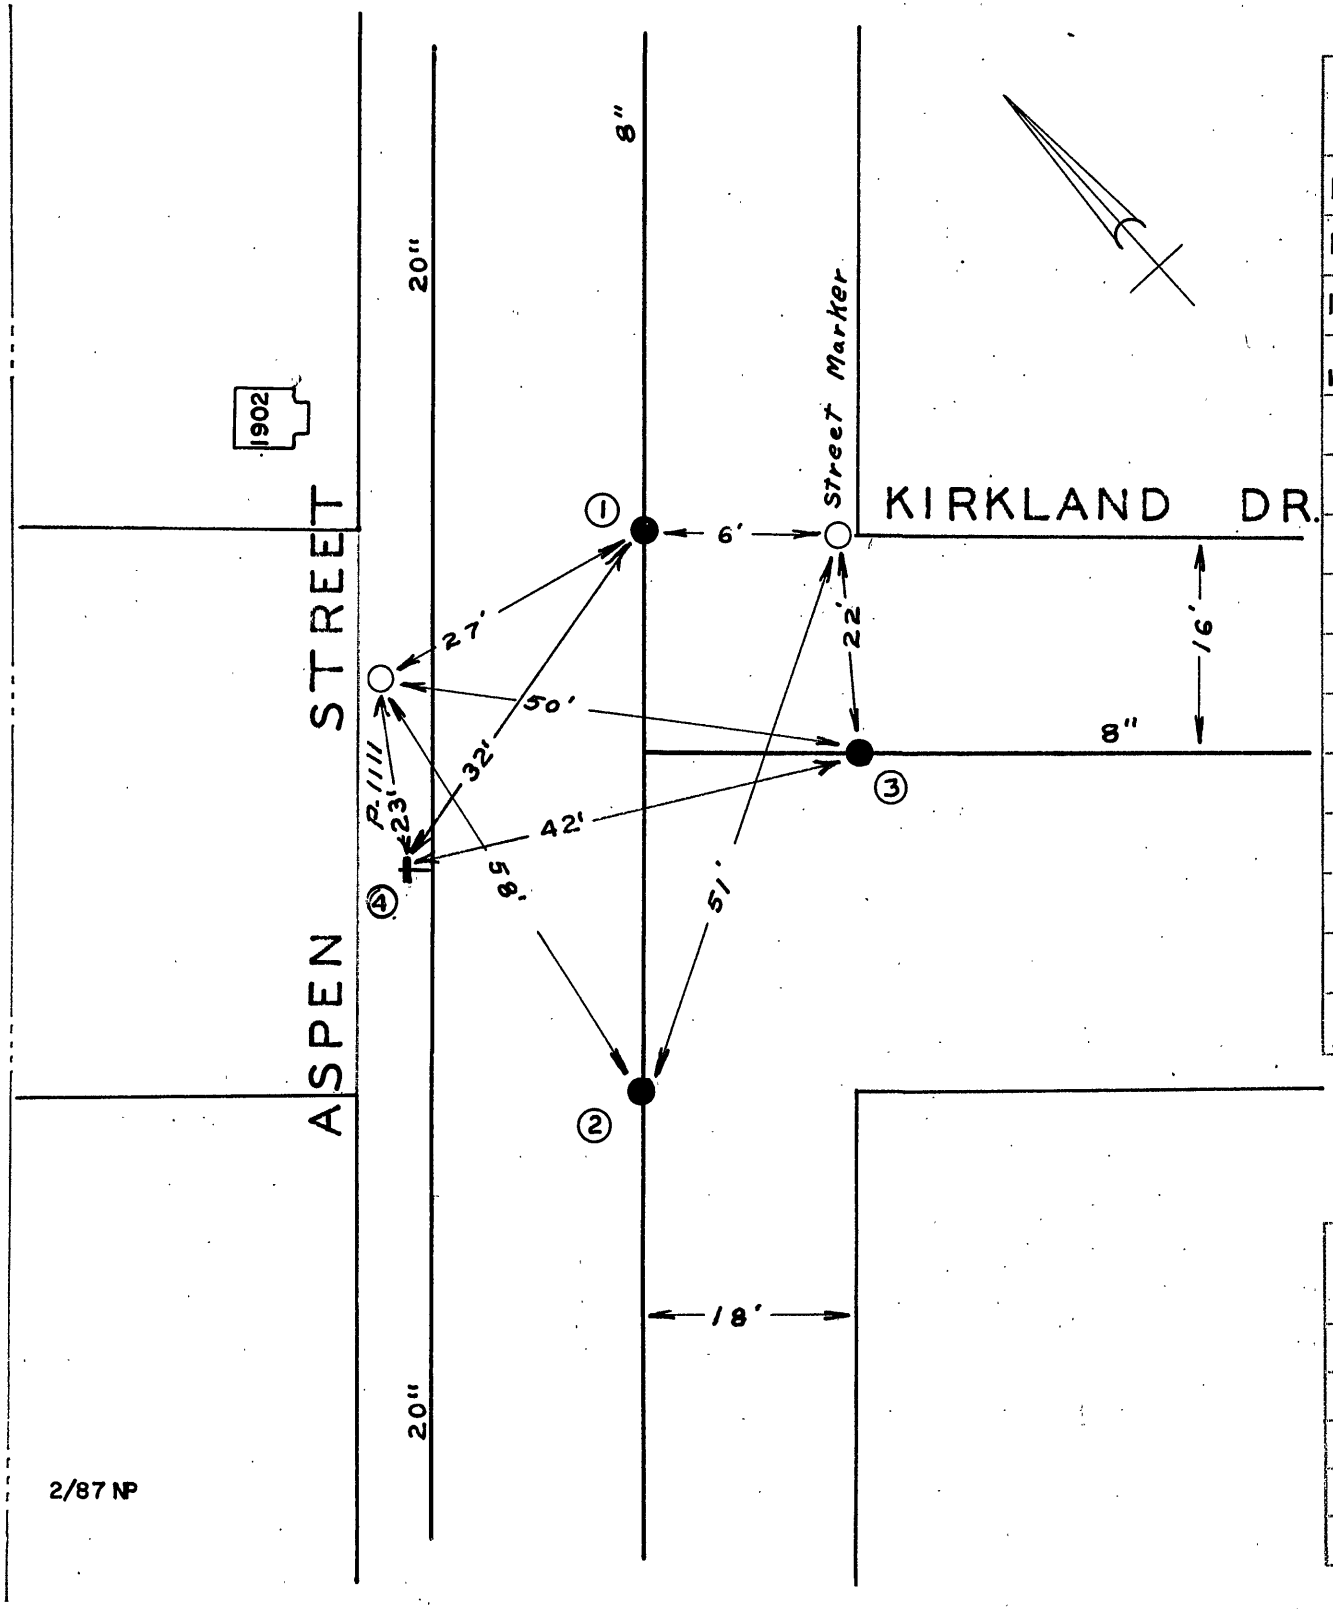

DATE	NO.	SIZE	MAKE	OPEN	TURNS
1952	1	8"	MUELLER	R	27
1952	2	6"	MUELLER	R	21
1952	3	8"	MUELLER	R	27
12-64	4	6"	MUELLER	R	21
	1	0	NPL		
	2	0	SPL		
	3	0	EPL		

CITY OF ROANOKE—WATER DEPT.

VALVE DIAGRAM

ASPEN ST. & KIRKLAND DRIVE N. W.

SEC. MAP 247

DATE PAGE NO.

2/87 NP

"IMPERIAL" TRACING CLOTH K & E CO., N. Y.