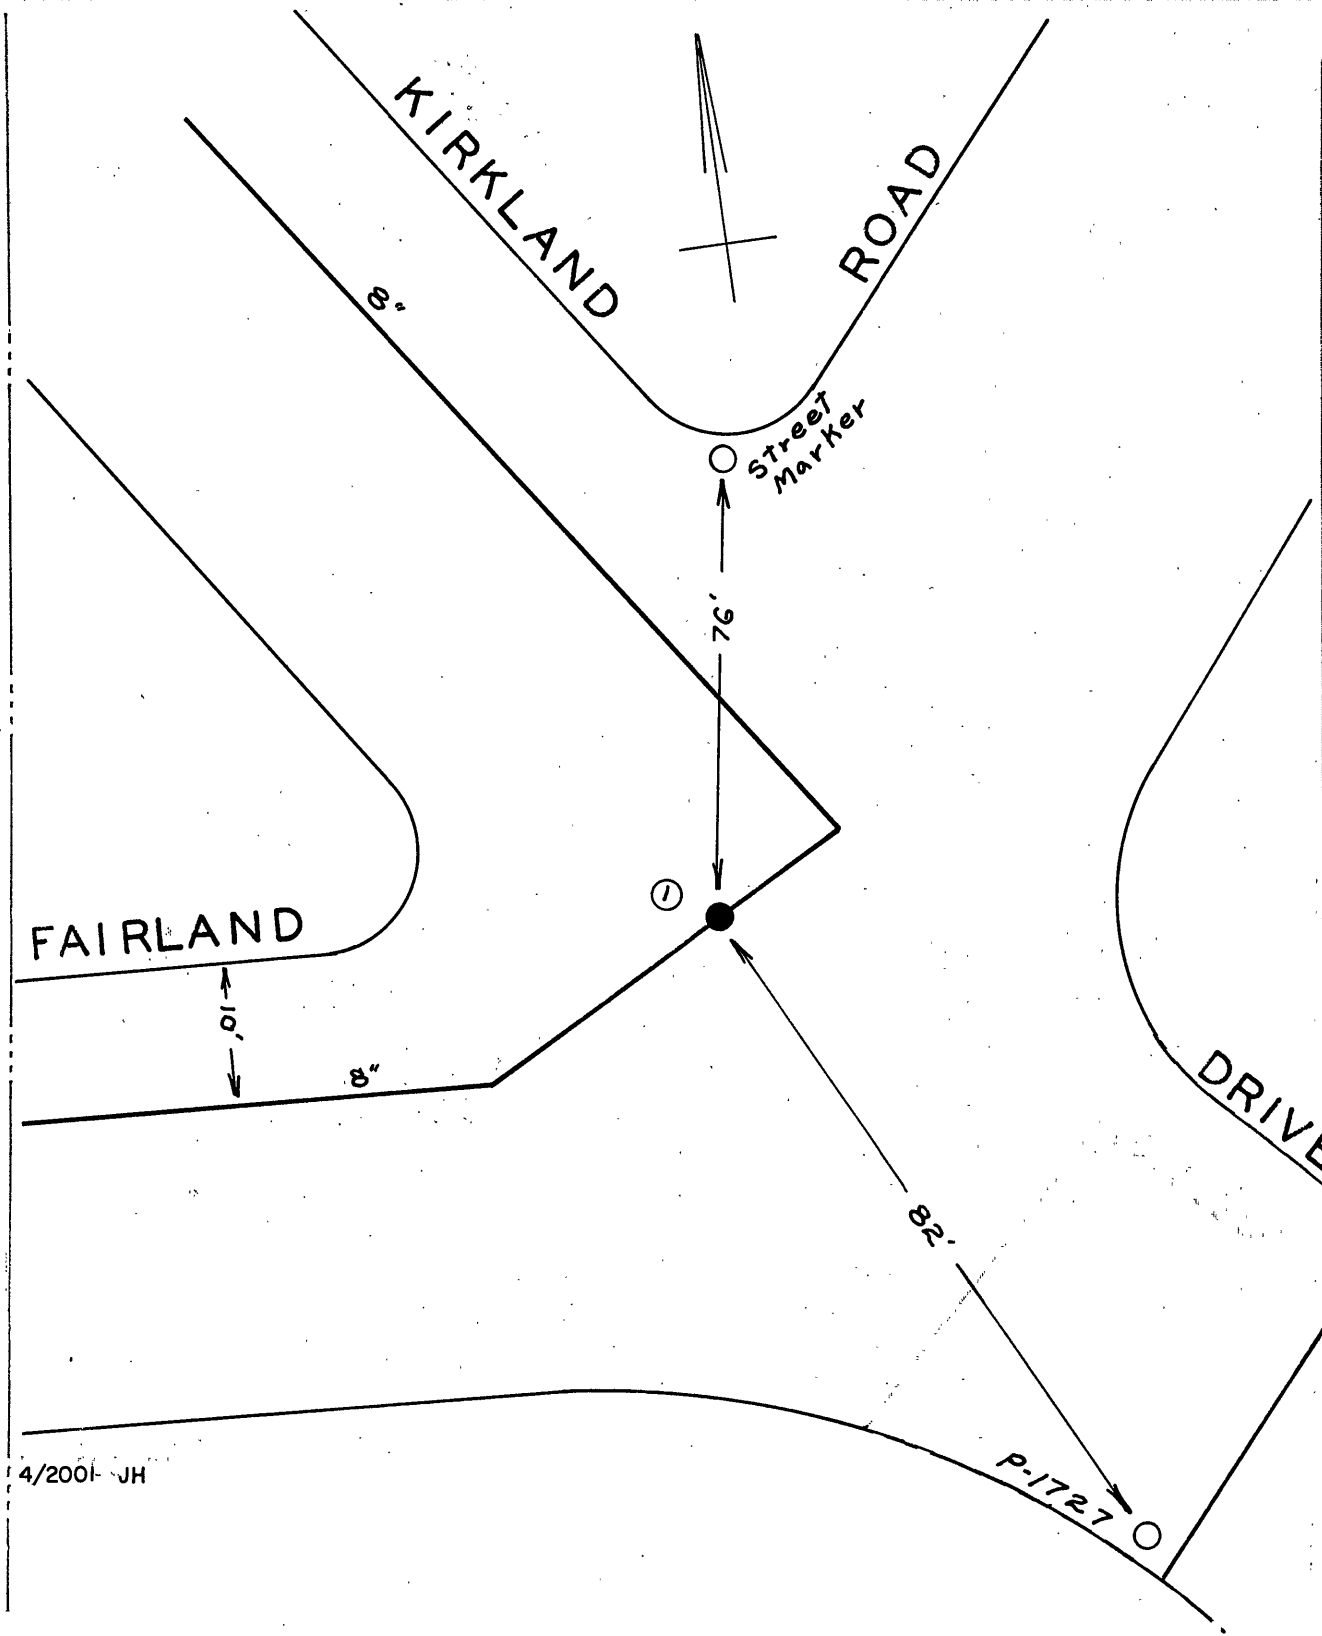

DATE	NO.	SIZE	MAKE	OPEN	TURNS
1952	1	8"	MUELLER	R	27
	1	0	SPL		

CITY OF ROANOKE—WATER DEPT.

VALVE DIAGRAM

FAIRLAND RD. &

KIRKLAND DRIVE

SEC. MAP 247 N.W.

DATE PAGE NO.

4/2001 JH

"IMPERIAL" TRACING CLOTH
K & E CO., N. Y.