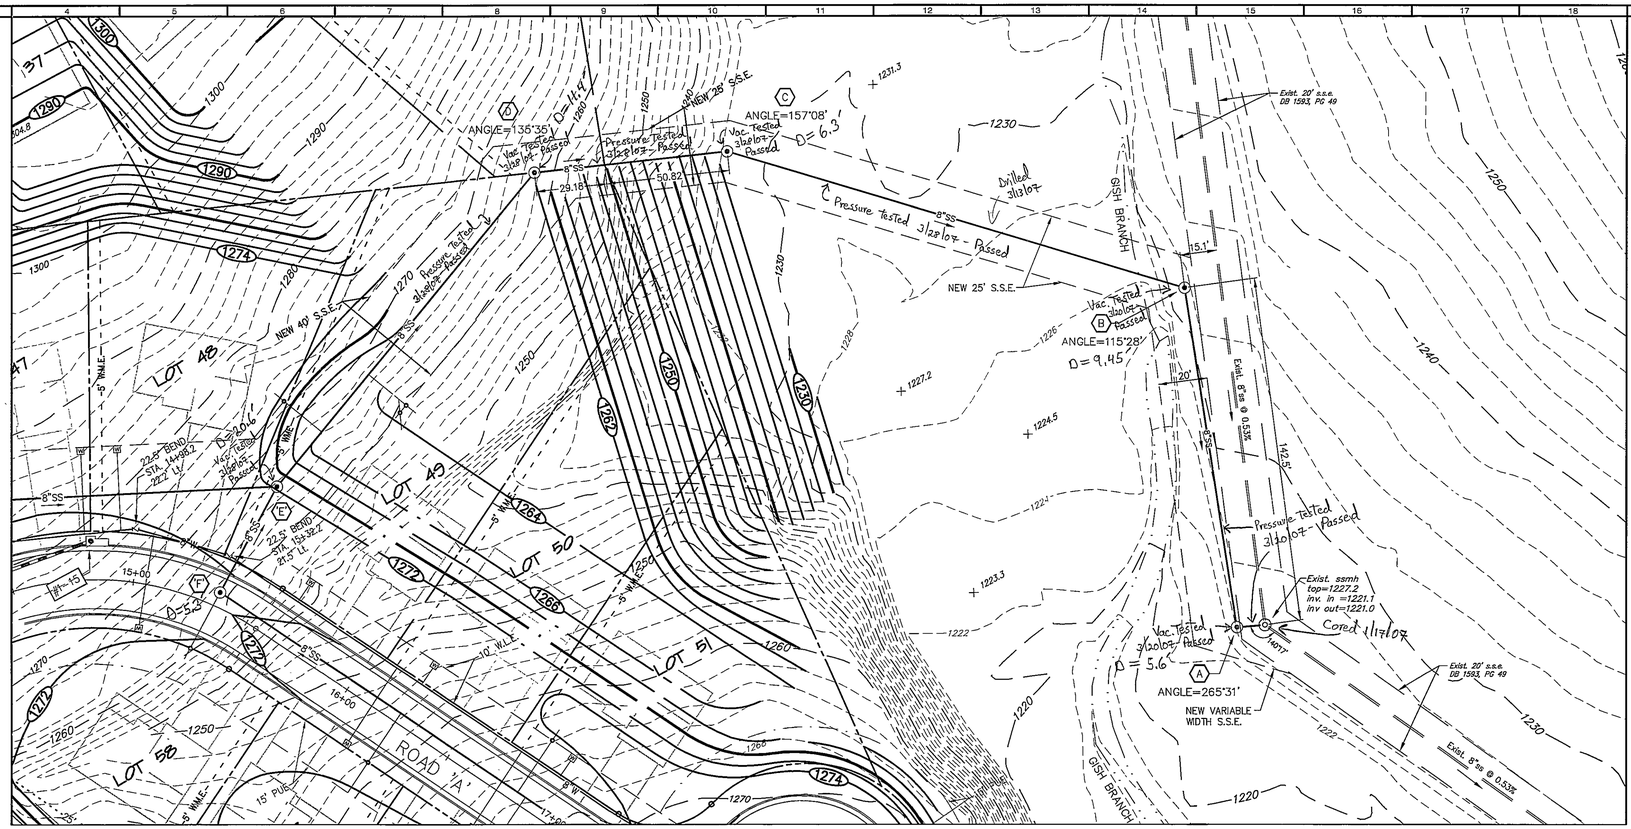

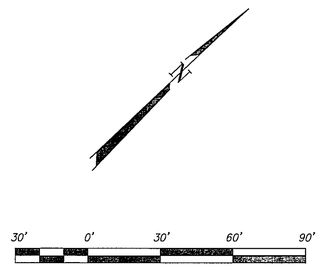

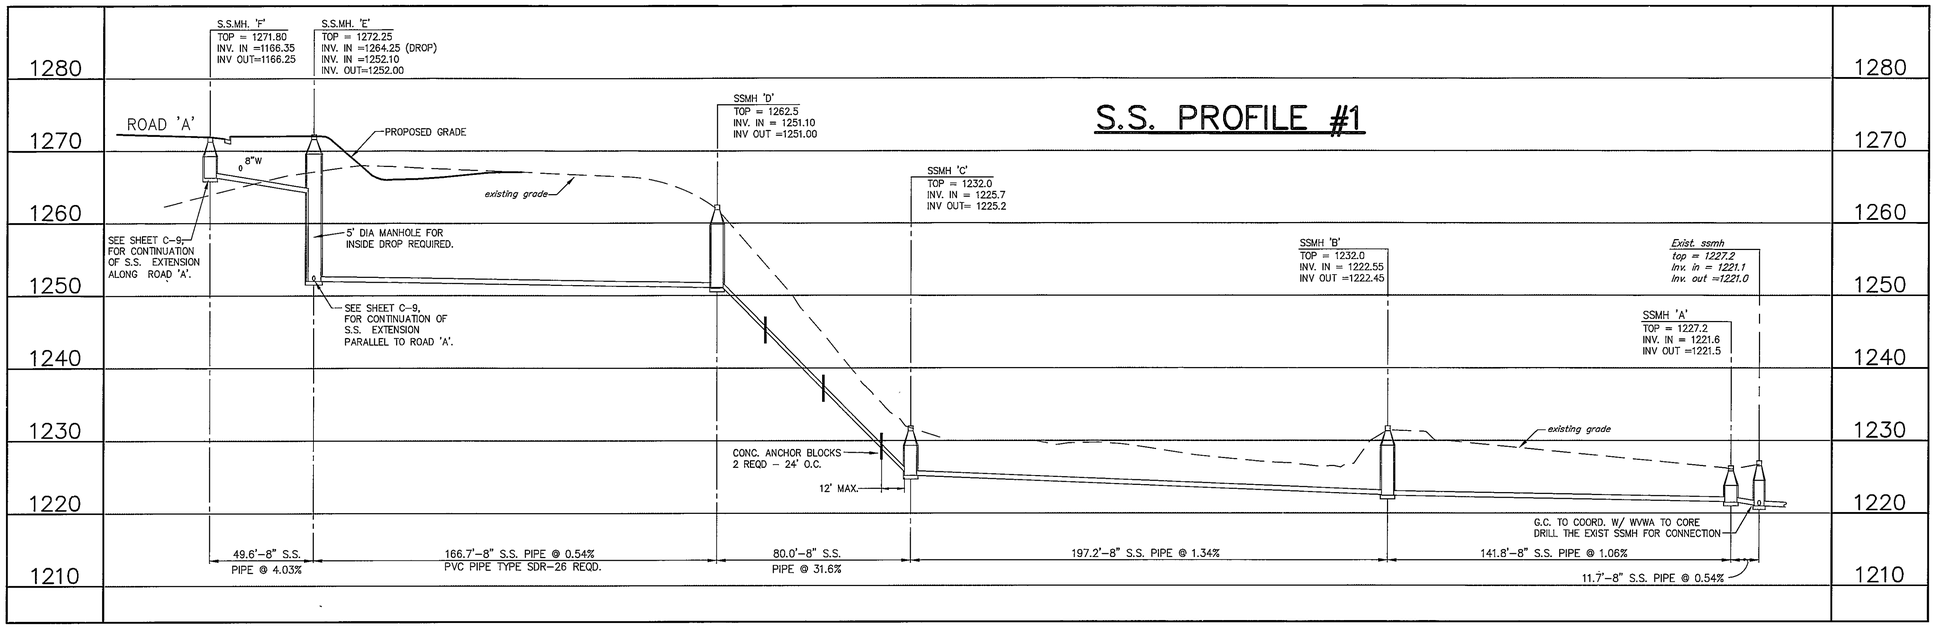

SCALES: HORZ.– 1"=30'
VERT. – 1"=10'

COMMONWEALTH OF VIRGINIA
ROGER I. STURGILL
No. 033058
PROFESSIONAL ENGINEER

BALZER AND ASSOCIATES, INC.
BYRNE
REFLECTING TOMORROW
www.balzer.cc
PLANNERS • ARCHITECTS
ENGINEERS • SURVEYORS

1208 Corporate Circle
Roanoke, Virginia 24018
Phone: 540/772-9580
FAX: 540/772-8050

501 Branchway Road
Richmond, Virginia 23236
Phone: 804/794-0571
FAX: 804/794-2635

880 Technology Park Drive
Suite 200
Glen Allen, Virginia 23059
Phone 804/553-0132
FAX 804/553-0133

102 Hubbard Street
Blacksburg, Virginia 24060
Phone 540/961-0961
FAX 540/961-0962

1657 Commerce Road
Suite 201
Verona, Virginia 24482
Phone: 540/248-3220
FAX: 540/248-3221

FAIRWAYS at HANGING ROCK
SECTION 2
OFF-SITE SANITARY SEWER EXTENSION
ROANOKE COUNTY, VIRGINIA

DRAWN BY: JVJ
DESIGNED BY: JVJ
CHECKED BY: SMH
DATE: 12/21/05

REVISIONS:
04/04/06 PER VDOT & RKE CO. 1ST REVIEW
07/12/06 PER VDOT & RKE CO. 2nd REVIEW

SCALE: 1"=30'

SHEET NO.
C-13

JOB NO.
R0500377.00

As-Built 10/5/07 K. Winslow