


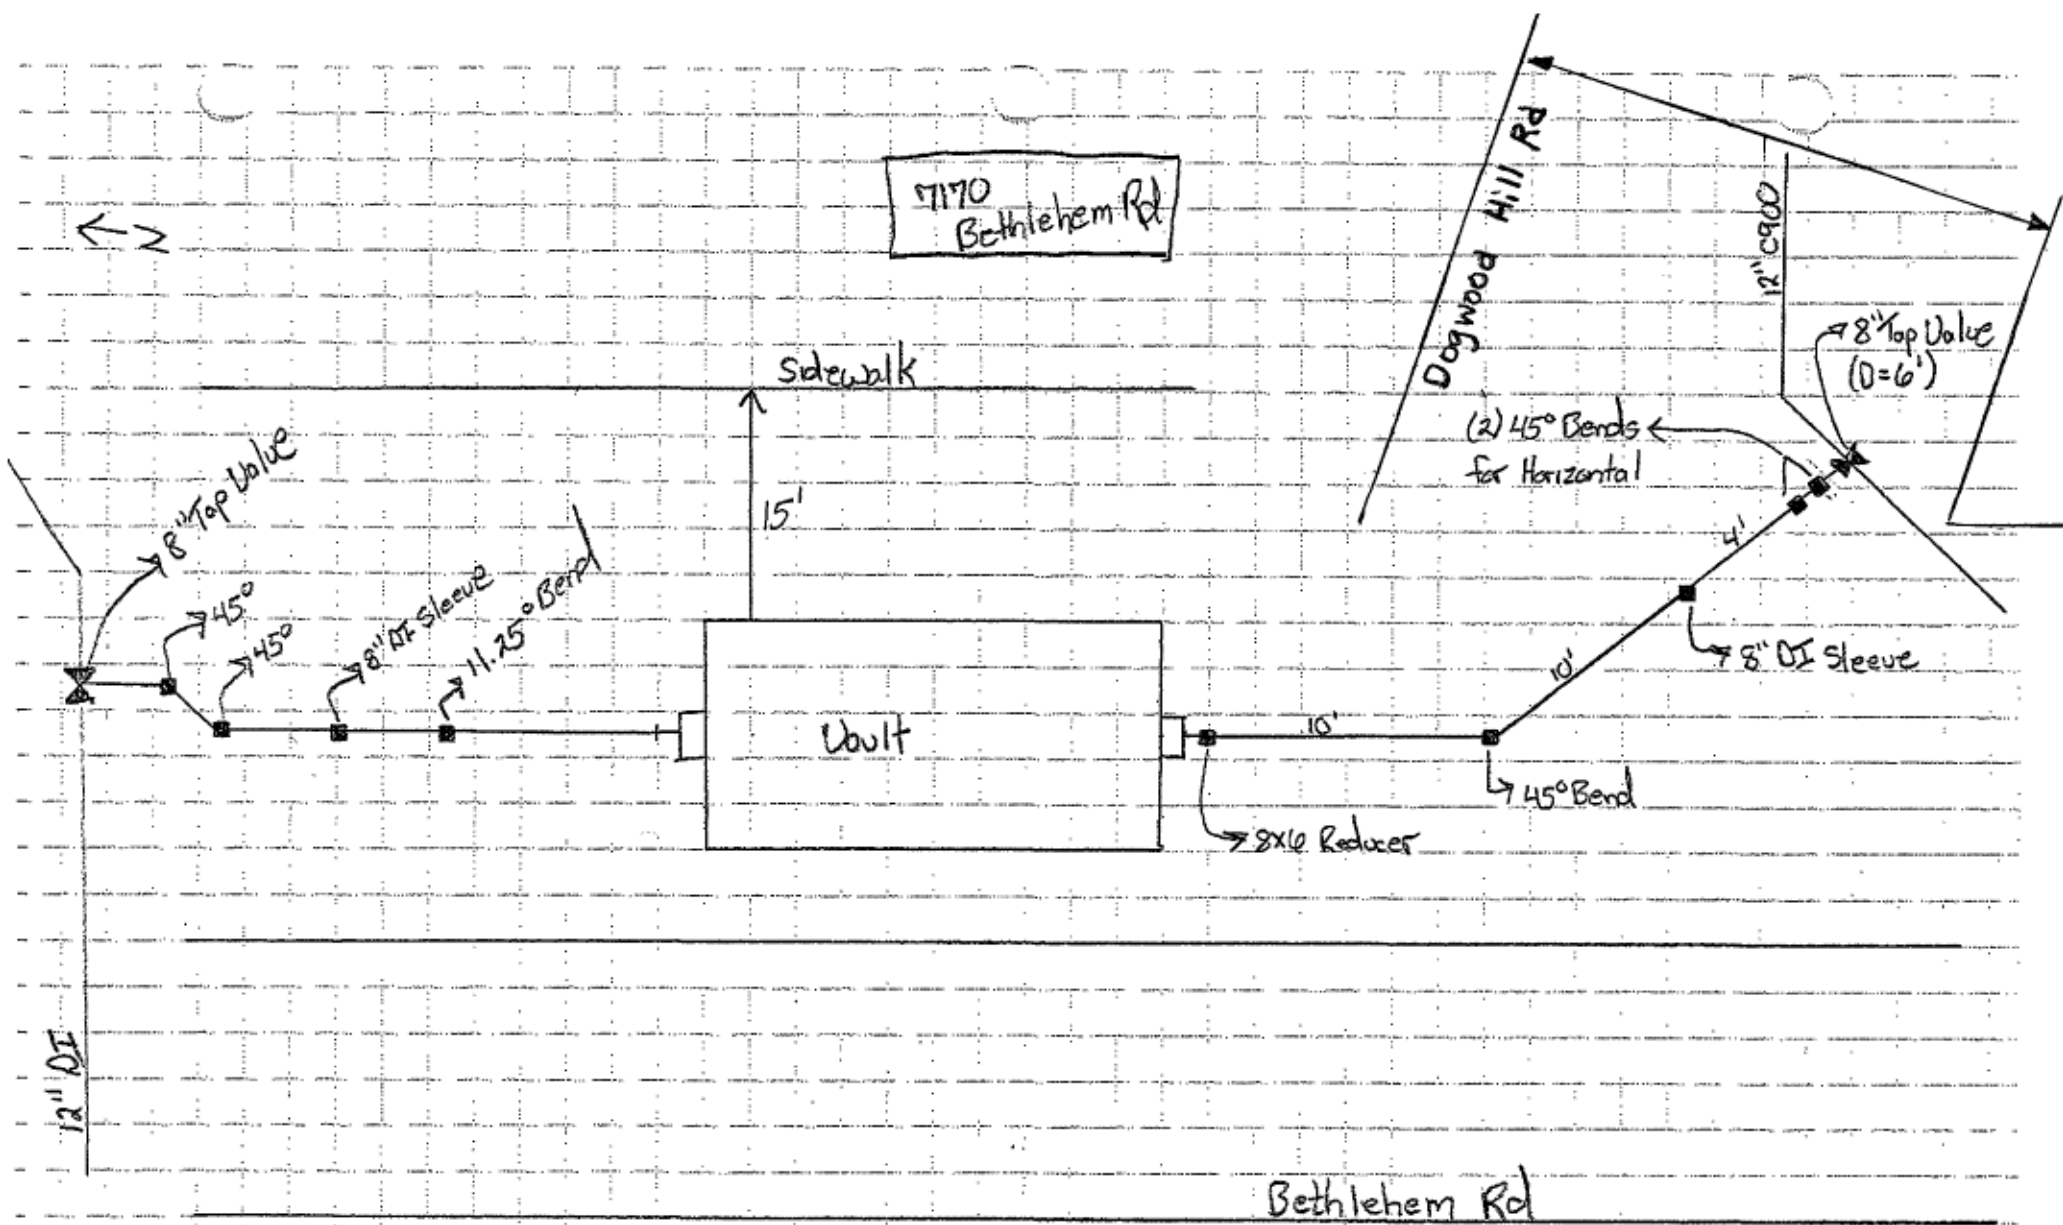

9/13/19
 Boones Mill Interconnection
 DETAIL
 SHEET 1 of 1