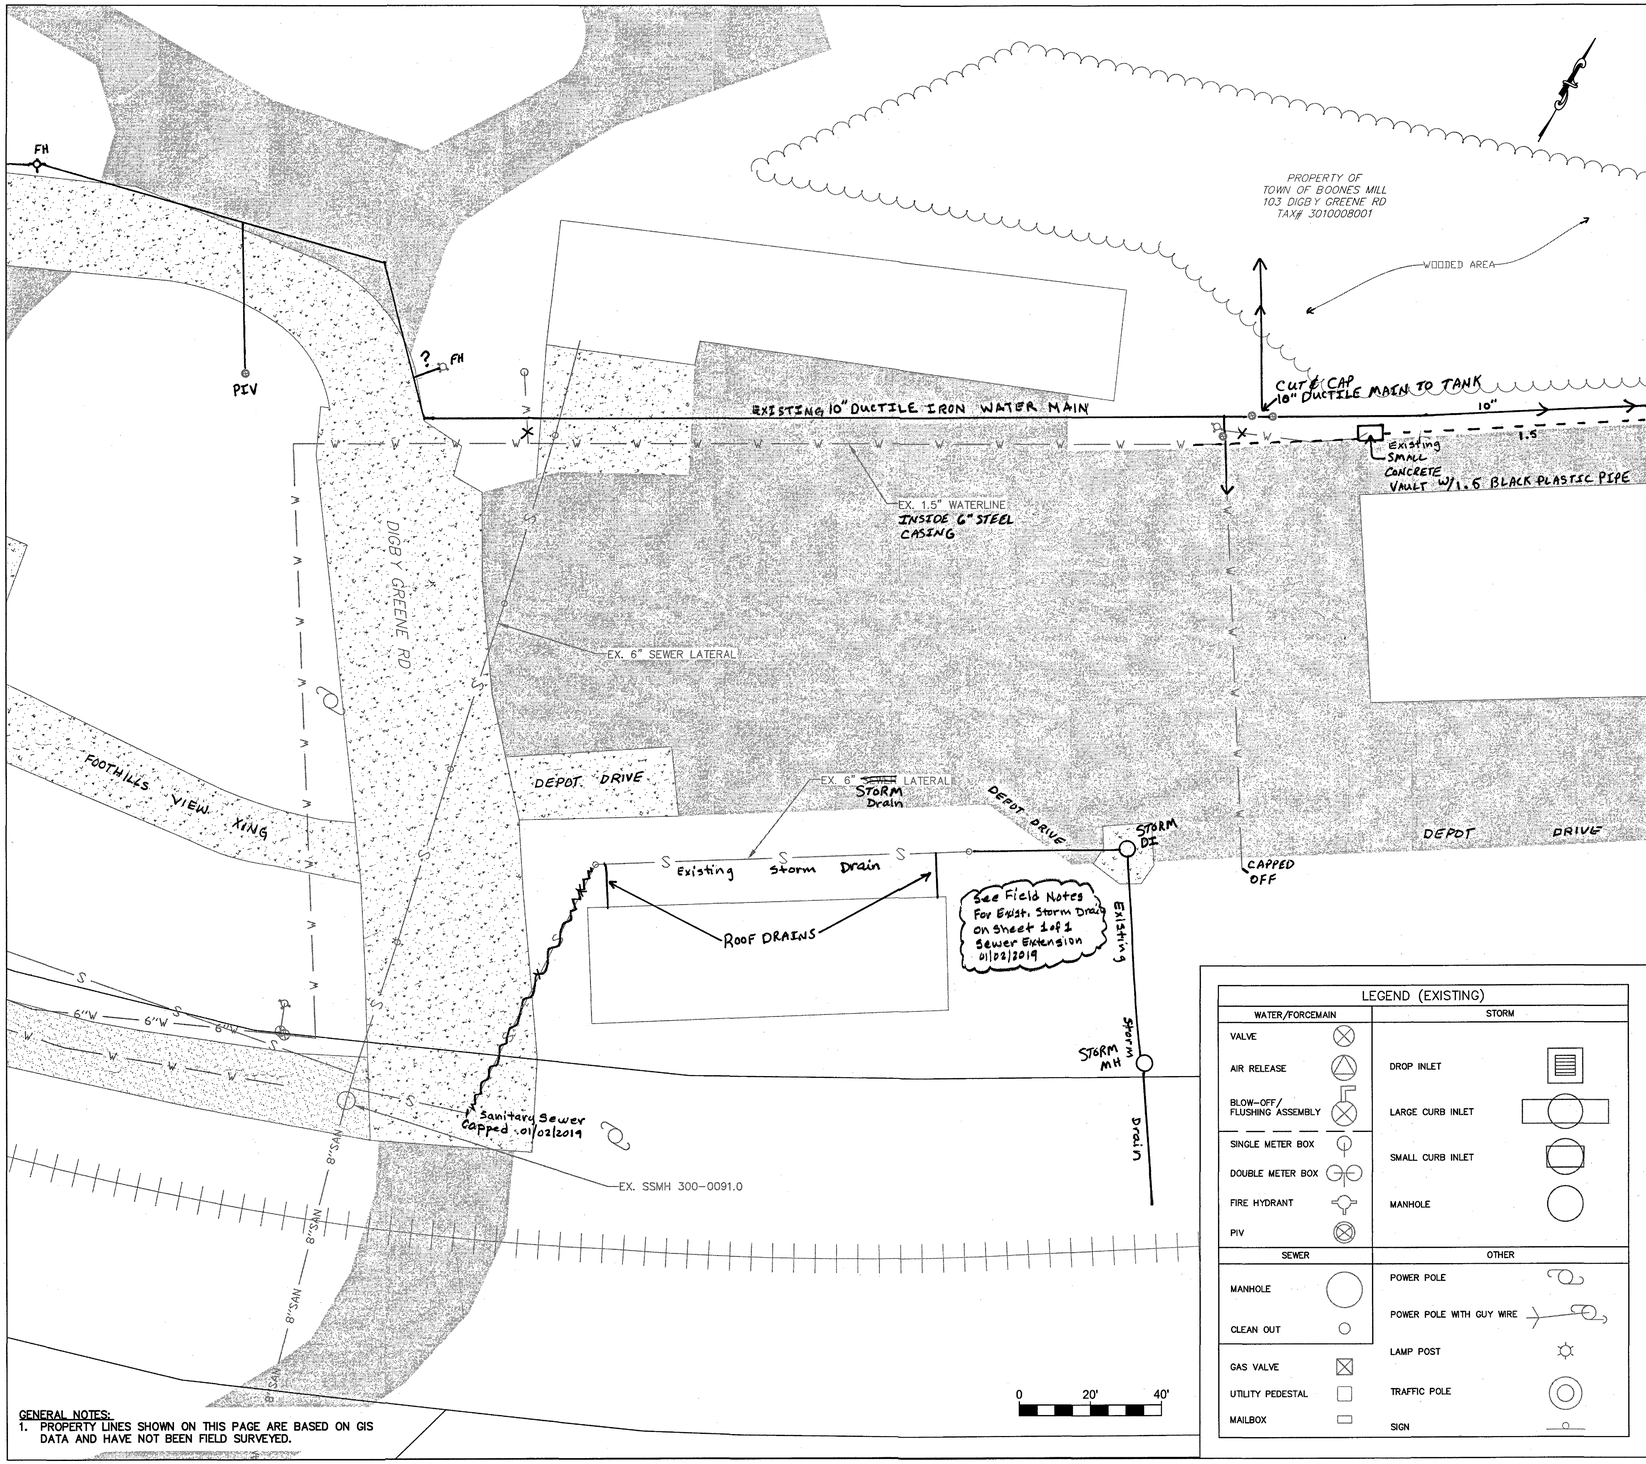

GENERAL NOTES:
1. PROPERTY LINES SHOWN ON THIS PAGE ARE BASED ON GIS DATA AND HAVE NOT BEEN FIELD SURVEYED.

LEGEND (EXISTING)

WATER/FORCEMAIN	STORM
VALVE	DROP INLET
AIR RELEASE	LARGE CURB INLET
BLOW-OFF/ FLUSHING ASSEMBLY	SMALL CURB INLET
SINGLE METER BOX	MANHOLE
DOUBLE METER BOX	
FIRE HYDRANT	
PIV	
SEWER	**OTHER**
MANHOLE	POWER POLE
CLEAN OUT	POWER POLE WITH GUY WIRE
GAS VALVE	LAMP POST
UTILITY PEDESTAL	TRAFFIC POLE
MAILBOX	SIGN

Project Name	
Contractor	
Construction Start Date	
Completion Date	
Sewer Gravity Main(s)	
Manufacturer	
Diameter	
Pipe Class	
Material	
Comments	
Sewer Gravity Lateral(s)	
Manufacturer	
Diameter	
Pipe Class	
Material	
Comments	
Sewer Manhole(s)	
Manufacturer	
Material	
Ring & Cover Manuf.	
Cover Type	
Comments	

Water and Storm Drain Information on this sheet are Field Located. No new utility as-builts.

SEE SHEET 2 of 2 FOR AS-BUILT PLAN

Project Name	
Install Contractor	WVWA CIP-1 BILLY THOMAS
Construction Start Date	11/26/2018
Completion Date	12/14/2018
Water Main(s)	
Manufacturer	
Diameter	10"
Pipe Class	
Material	DUCTILE
Comments	EXISTING 10" DUCTILE MAIN
Water Service(s)	
Manufacturer	U.S. PIPE
Diameter	6"
Pipe Class	350
Material	DUCTILE
Comments	FIRE SERVICE TO WAREHOUSE
Water Valve(s) 1	
Manufacturer	AMERICAN
Valve Type	GATE WET TAP
Diameter	6"
Direction to Open / Turns to Close	LH
Comments	FIRE SERVICE TO WAREHOUSE
Hydrant(s)	
Authority ID #	
Manufacturer	
Model	
Cast Date	
Static Pressure	
Comments	

WESTERN VIRGINIA WATER AUTHORITY
ENGINEERING SERVICES
601 S JEFFERSON ST, SUITE 300
ROANOKE, VA 24011
540-853-5700

TOWN OF BOONES MILL WATER ~~& SEWER~~ EXTENSION
Service Inst-1

BASEMAP

By	Date	Description	Rev

Designed:
Drawn: AJC
Checked: DRJ
Approved:
Date: DEC 2018
Project: PVT. MNT.

1
Sheet 1 of 2