


LEGEND (EXISTING)			
WATER/FORCEMAIN		STORM	
VALVE		DROP INLET	
AIR RELEASE		LARGE CURB INLET	
BLOW-OFF/FLUSHING ASSEMBLY		SMALL CURB INLET	
SINGLE METER BOX		MANHOLE	
DOUBLE METER BOX			
FIRE HYDRANT			
PIV			
SEWER		OTHER	
MANHOLE		POWER POLE	
CLEAN OUT		POWER POLE WITH GUY WIRE	
GAS VALVE		LAMP POST	
UTILITY PEDESTAL		TRAFFIC POLE	
MAILBOX		SIGN	

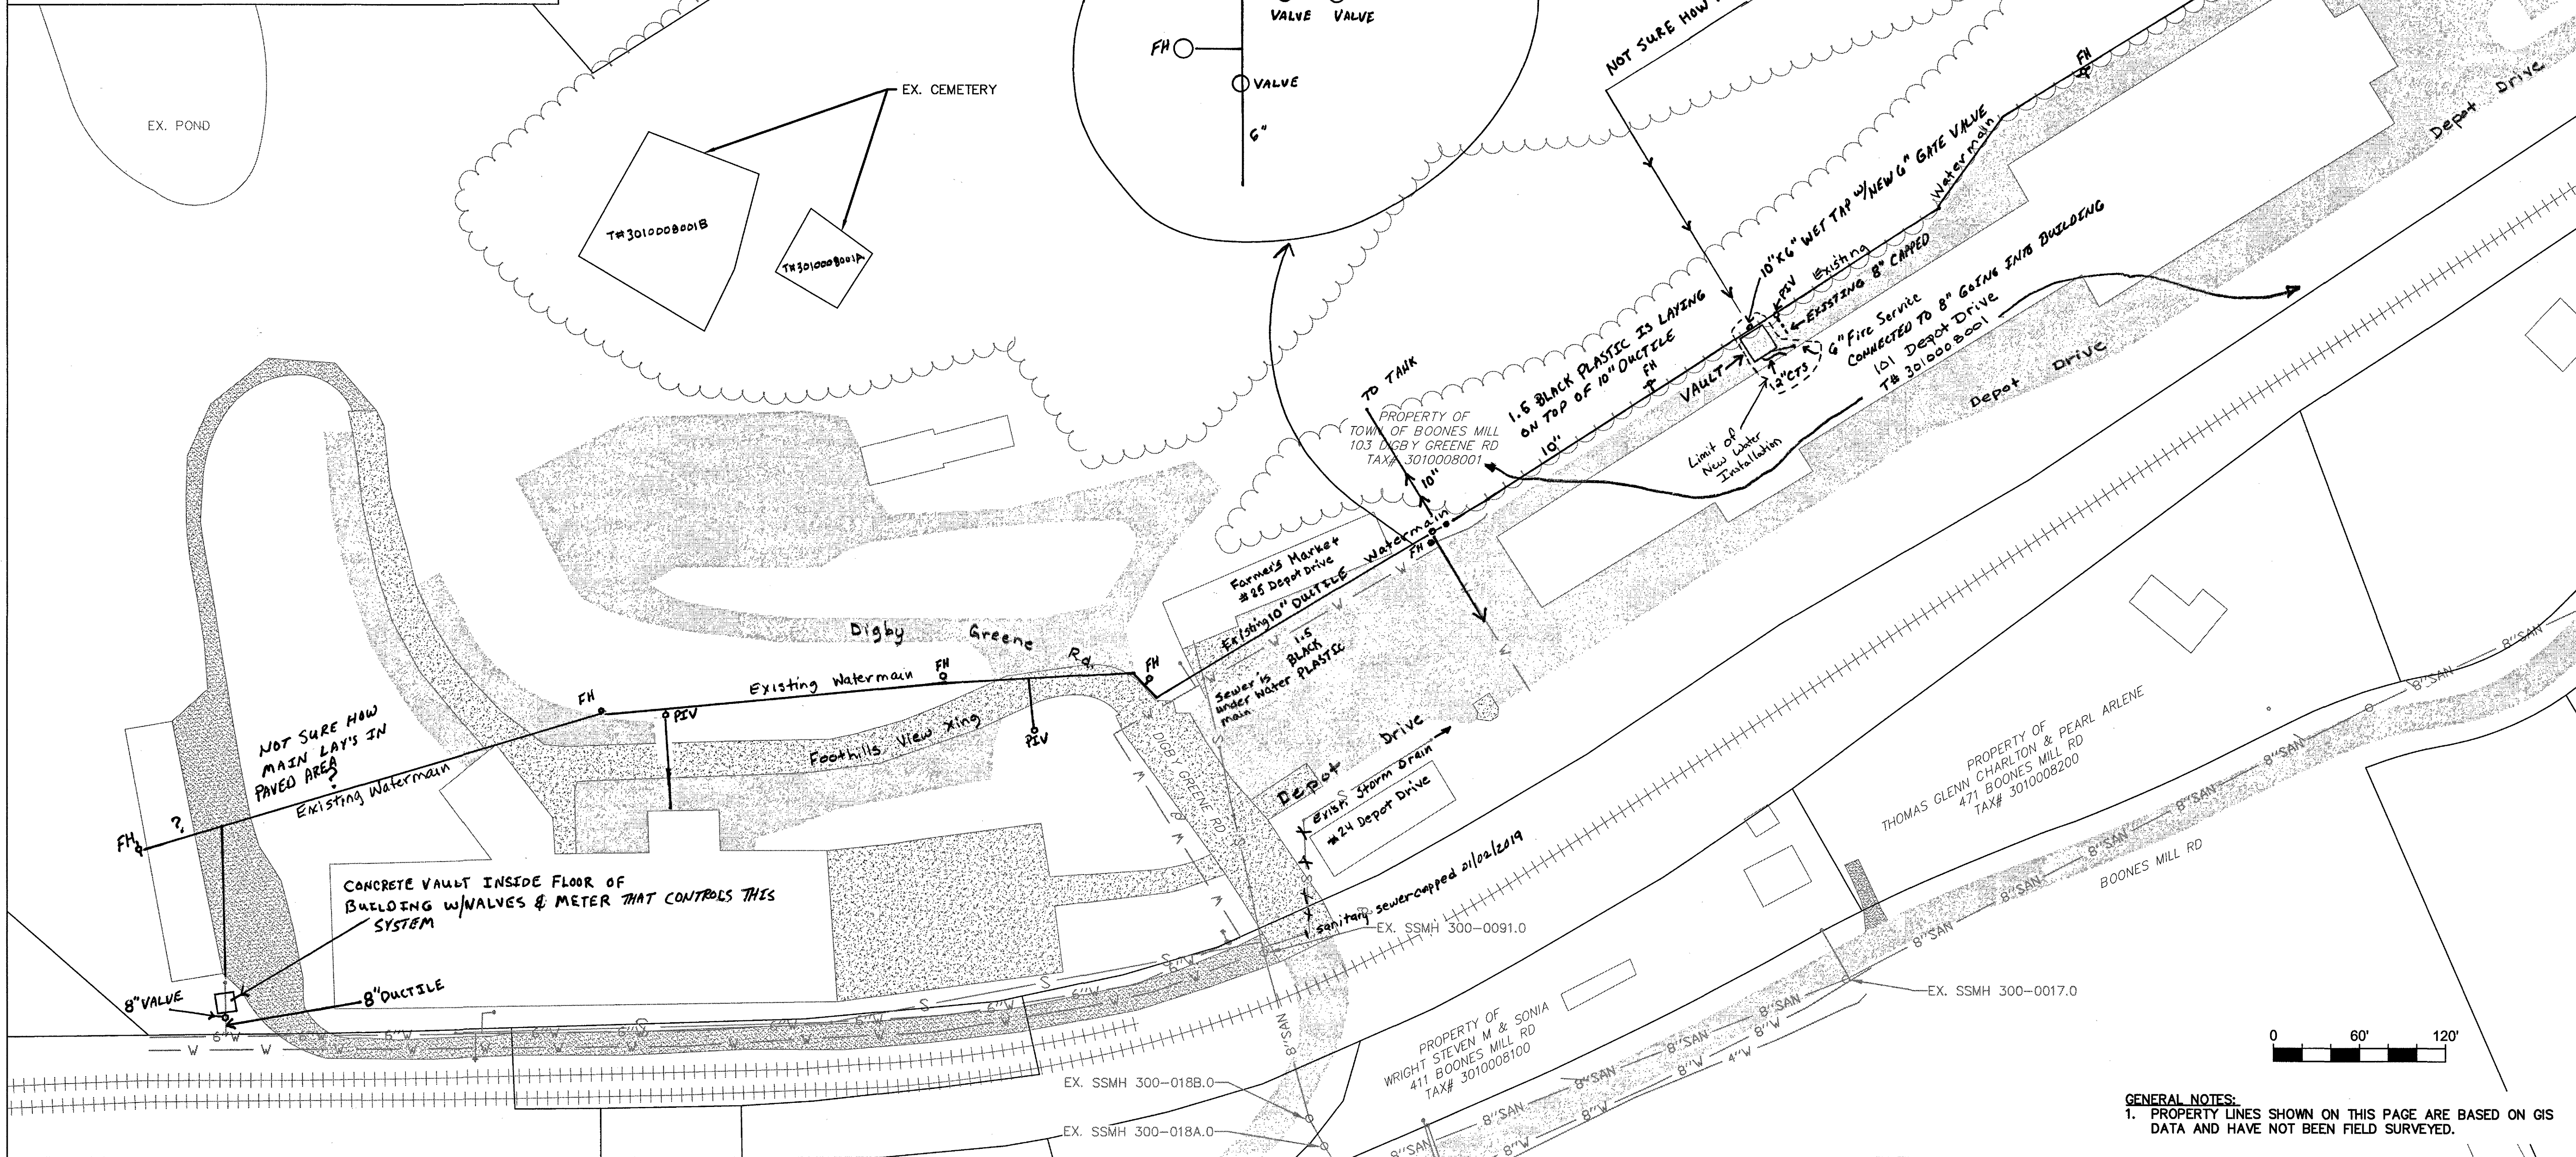

WESTERN VIRGINIA

WATER AUTHORITY

ENGINEERING SERVICES
601 S JEFFERSON ST, SUITE 300
ROANOKE, VA 24011
540-853-5700

TOWN OF BOONES MILL

WATER & SEWER EXTENSION

Service Initial for 101 Depot Dr.
Rest of water shown is existing and located in the field.

BASEMAP

Rev	Description	Date	By

Designed:	
Drawn:	AJC
Checked:	DRJ
Approved:	
Date:	DEC 2018
Project:	PVT. MNT.

GENERAL NOTES:
1. PROPERTY LINES SHOWN ON THIS PAGE ARE BASED ON GIS DATA AND HAVE NOT BEEN FIELD SURVEYED.