



PLAN	DATE	BY
SURVEYED		
NOTE BOOK		
ALIGNMENT CHECKED		
RT. OF WAY CHECKED		
NO.		

PROFILE	DATE	BY
SURVEYED		
NOTE BOOK		
GRADES CHECKED		
VERT. OF WAY CHECKED		
NO.		

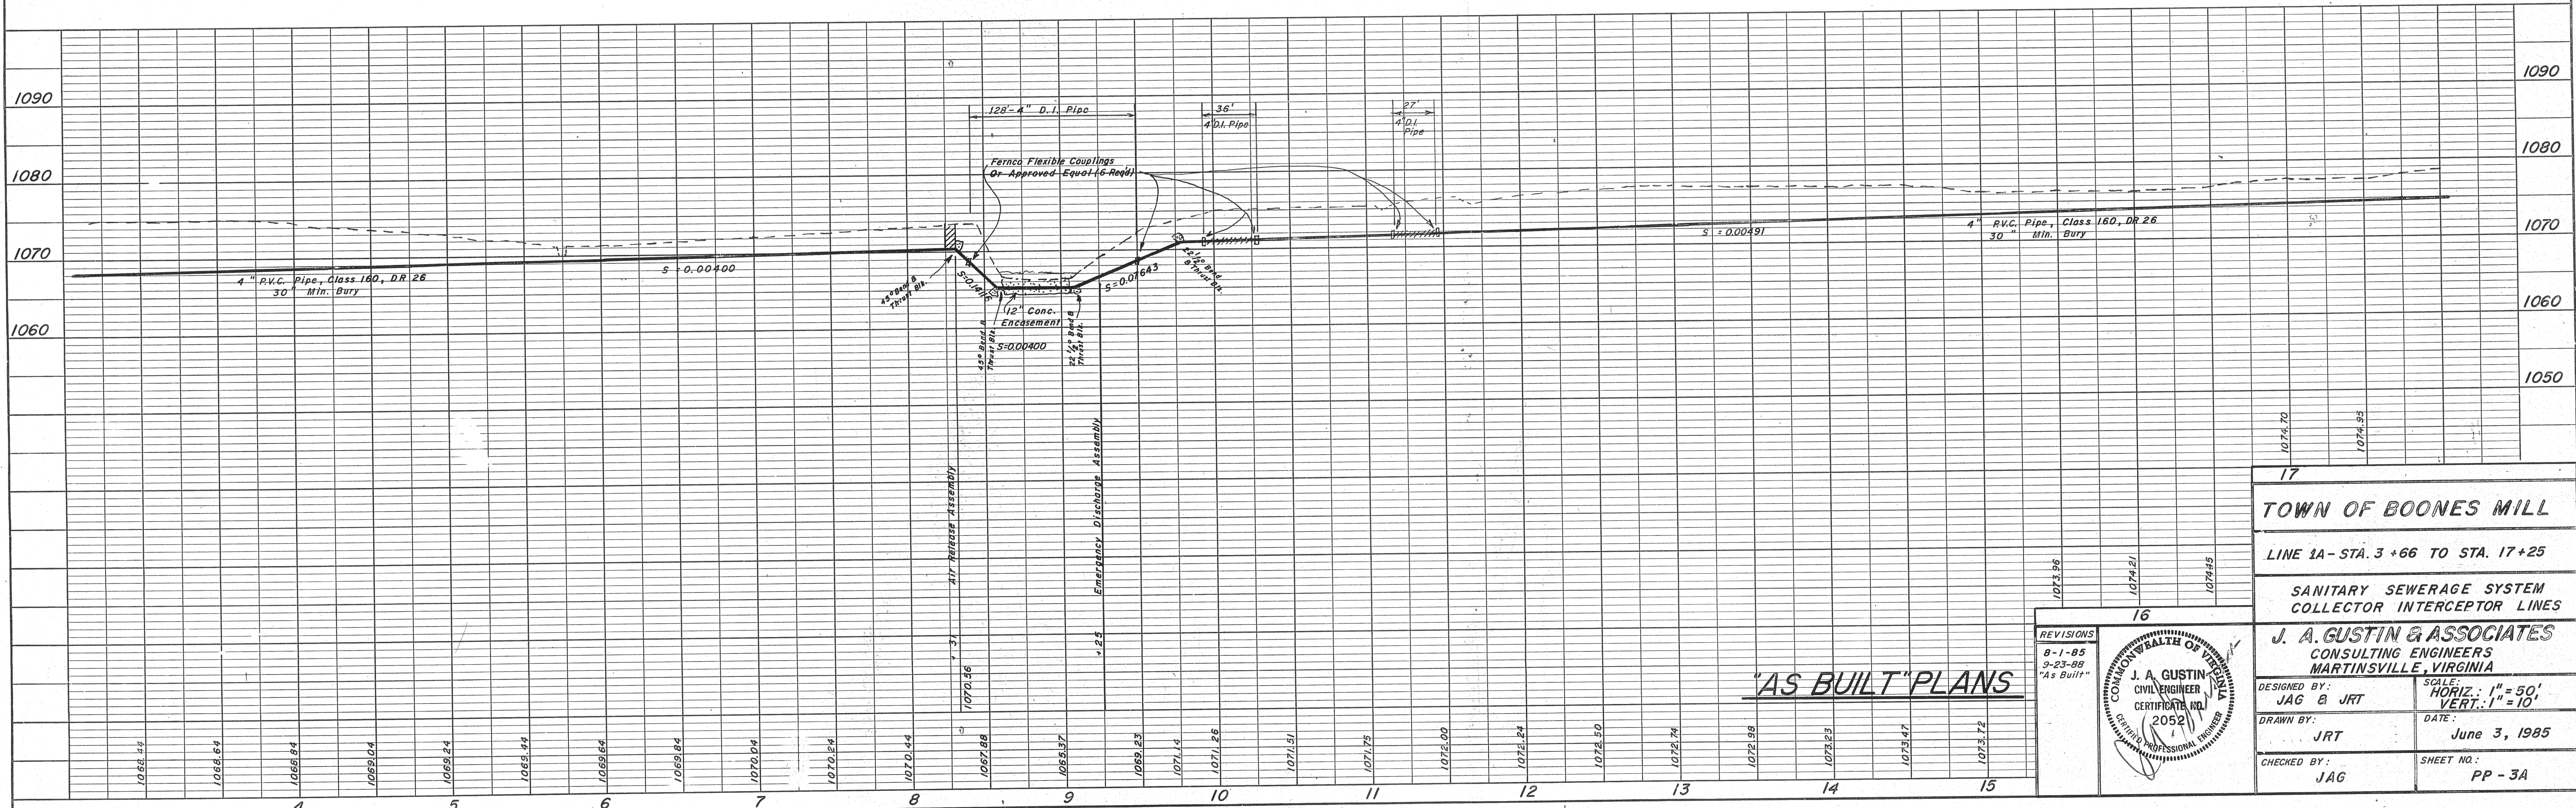

TOWN OF BOONES MILL	
LINE 1A - STA. 3 +66 TO STA. 17 +25	
SANITARY SEWERAGE SYSTEM COLLECTOR INTERCEPTOR LINES	
J. A. GUSTIN & ASSOCIATES CONSULTING ENGINEERS MARTINSVILLE, VIRGINIA	
DESIGNED BY: JAG & JRT	SCALE: HORIZ.: 1" = 50' VERT.: 1" = 10'
DRAWN BY: JRT	DATE: June 3, 1985
CHECKED BY: JAG	SHEET NO.: PP - 3A

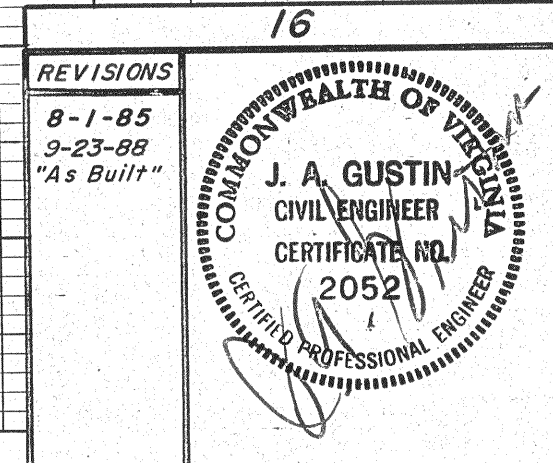

