


PLAN	DATE	BY	DATE
SURVEYED			
NOTED			
NOTE BOOK			
No.			

PROFILE	DATE	BY	DATE
SURVEYED			
NOTED			
NOTE BOOK			
No.			

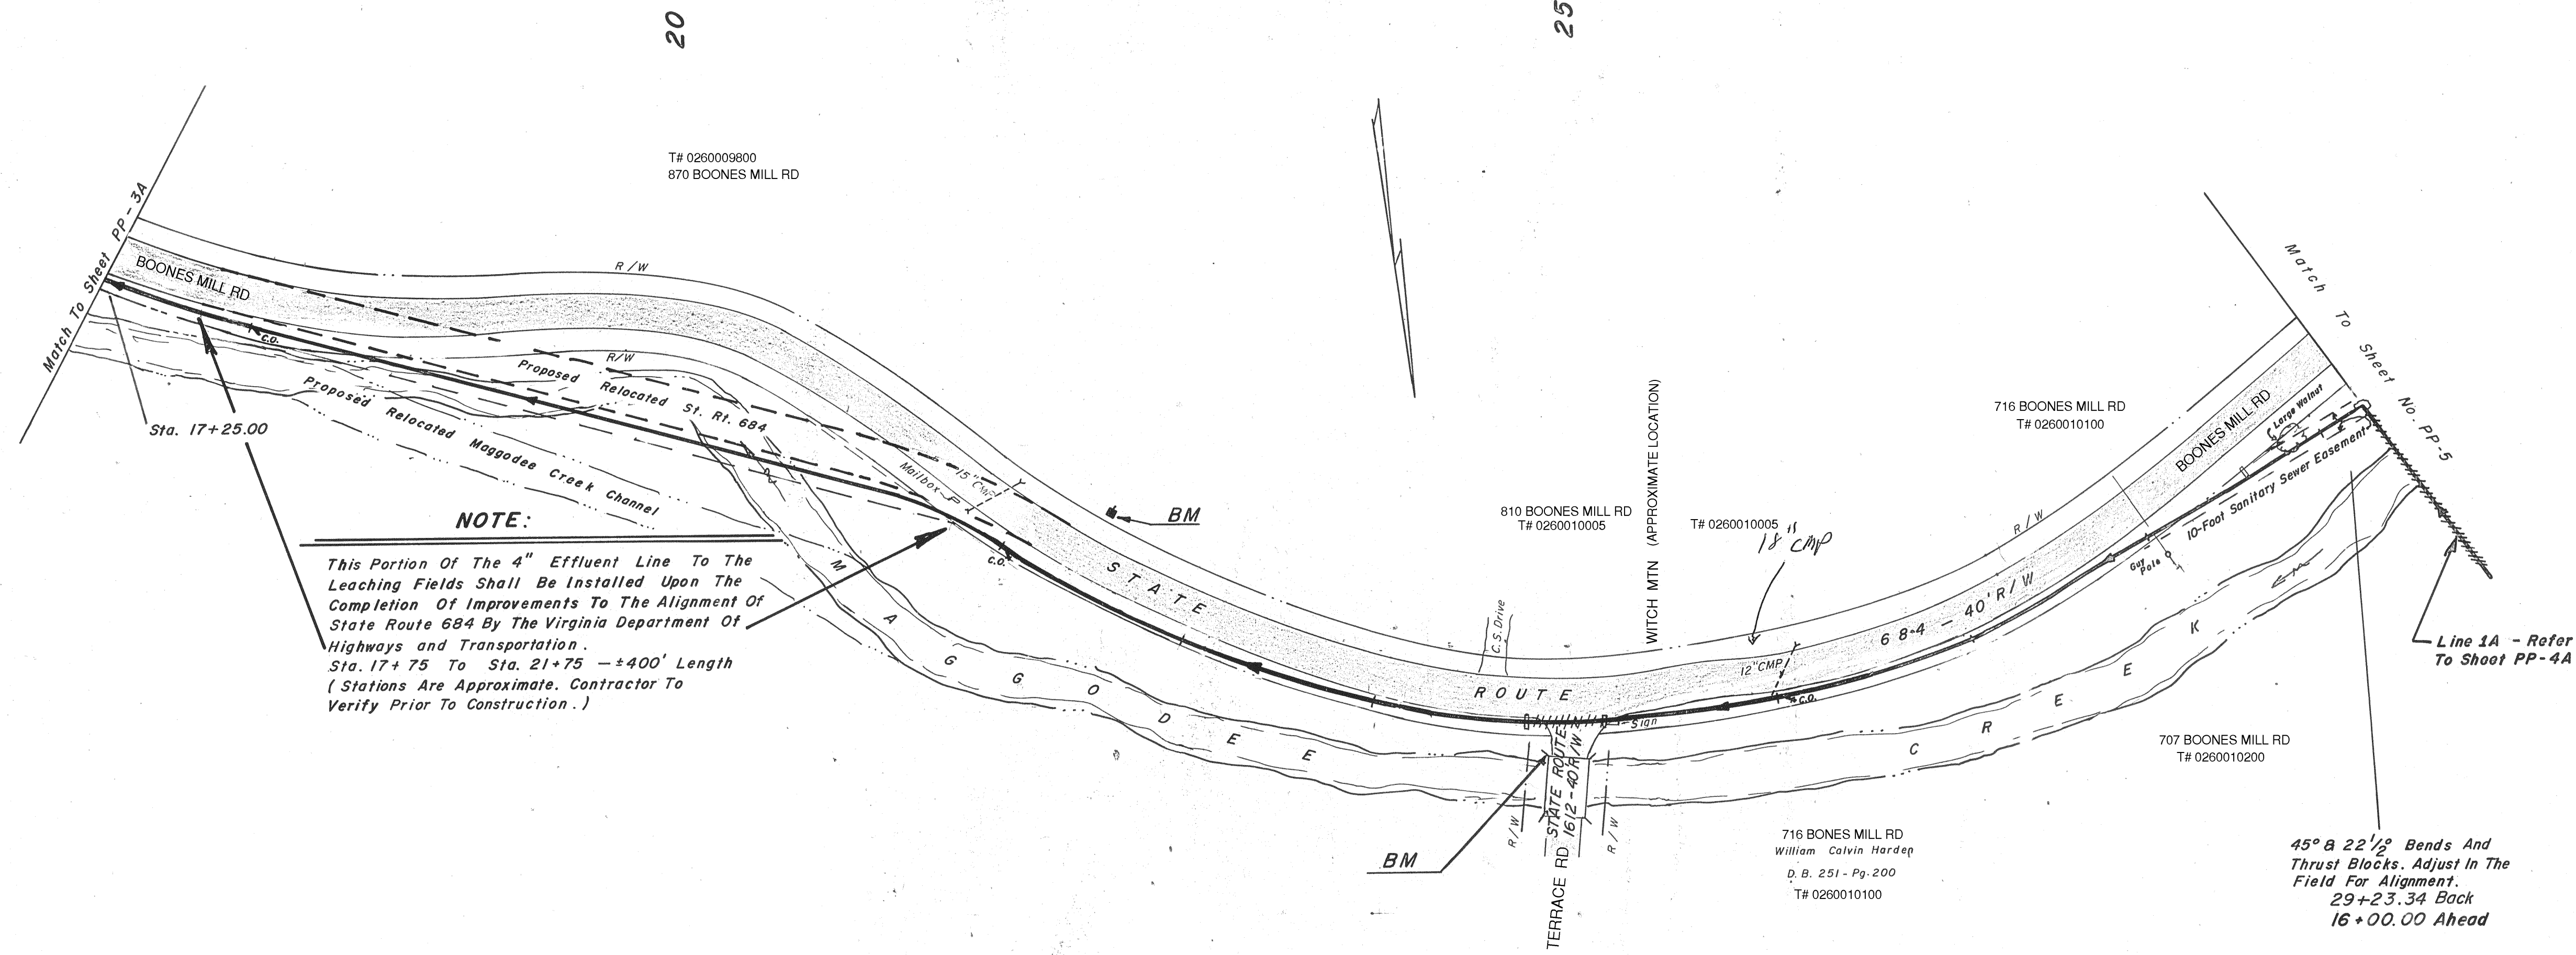

09/11/2018 - NEW INFO ADDED

