NOTE:

TC = Central Telephone Company's Toll Cable

It Shall Be The Contractor's Responsibility To Make The Necessary Arrangements With Central Telephone Company Of Virginia To Have One Of Their Representatives At The Project Site During Any Excavation Or Blasting, If Necessary, In Close Proximity To The Telephone Cable.

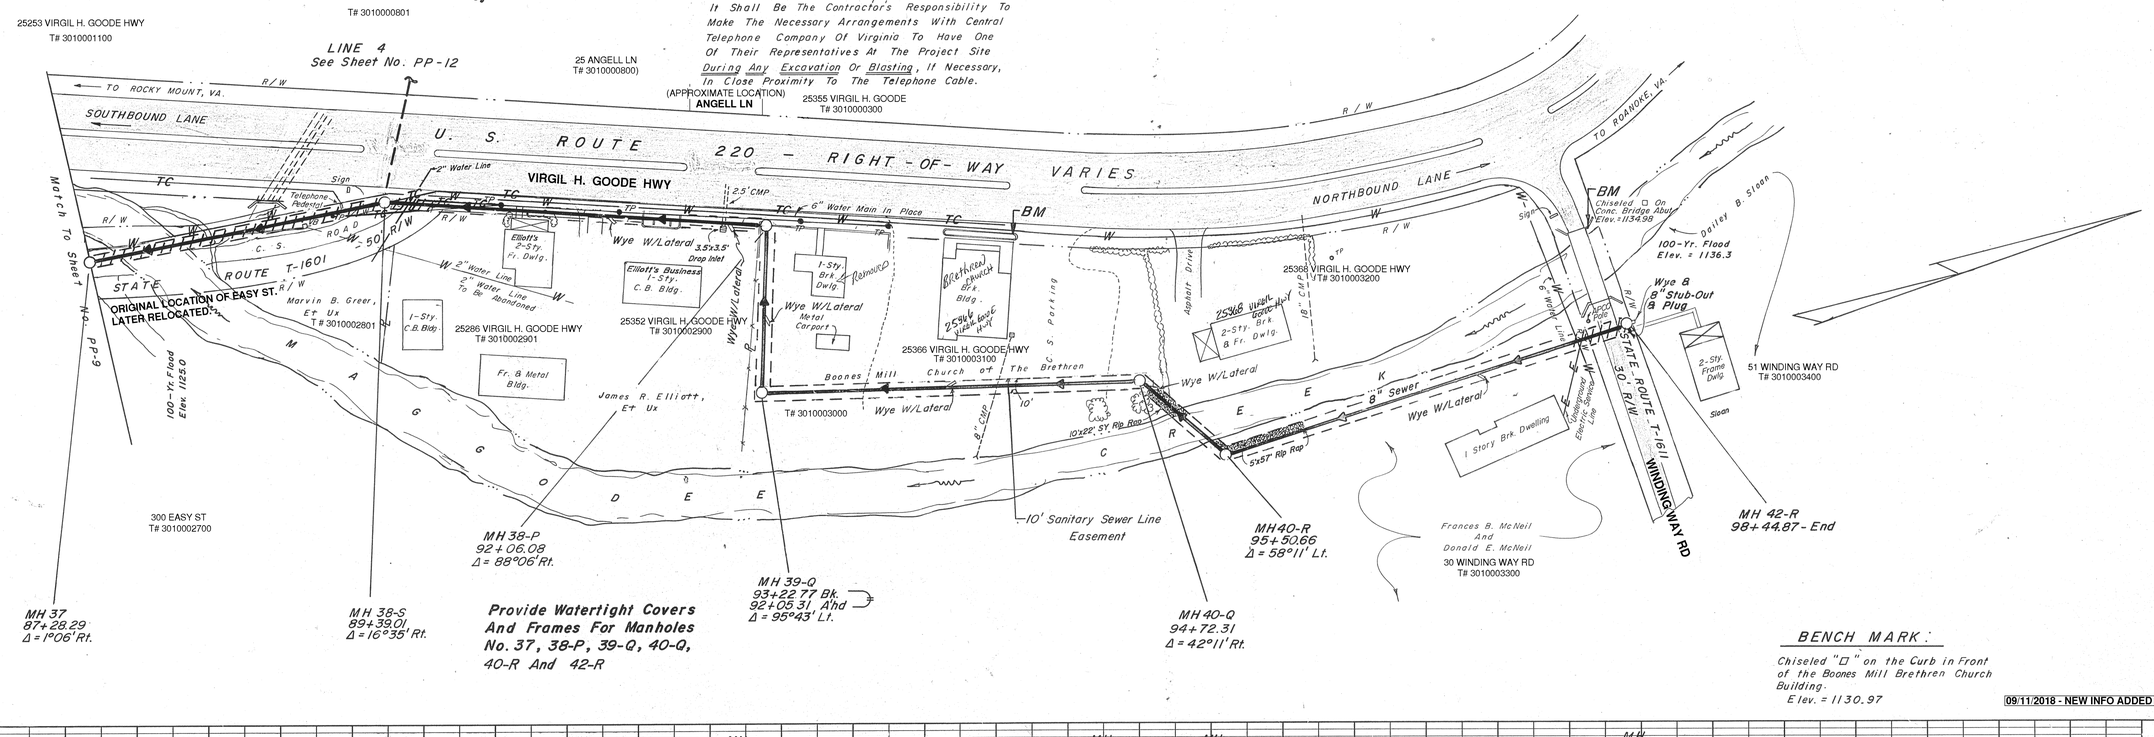

Provide Watertight Covers And Frames For Manholes No. 37, 38-P, 39-Q, 40-Q, 40-R And 42-R

BENCH MARK:

Chiseled "□" on the Curb in Front of the Boones Mill Brethren Church Building.
Elev. = 1130.97

09/11/2018 - NEW INFO ADDED

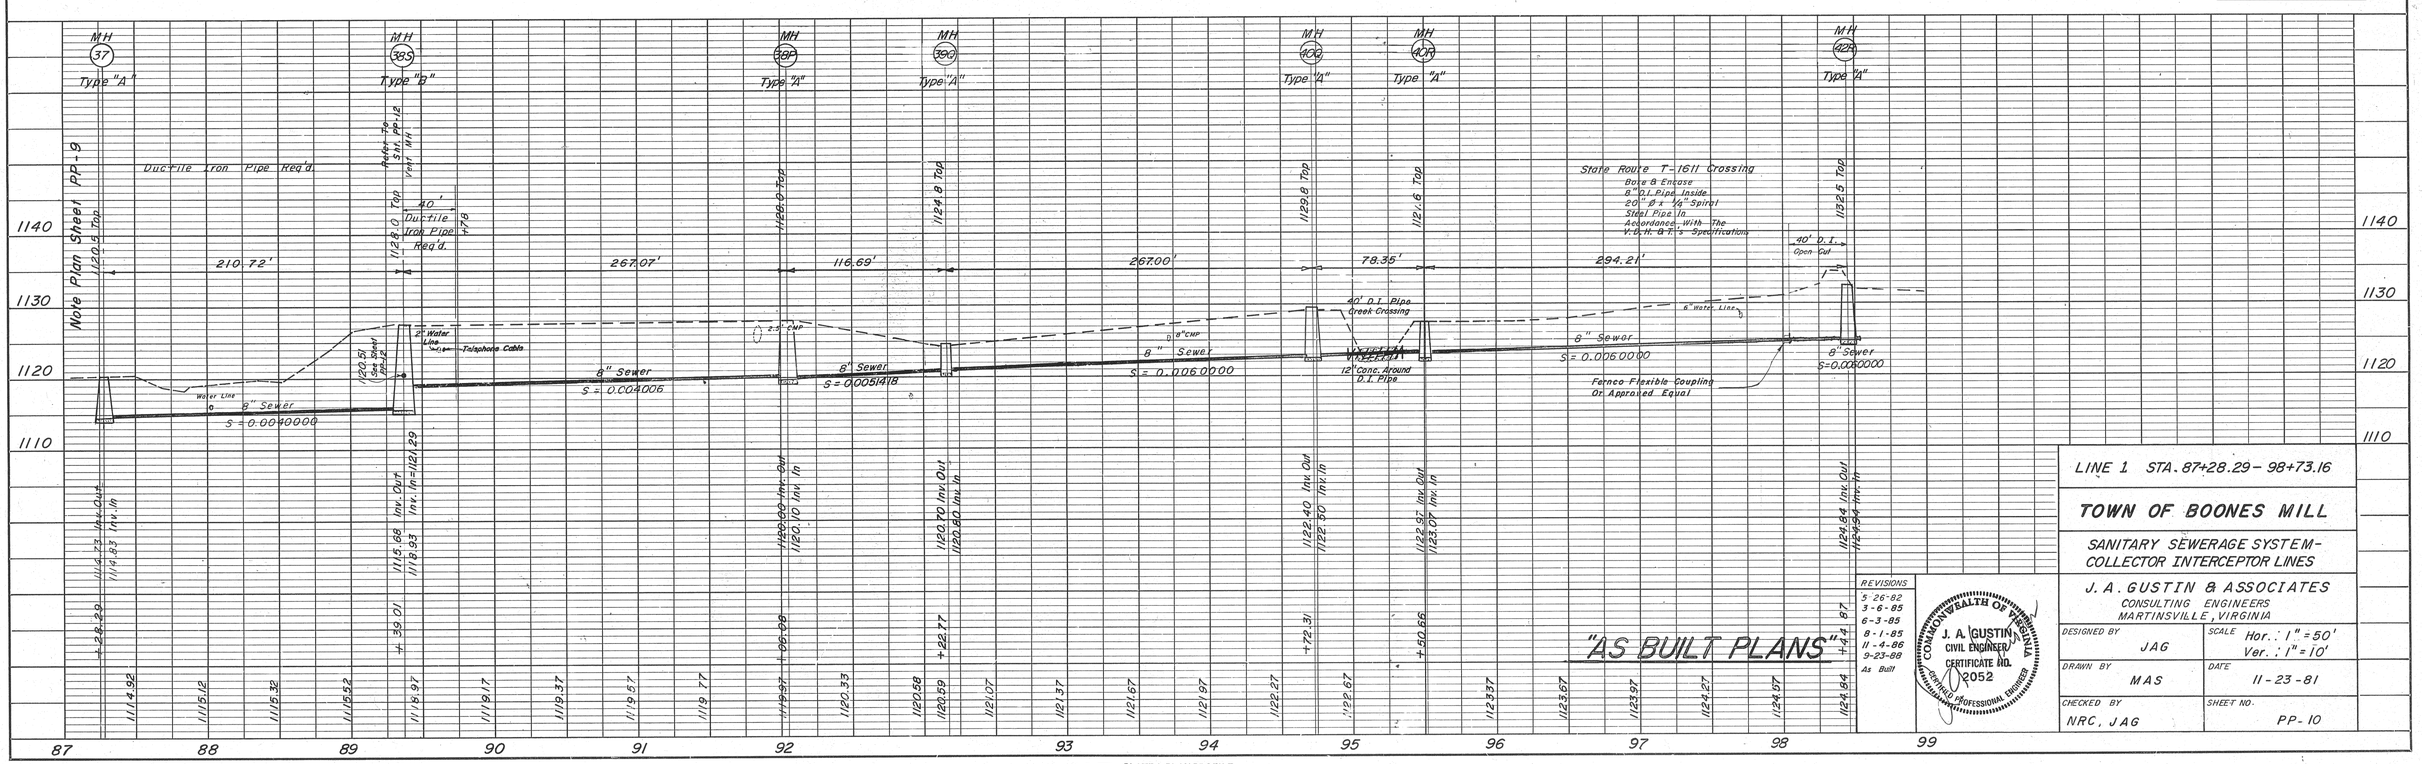

LINE 1 STA. 87+28.29 - 98+73.16

TOWN OF BOONES MILL

SANITARY SEWERAGE SYSTEM-
COLLECTOR INTERCEPTOR LINES

J. A. GUSTIN & ASSOCIATES
CONSULTING ENGINEERS
MARTINSVILLE, VIRGINIA

REVISIONS
5-26-82
3-6-85
6-3-85
8-1-85
11-4-86
9-23-88
As Built

"AS BUILT PLANS"

COMMONWEALTH OF VIRGINIA
J. A. GUSTIN
CIVIL ENGINEER
CERTIFICATE NO. 2052
CERTIFIED PROFESSIONAL ENGINEER

DESIGNED BY JAG	SCALE Hor.: 1" = 50' Ver.: 1" = 10'
DRAWN BY MAS	DATE 11-23-81
CHECKED BY NRC, JAG	SHEET NO. PP-10

NOTE BOOK ALIGNMENT CHECKED... RT.-OF-WAY CHECKED... No.

NOTE BOOK GRADES CHECKED... B. M.'s NOTED... STRUCTURE EXCAVATIONS CHECKED... No.

PLATE 1, PLAN-PROFILE
KEUFFEL & ESSER CO.
437024 MADE IN U.S.A.