
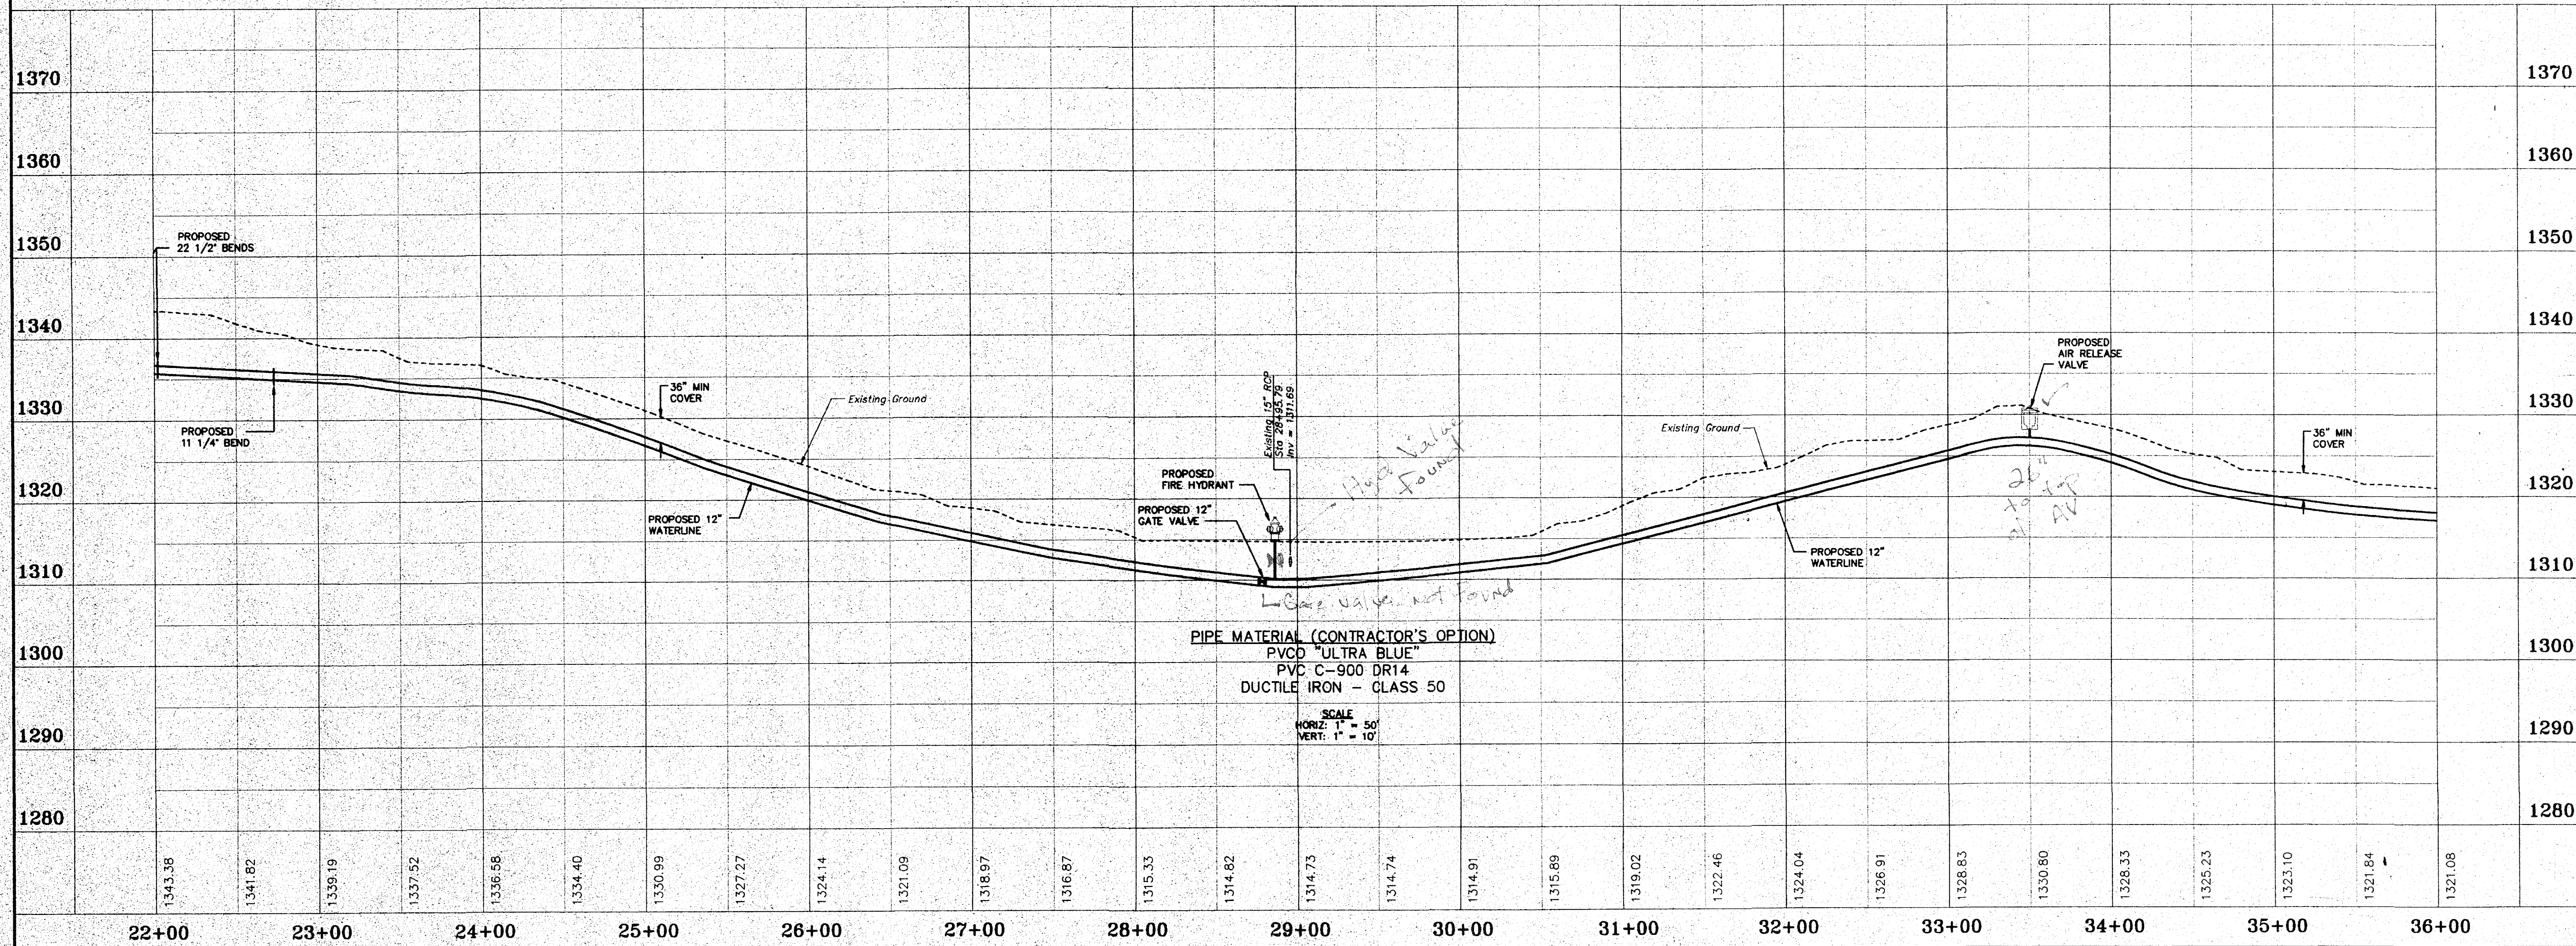


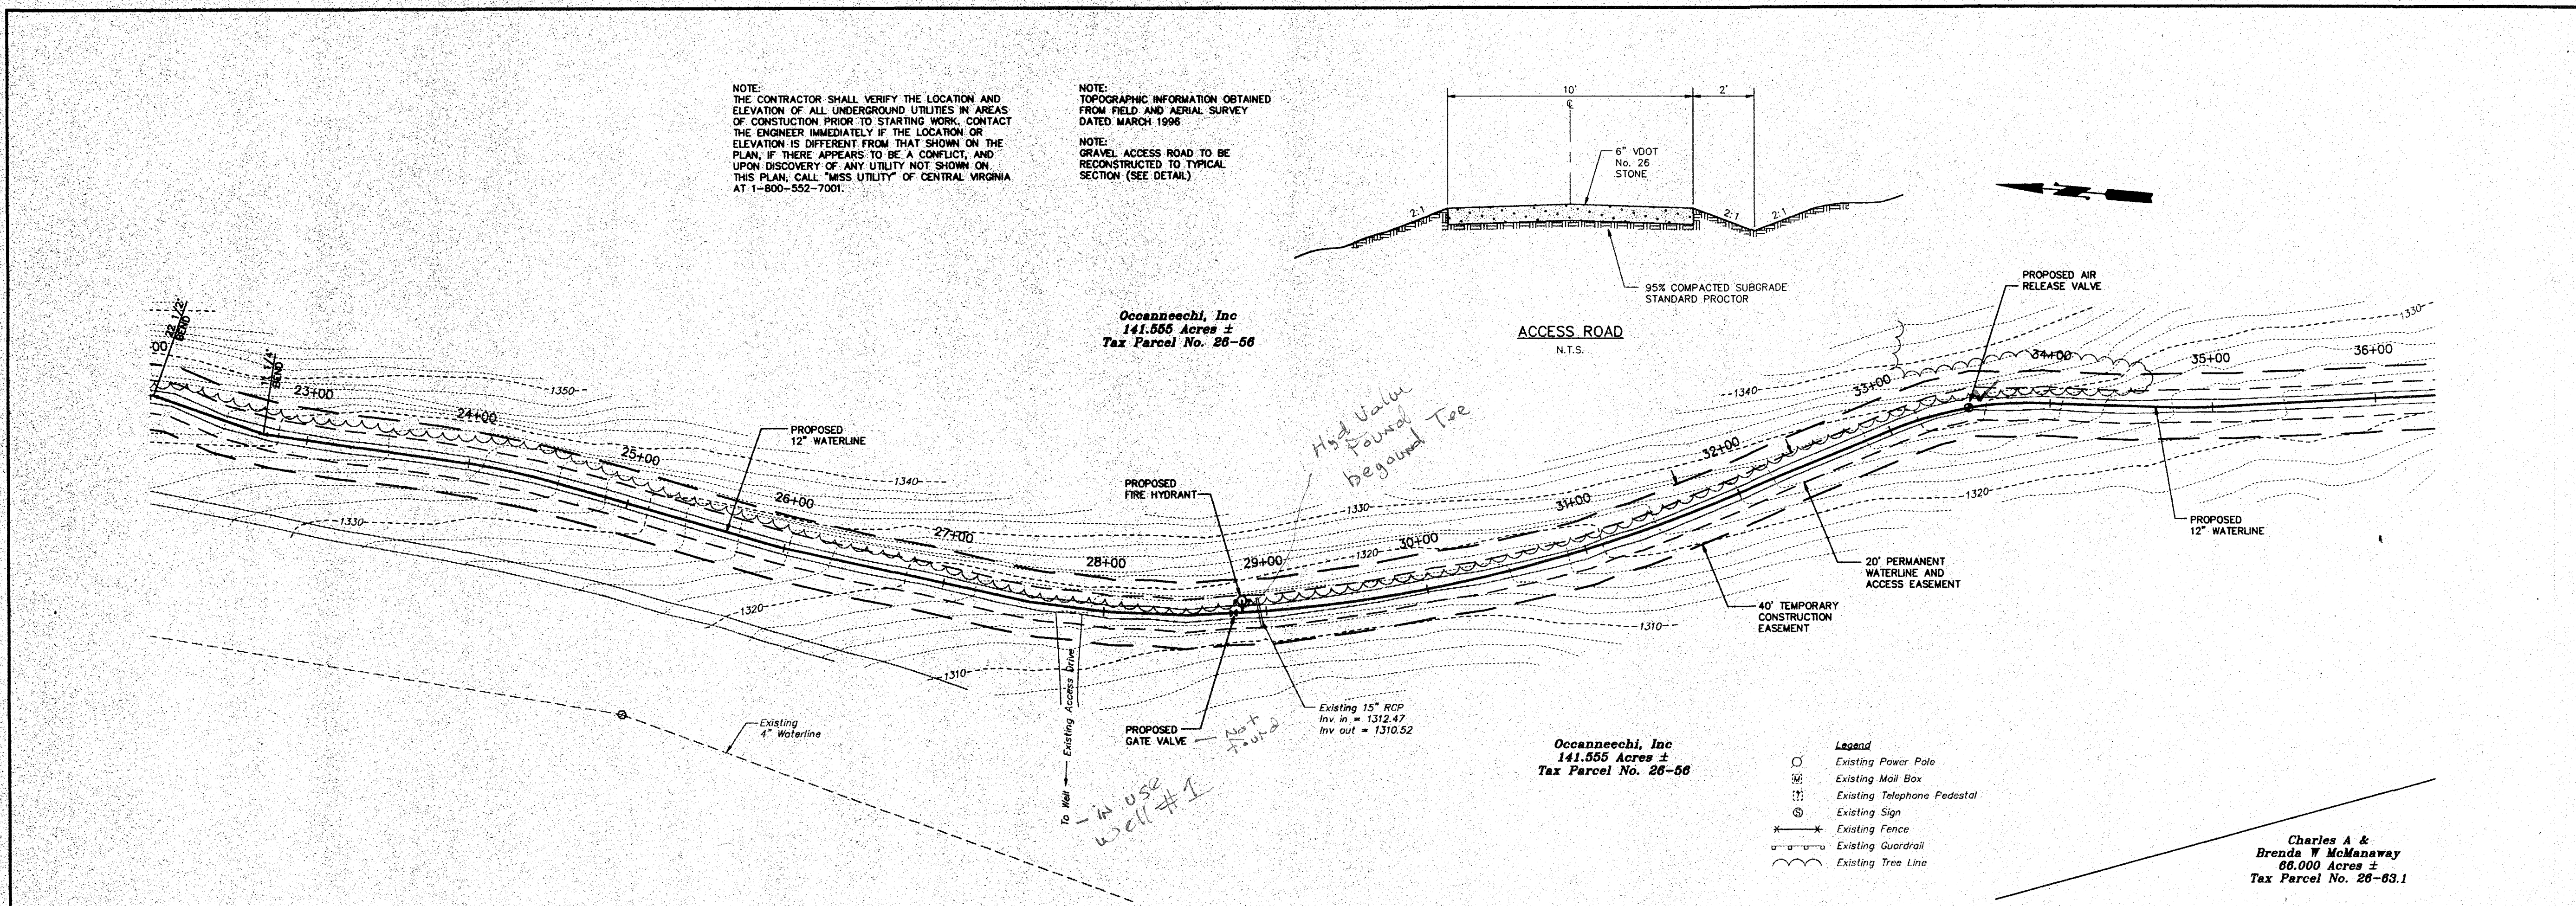

DATE	09/18/96
REVISIONS	1 ADJUST NOTES
SCALE: 1" = 50'	DRAWN BY: MMB
JOB No.: 960210	CHKD: ROL
ACAD #: RCP02033	

-LANG-
engineering co.
Consulting Engineers - Land Planners
P.O. BOX 7566 ROANOKE, VA 24019 (540)366-4800

**WATERLINE EXTENSION
WATER SUPPLY PROJECT CIG95-32
TOWN OF BOONES MILL
FRANKLIN COUNTY, VIRGINIA**

SHEET NO. 4
13 OF