


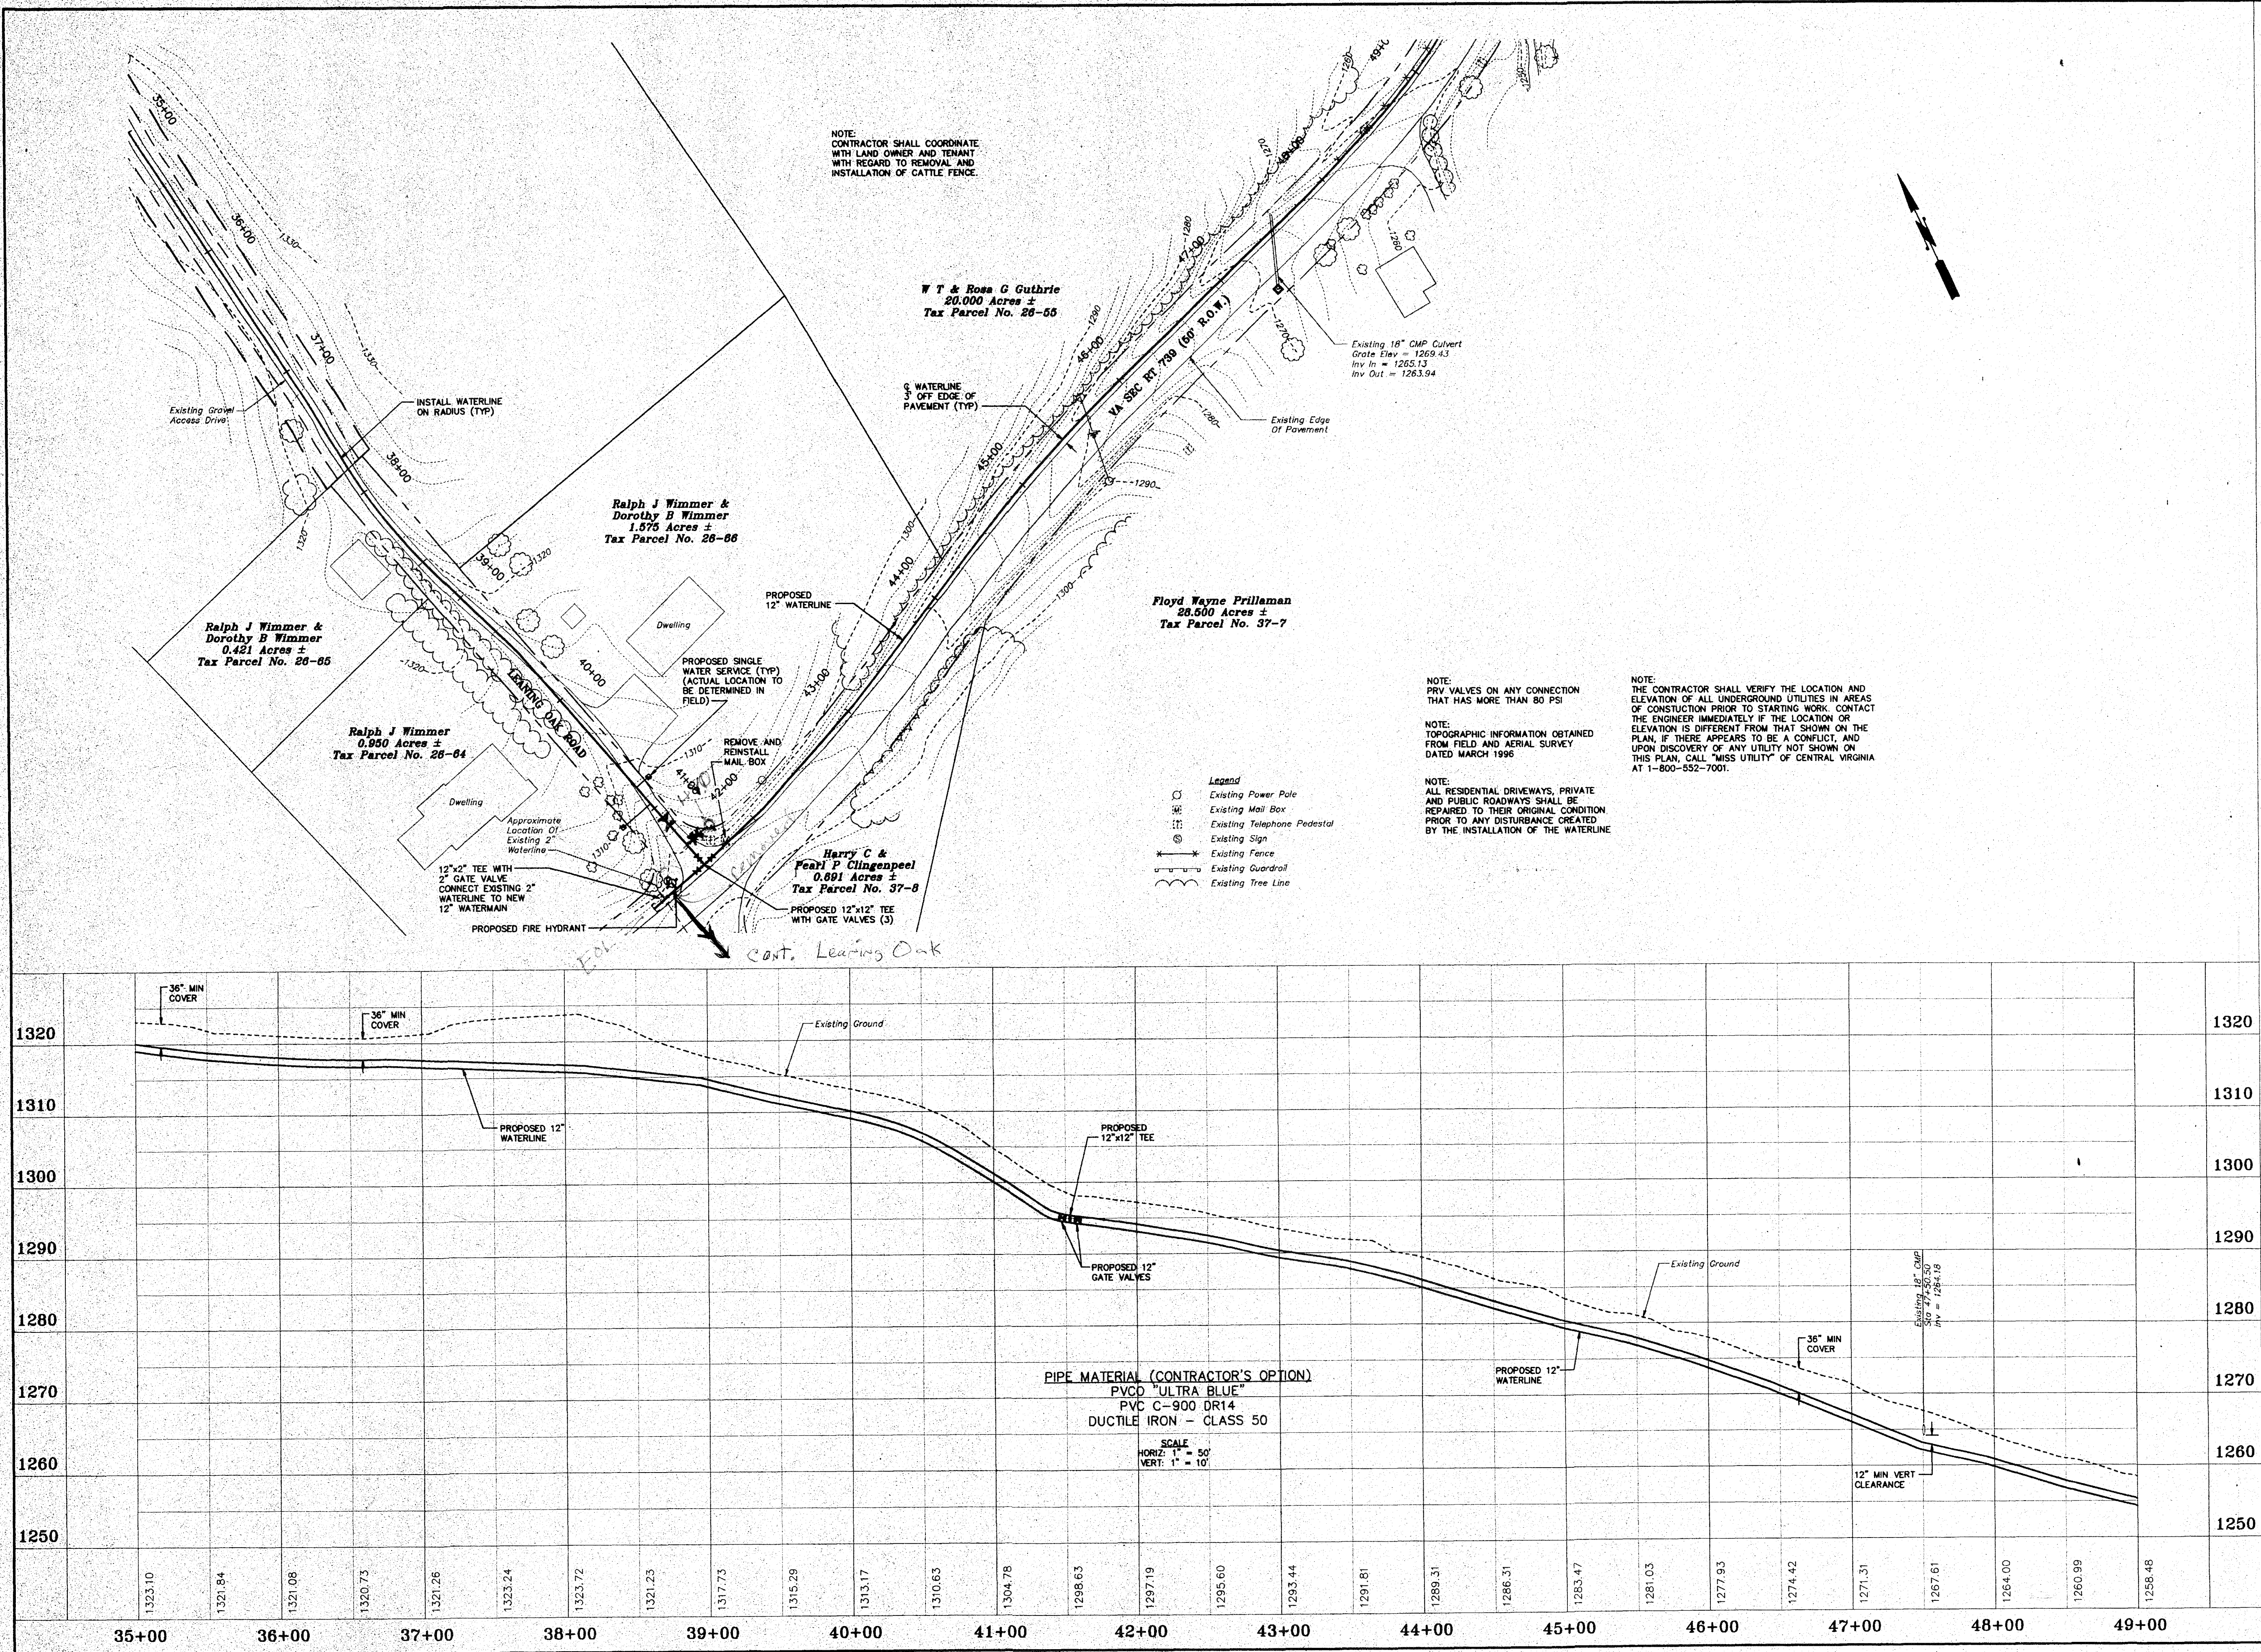

|           |                |
|-----------|----------------|
| DATE      | 09/18/96       |
| REVISIONS | 1 ADJUST NOTES |
| 2         |                |
| 3         |                |
| 4         |                |
| 5         |                |
| 6         |                |

DATE: JUNE 19, 1996  
JOB No.: 960210  
ACAD # RCP03033

SCALE: 1" = 50'  
DRAWN BY: MMB  
CHKD: RGL

0 25 50 100 200

**-LANG-**  
engineering co.  
Consulting Engineers - Land Planners  
P.O. BOX 7566 ROANOKE, VA 24019 (540)366-4800

WATERLINE EXTENSION  
WATER SUPPLY PROJECT CIG95-32  
TOWN OF BOONES MILL  
FRANKLIN COUNTY, VIRGINIA

SHEET NO.  
13  
OF