NOTE:
PRV VALVES ON ANY CONNECTION THAT HAS MORE THAN 80 PSI

NOTE:
TOPOGRAPHIC INFORMATION OBTAINED FROM FIELD AND AERIAL SURVEY DATED MARCH 1996

NOTE:
ALL RESIDENTIAL DRIVEWAYS, PRIVATE AND PUBLIC ROADWAYS SHALL BE REPAIRED TO THEIR ORIGINAL CONDITION PRIOR TO ANY DISTURBANCE CREATED BY THE INSTALLATION OF THE WATERLINE

NOTE:
CONTRACTOR SHALL COORDINATE WITH LAND OWNER AND TENANT WITH REGARD TO REMOVAL AND INSTALLATION OF CATTLE FENCE.

NOTE:
CONTRACTOR TO INSTALL TEMPORARY BARRICADE ACROSS EXISTING BOX CULVERT TO RESTRICT MOVEMENT OF CATTLE FROM PROPERTY OF F.W. PRILLAMAN. DRAINAGE FLOW MUST NOT BE RESTRICTED.

NOTE:
THE CONTRACTOR SHALL VERIFY THE LOCATION AND ELEVATION OF ALL UNDERGROUND UTILITIES IN AREAS OF CONSTUCTION PRIOR TO STARTING WORK. CONTACT THE ENGINEER IMMEDIATELY IF THE LOCATION OR ELEVATION IS DIFFERENT FROM THAT SHOWN ON THE PLAN. IF THERE APPEARS TO BE A CONFLICT, AND UPON DISCOVERY OF ANY UTILITY NOT SHOWN ON THIS PLAN, CALL "MISS UTILITY" OF CENTRAL VIRGINIA AT 1-800-552-7001.

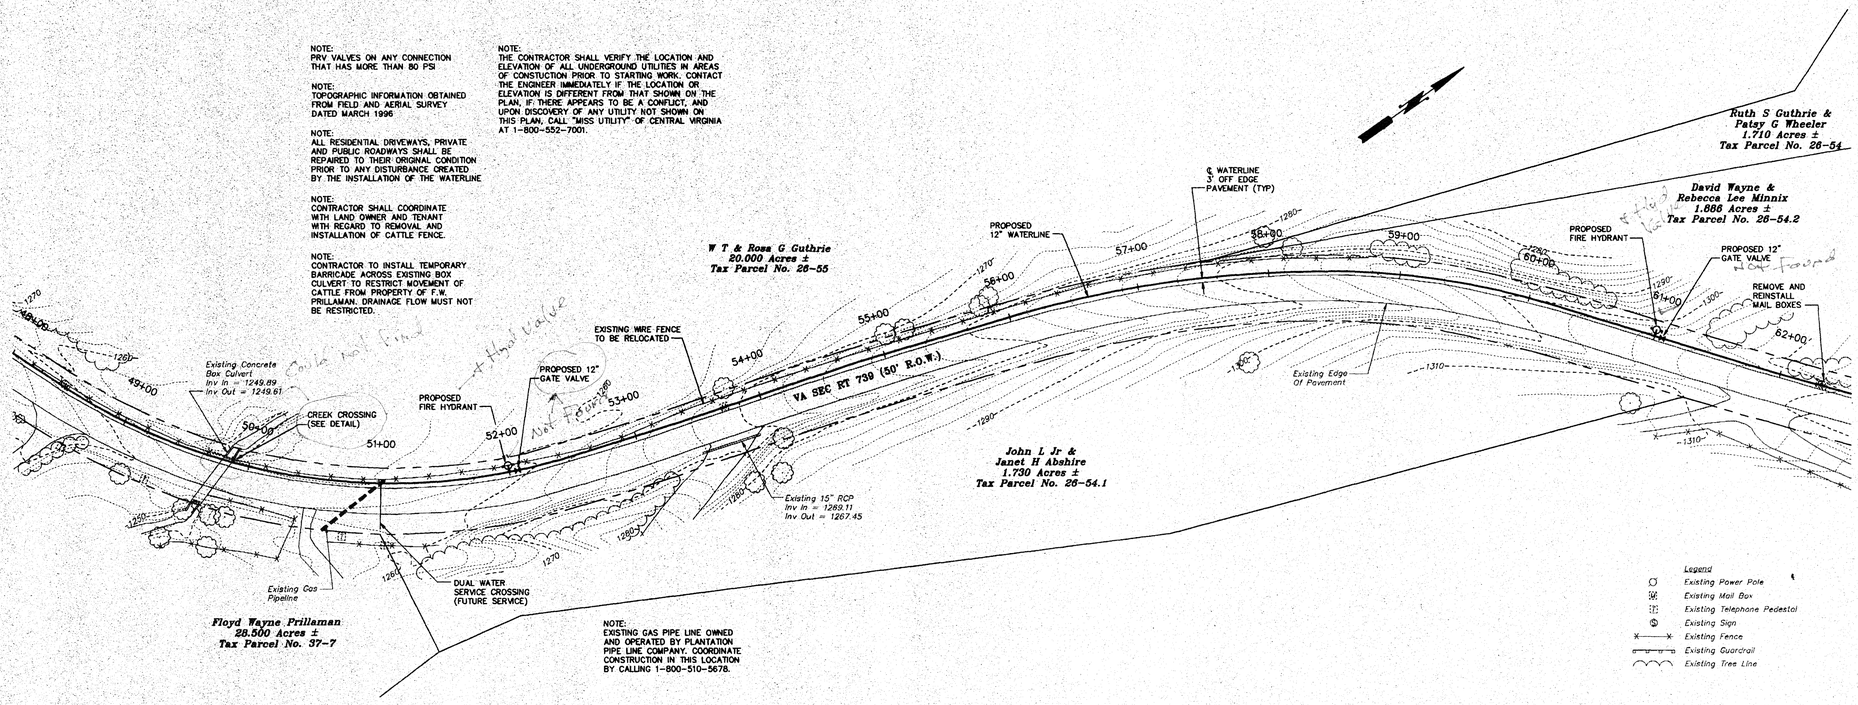

NOTE:
EXISTING GAS PIPE LINE OWNED AND OPERATED BY PLANTATION PIPE LINE COMPANY. COORDINATE CONSTRUCTION IN THIS LOCATION BY CALLING 1-800-510-5678.

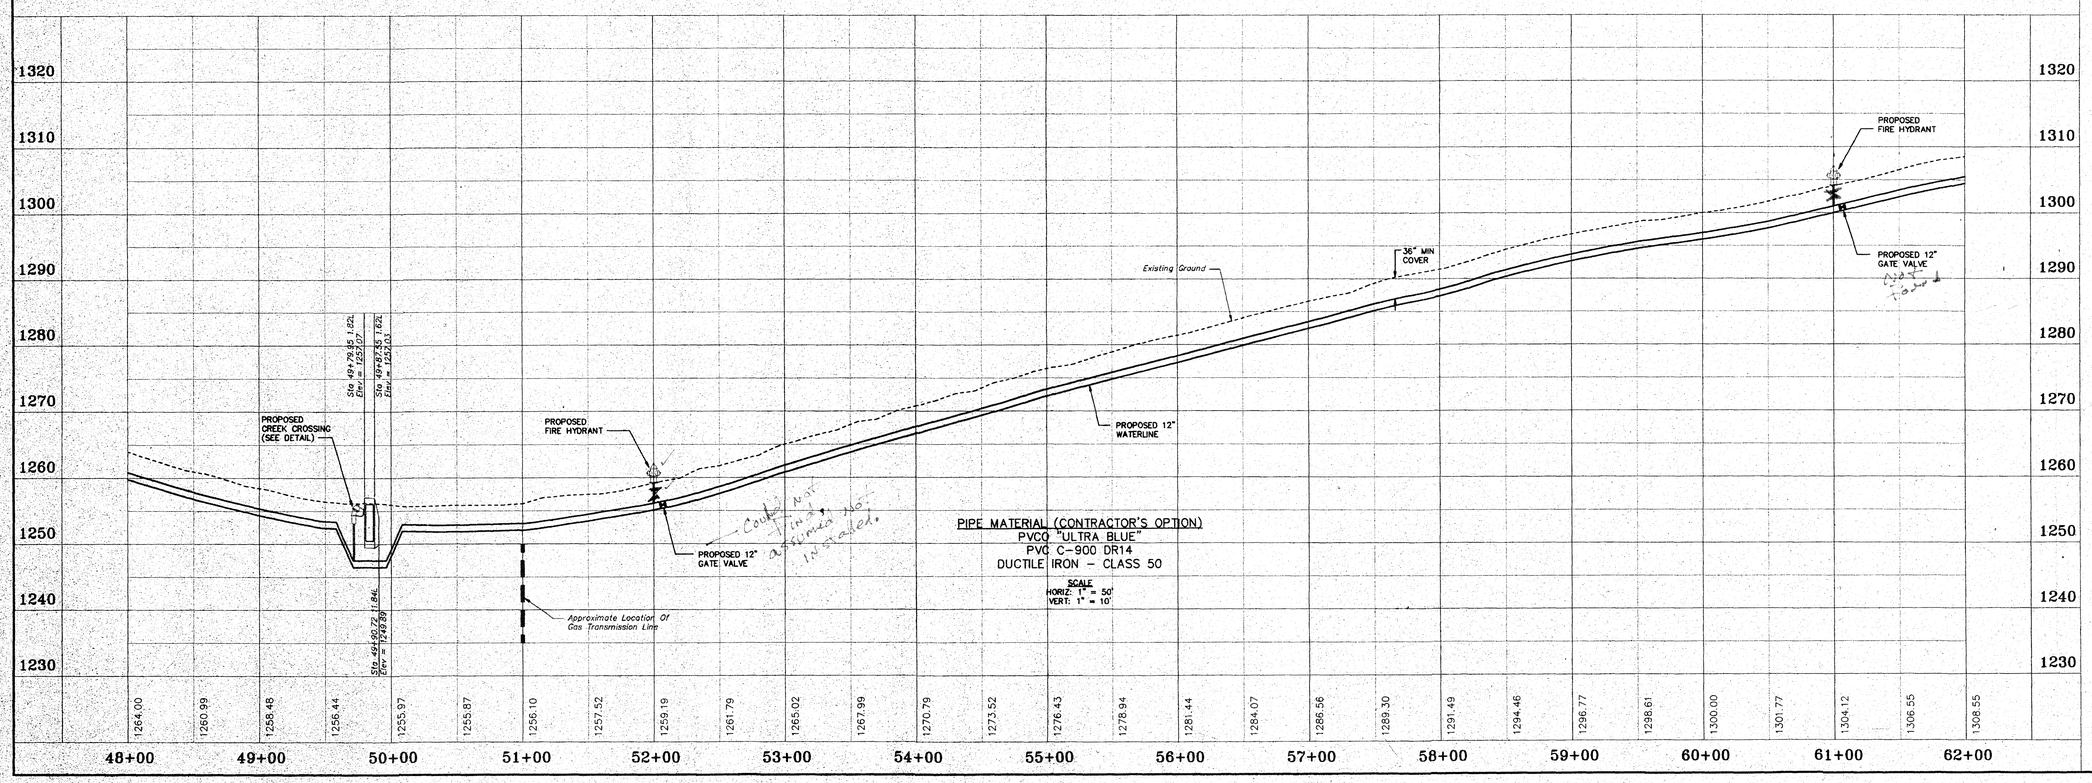

		DATE
6.		
5.		
4.		
3.		
2.	ADJUST NOTES	09/18/96
1.	PER VDH AND VDOT REVIEW	07/22/96

REVISIONS

DATE: JUNE 19, 1996
JOB No.: 960210
ACAD #: RCP04033

SCALE: 1" = 50'
DRAWN BY: MMB
CHKD: RGL

0 25 50 100 200

-LANG-
engineering co.
Consulting Engineers · Land Planners
P.O. BOX 7566 ROANOKE, VA. 24019 (540)366-4800

WATERLINE EXTENTION
WATER SUPPLY PROJECT CIG95-32
TOWN OF BOONES MILL
FRANKLIN COUNTY, VIRGINIA

SHEET NO. 6
OF 13