


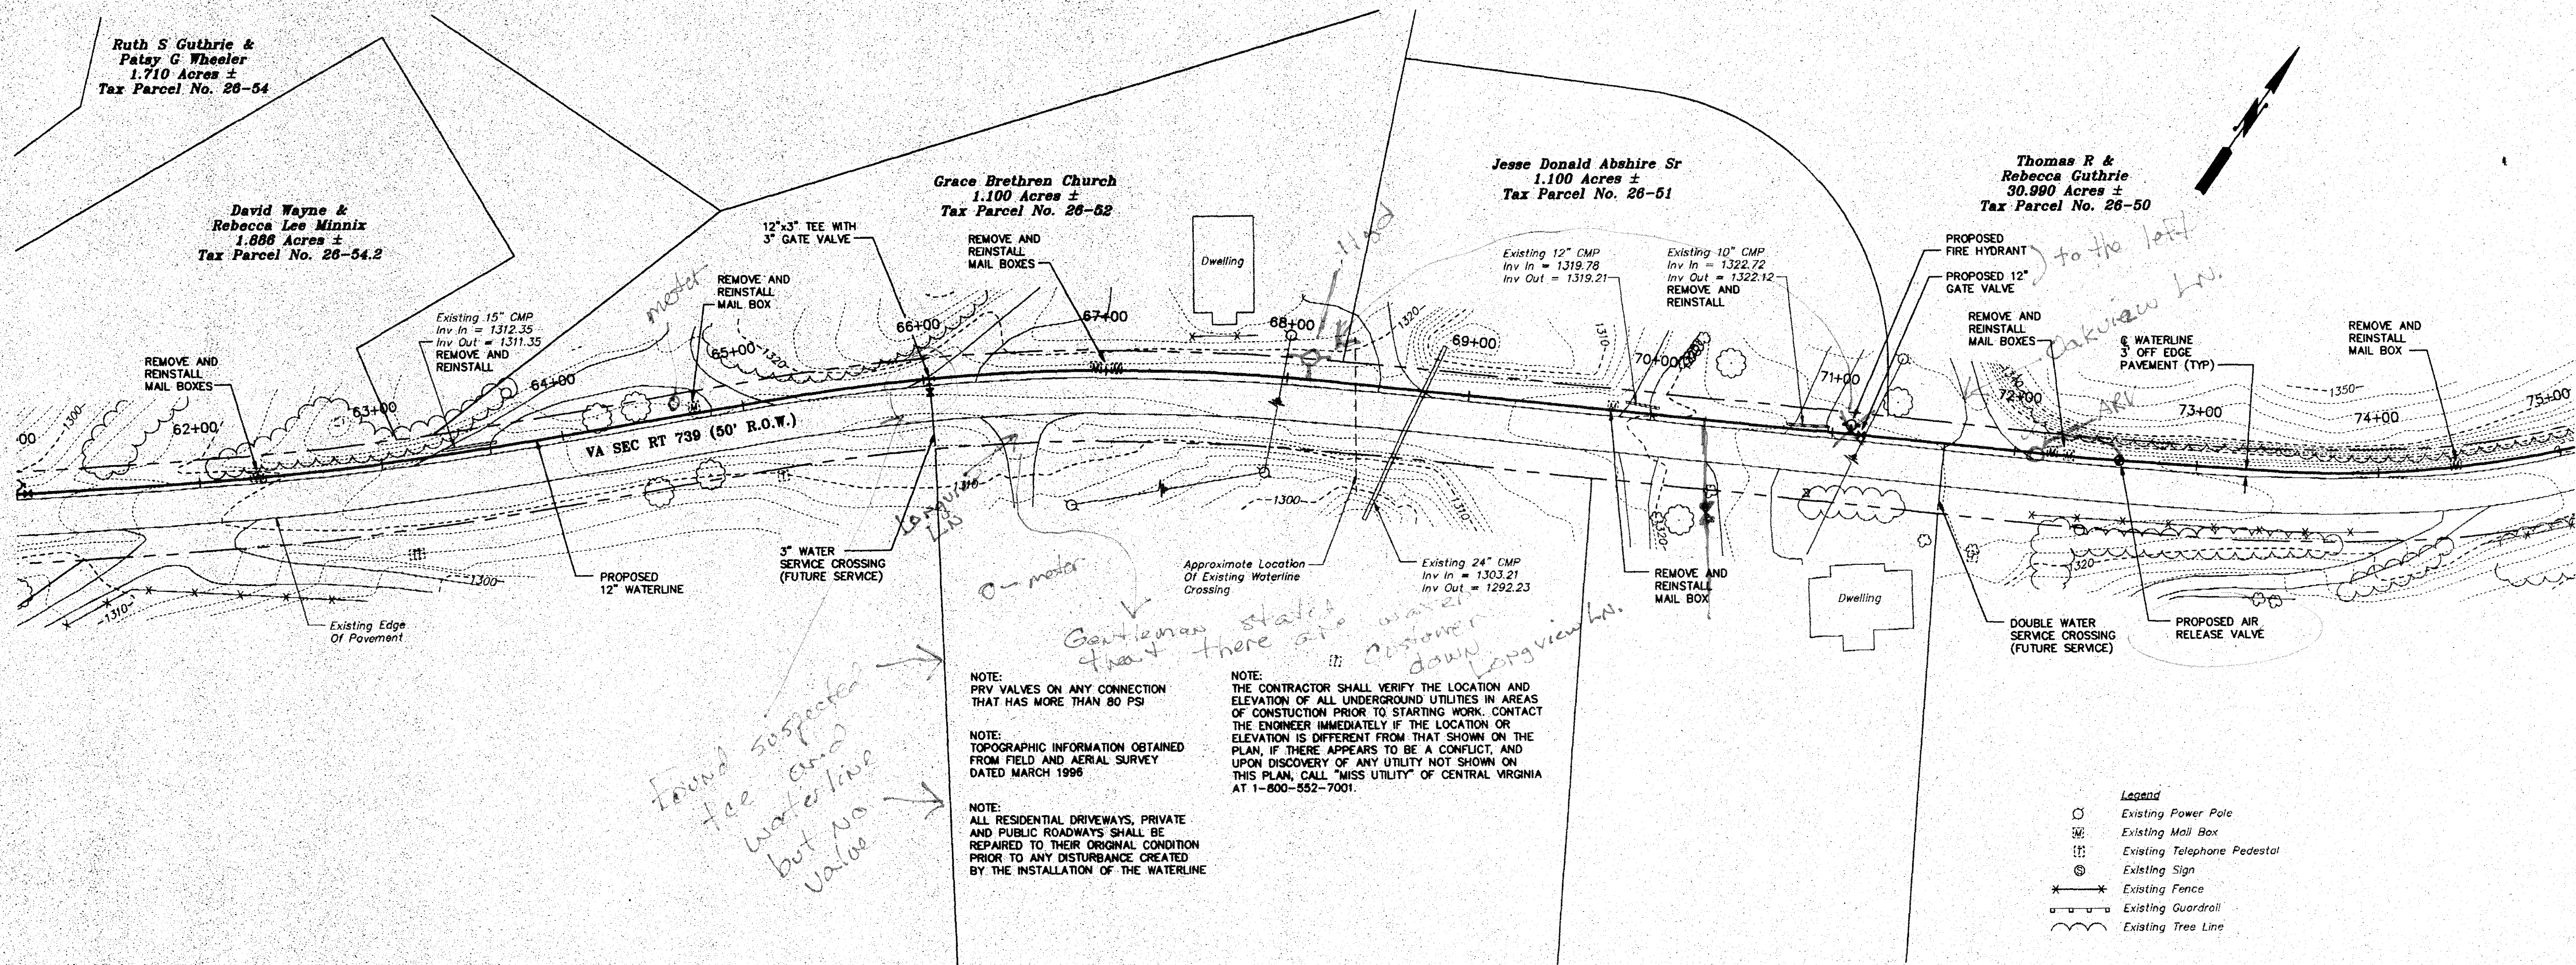

Found suspected
tee and
waterline
but no
valve


NOTE:
PRV VALVES ON ANY CONNECTION
THAT HAS MORE THAN 80 PSI

NOTE:
TOPOGRAPHIC INFORMATION OBTAINED
FROM FIELD AND AERIAL SURVEY
DATED MARCH 1996

NOTE:
ALL RESIDENTIAL DRIVEWAYS, PRIVATE
AND PUBLIC ROADWAYS SHALL BE
REPAIRED TO THEIR ORIGINAL CONDITION
PRIOR TO ANY DISTURBANCE CREATED
BY THE INSTALLATION OF THE WATERLINE

NOTE:
THE CONTRACTOR SHALL VERIFY THE LOCATION AND
ELEVATION OF ALL UNDERGROUND UTILITIES IN AREAS
OF CONSTRUCTION PRIOR TO STARTING WORK. CONTACT
THE ENGINEER IMMEDIATELY IF THE LOCATION OR
ELEVATION IS DIFFERENT FROM THAT SHOWN ON THE
PLAN, IF THERE APPEARS TO BE A CONFLICT, AND
UPON DISCOVERY OF ANY UTILITY NOT SHOWN ON
THIS PLAN, CALL "MISS UTILITY" OF CENTRAL VIRGINIA
AT 1-800-852-7001.

- Legend
- Existing Power Pole
 - Existing Mail Box
 - Existing Telephone Pedestal
 - Existing Sign
 - Existing Fence
 - Existing Guardrail
 - Existing Tree Line

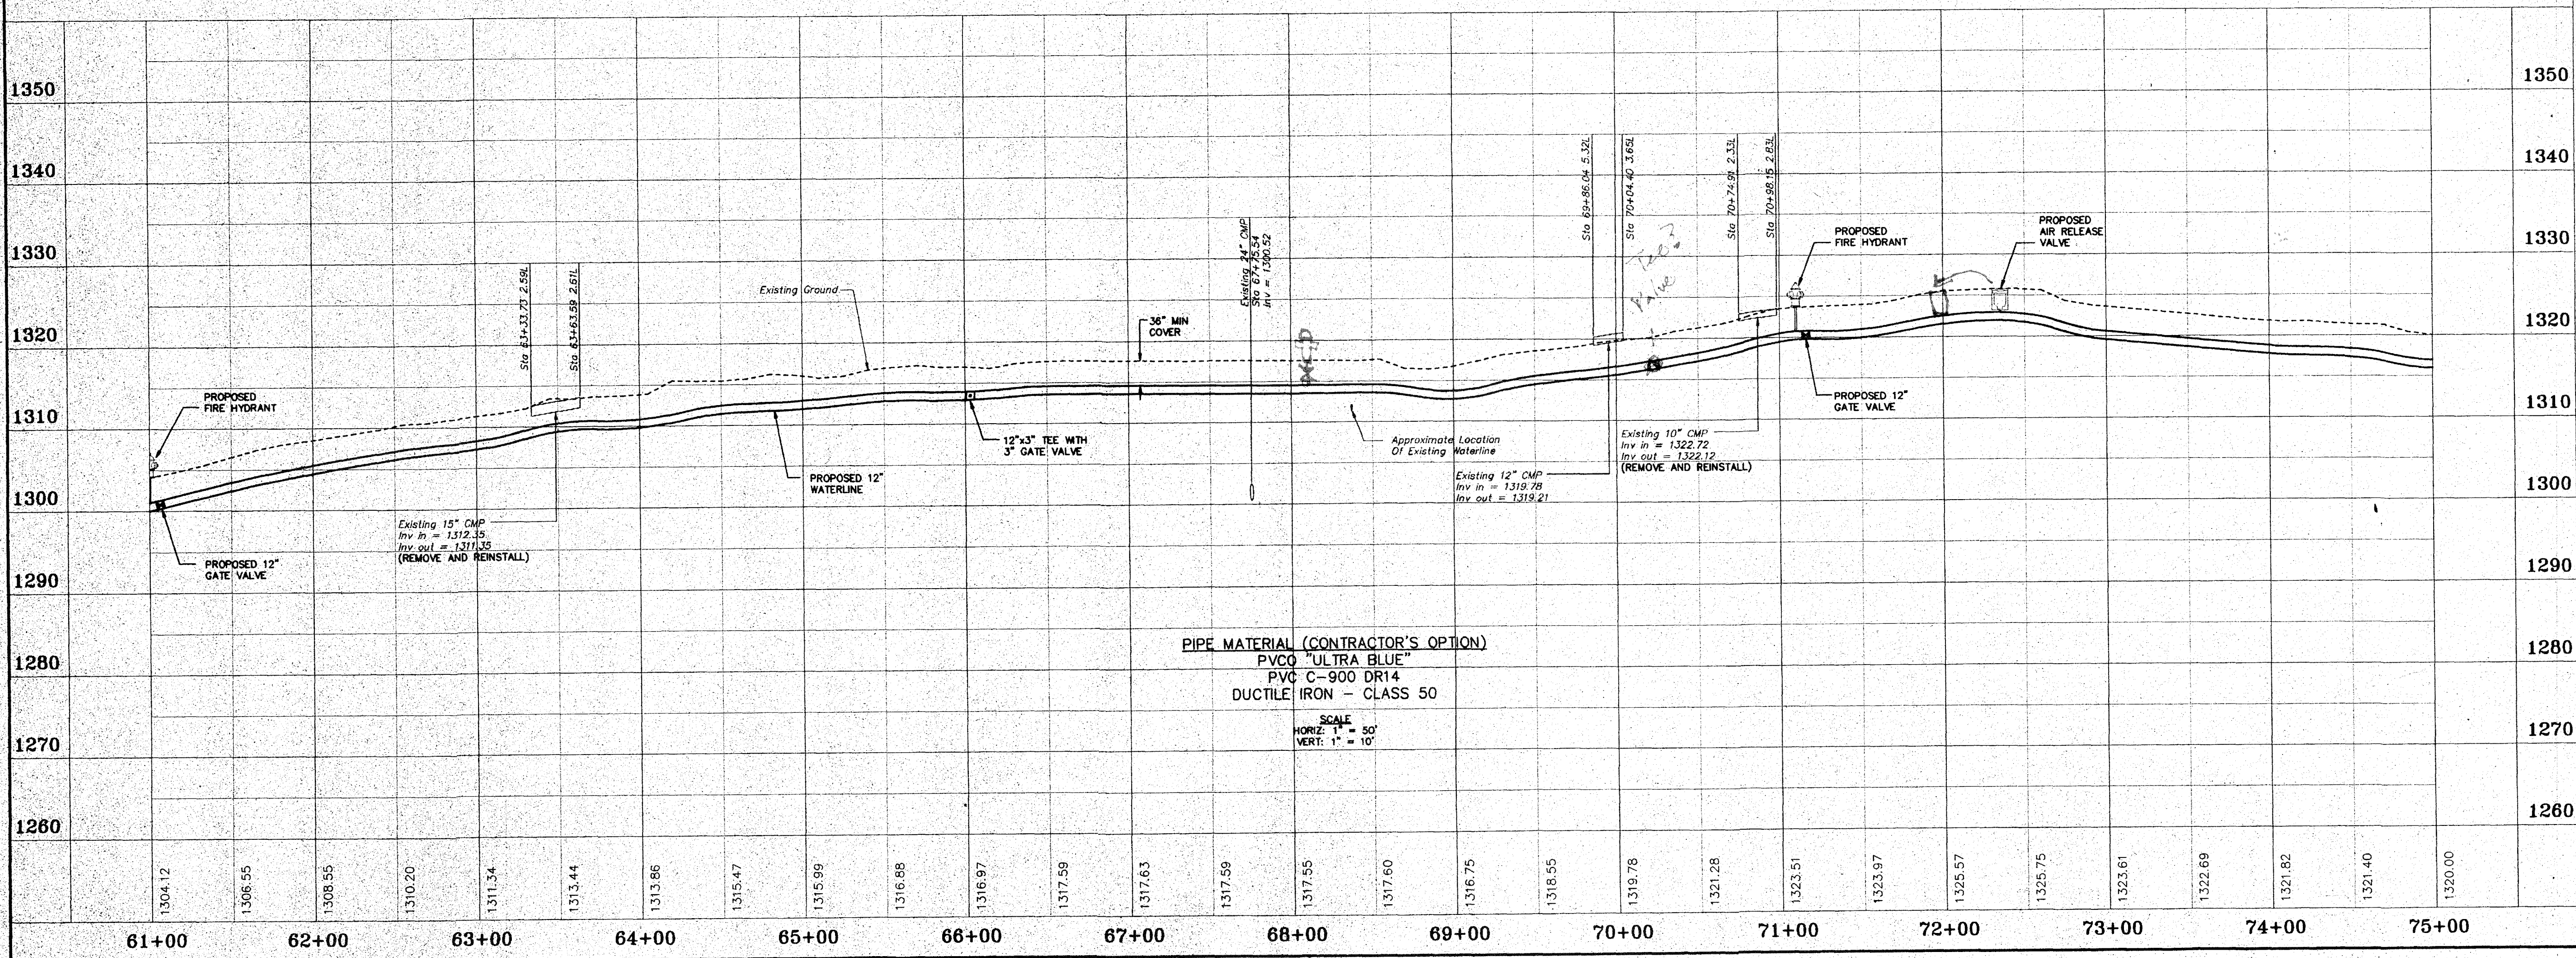

PIPE MATERIAL (CONTRACTOR'S OPTION)
PVC "ULTRA BLUE"
PVC C-900 DR14
DUCTILE IRON - CLASS 50

SCALE
HORIZ: 1" = 30'
VERT: 1" = 10'

DATE	
REVISIONS	
6	
5	
4	
3	
2	
1	ADJUST NOTES

DATE: JUNE 19, 1996	SCALE: 1" = 50'
JOB NO.: 960210	DRAWN BY: MMB
ACAD #: RCP05033	CHKD: RGL

-LANG-
engineering co.
Consulting Engineers - Land Planners
P.O. BOX 7566, ROANOKE, VA 24019 (540) 366-4800

WATERLINE EXTENSION
WATER SUPPLY PROJECT CIG95-32
TOWN OF BOONES MILL
FRANKLIN COUNTY, VIRGINIA

SHEET NO.
13
OF