
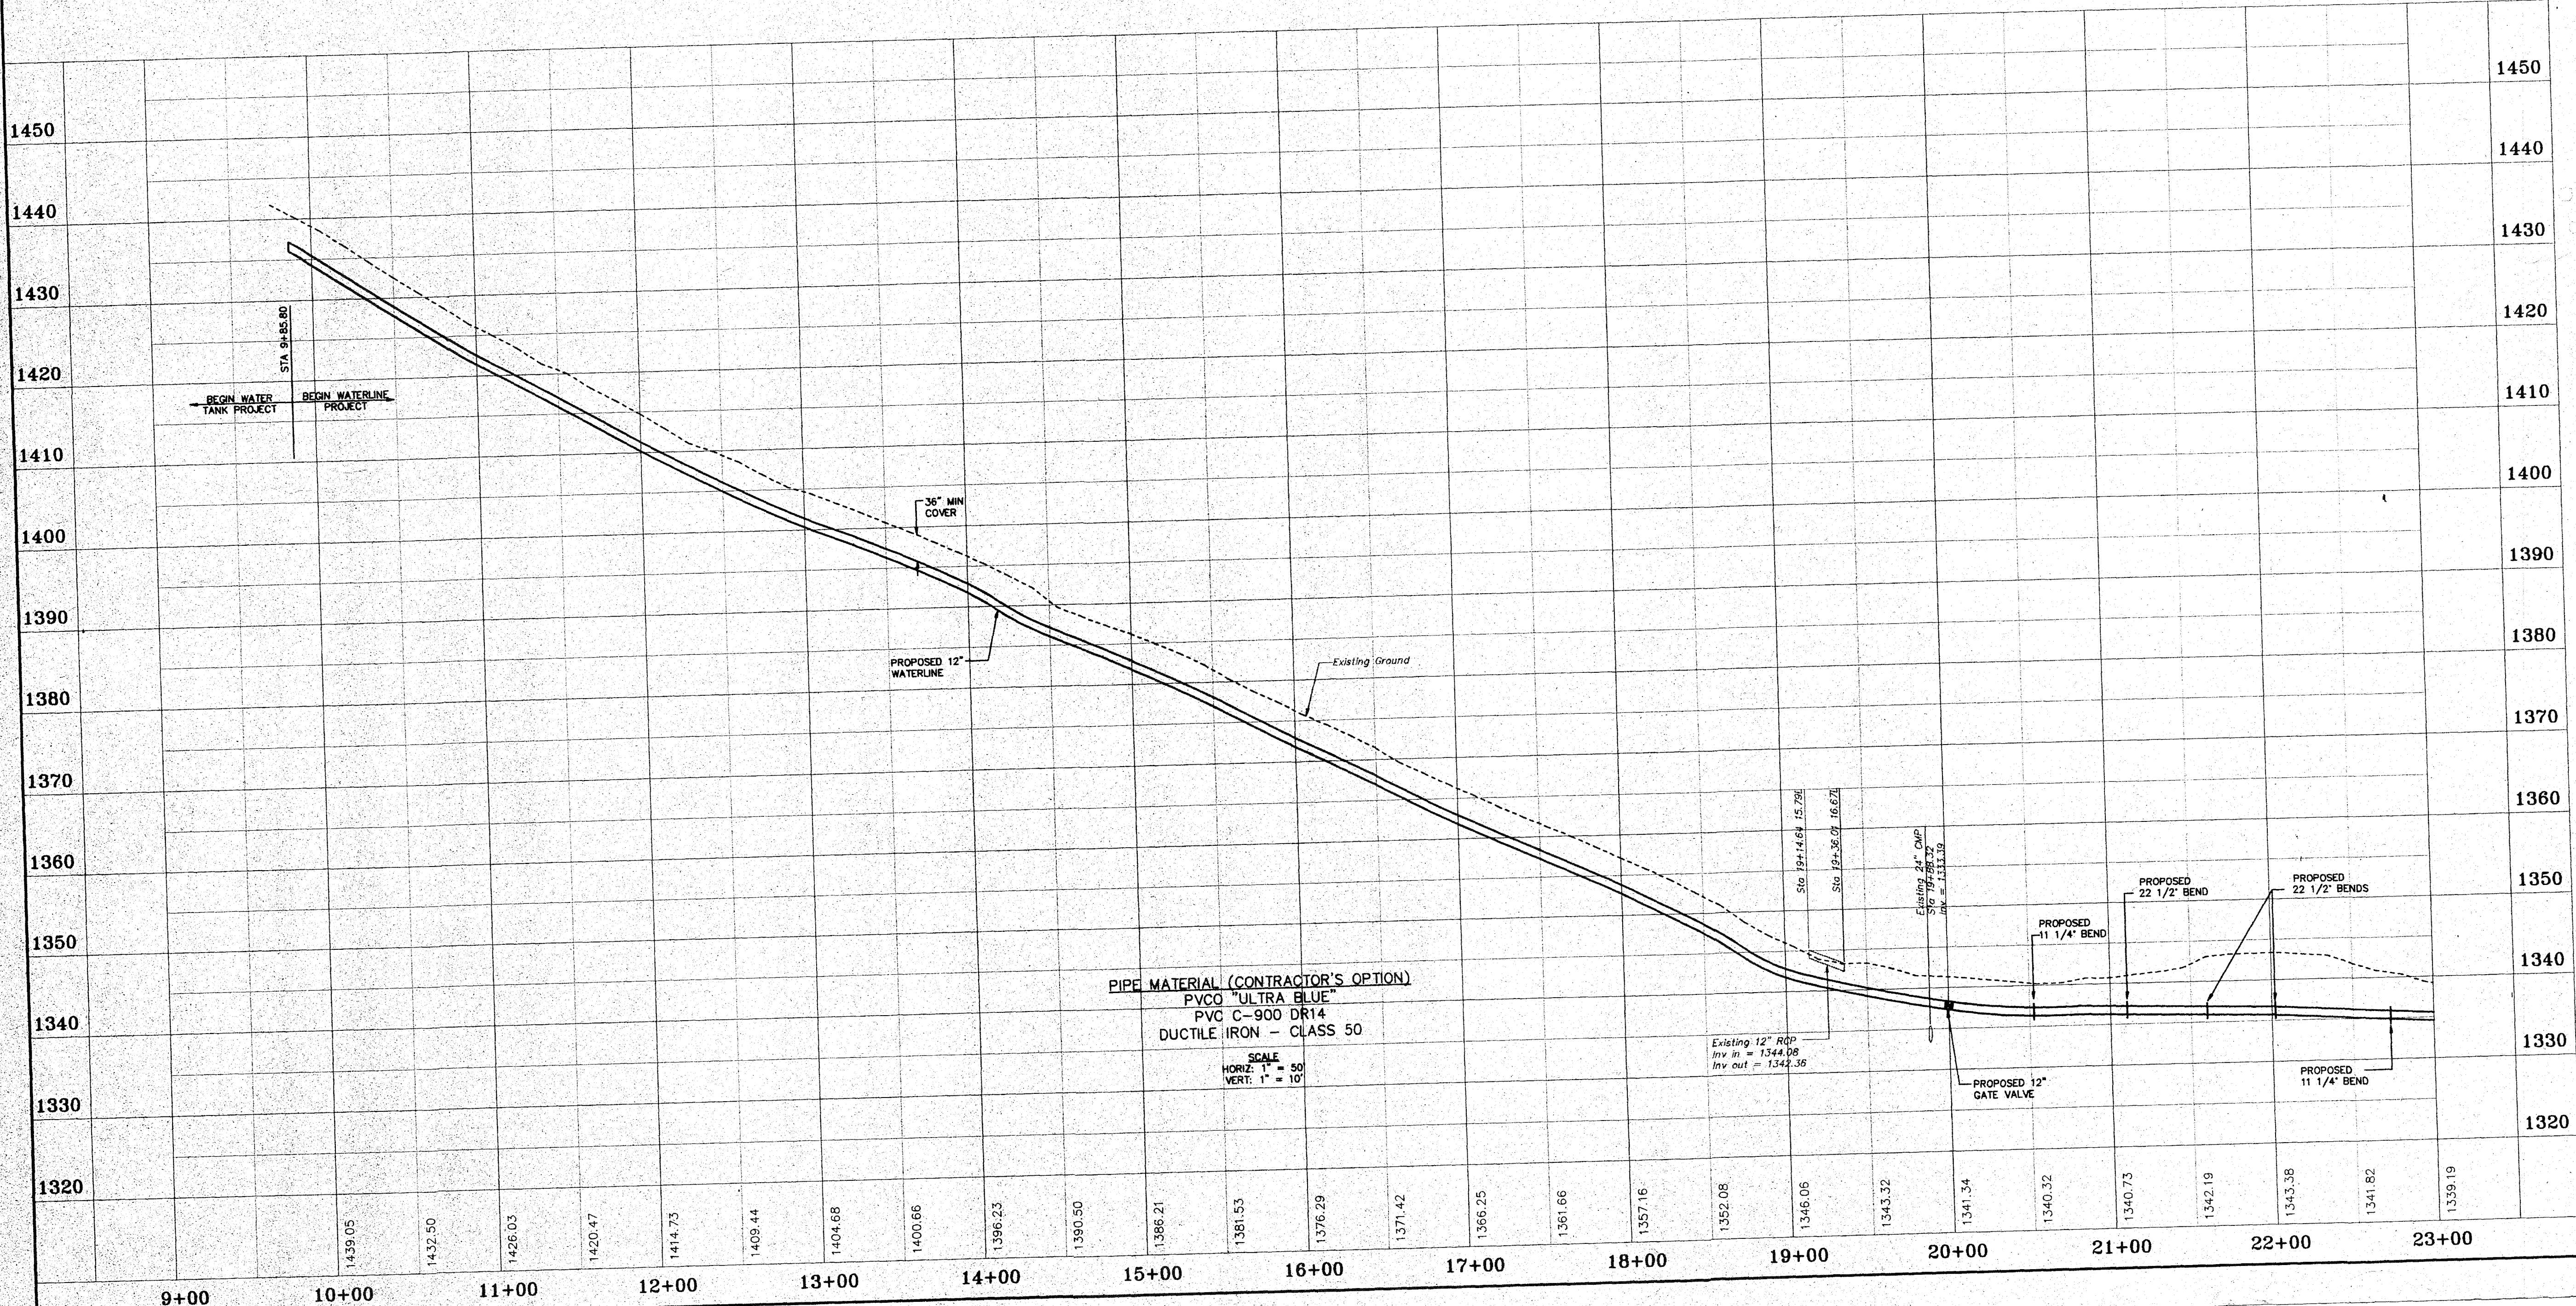


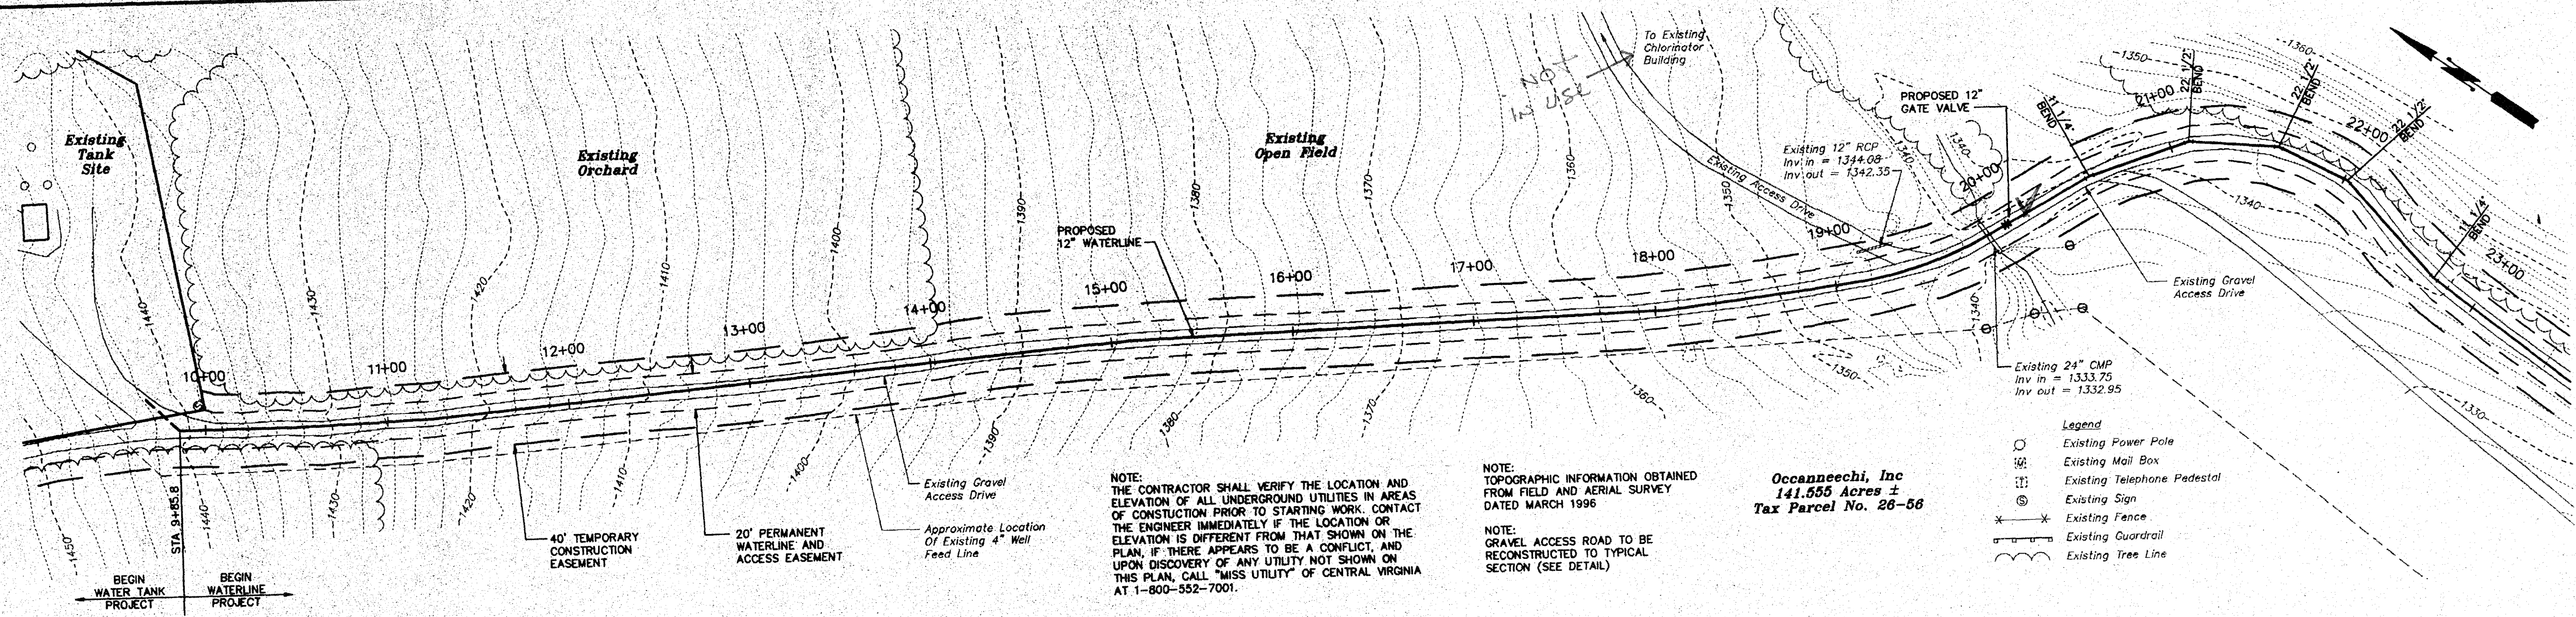

DATE: JUNE 19, 1996
JOB NO.: 960210
ACAD #: RCP01033

SCALE: 1" = 50'
DRAWN BY: MMB
CHKD: RCL

1 ADD PIPE MATERIAL NOTE 09/18/96

-LANG-
engineering co.
Consulting Engineers • Land Planners
P.O. BOX 7566 ROANOKE, VA 24019
(540)366-4800

**WATERLINE EXTENSION
WATER SUPPLY PROJECT CIG95-32**
**TOWN OF BOONES MILL
FRANKLIN COUNTY, VIRGINIA**

SHEET NO. 3
13