

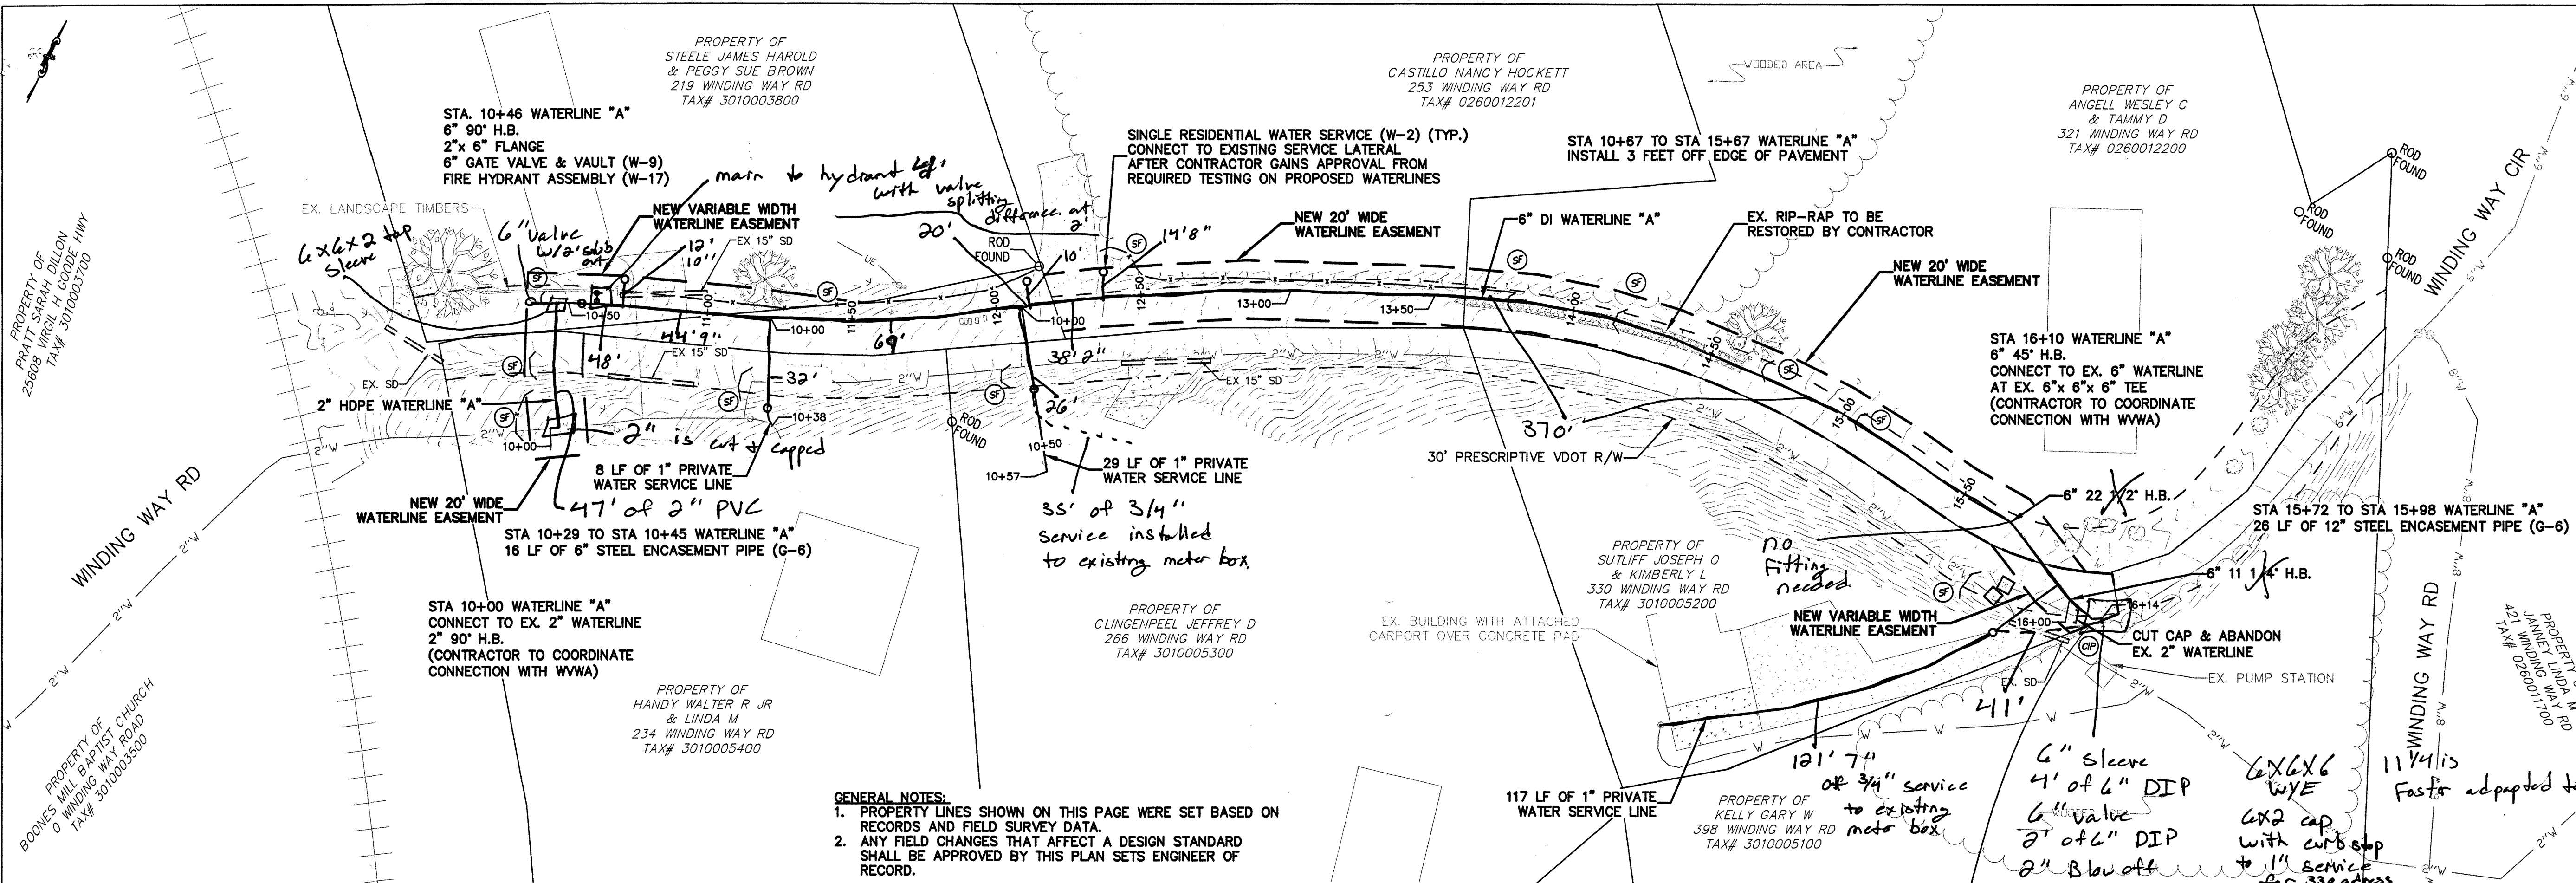
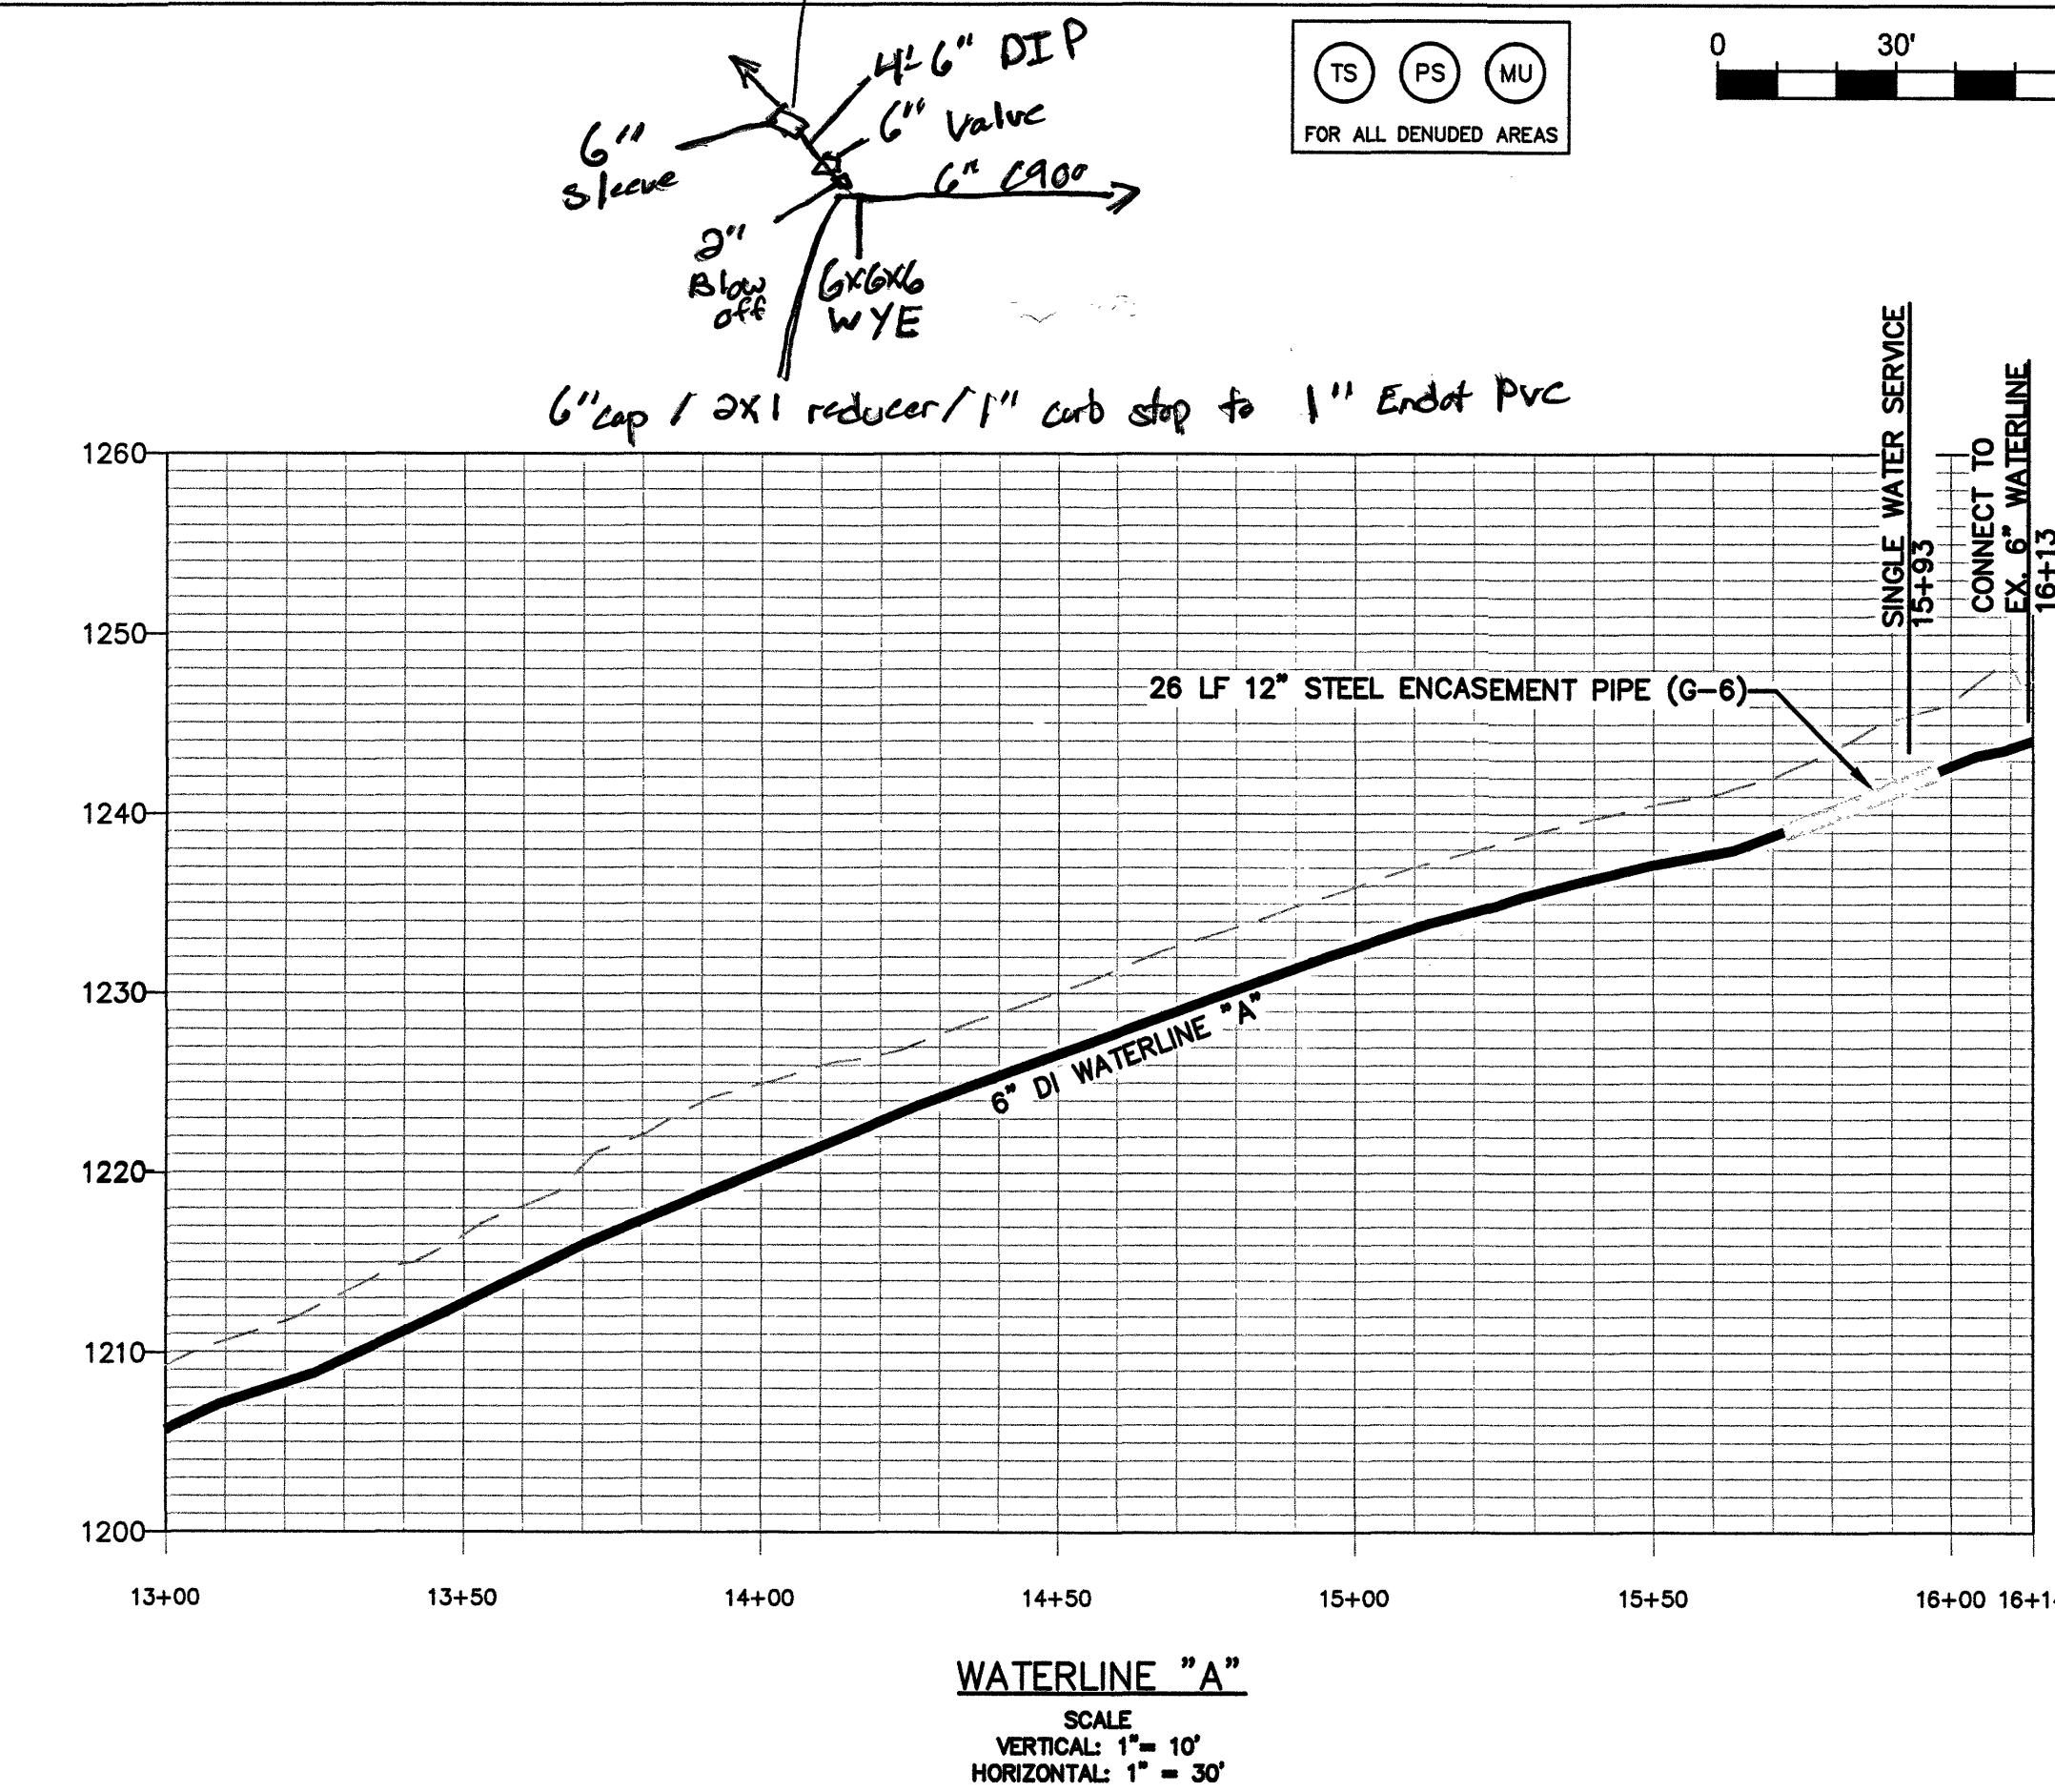


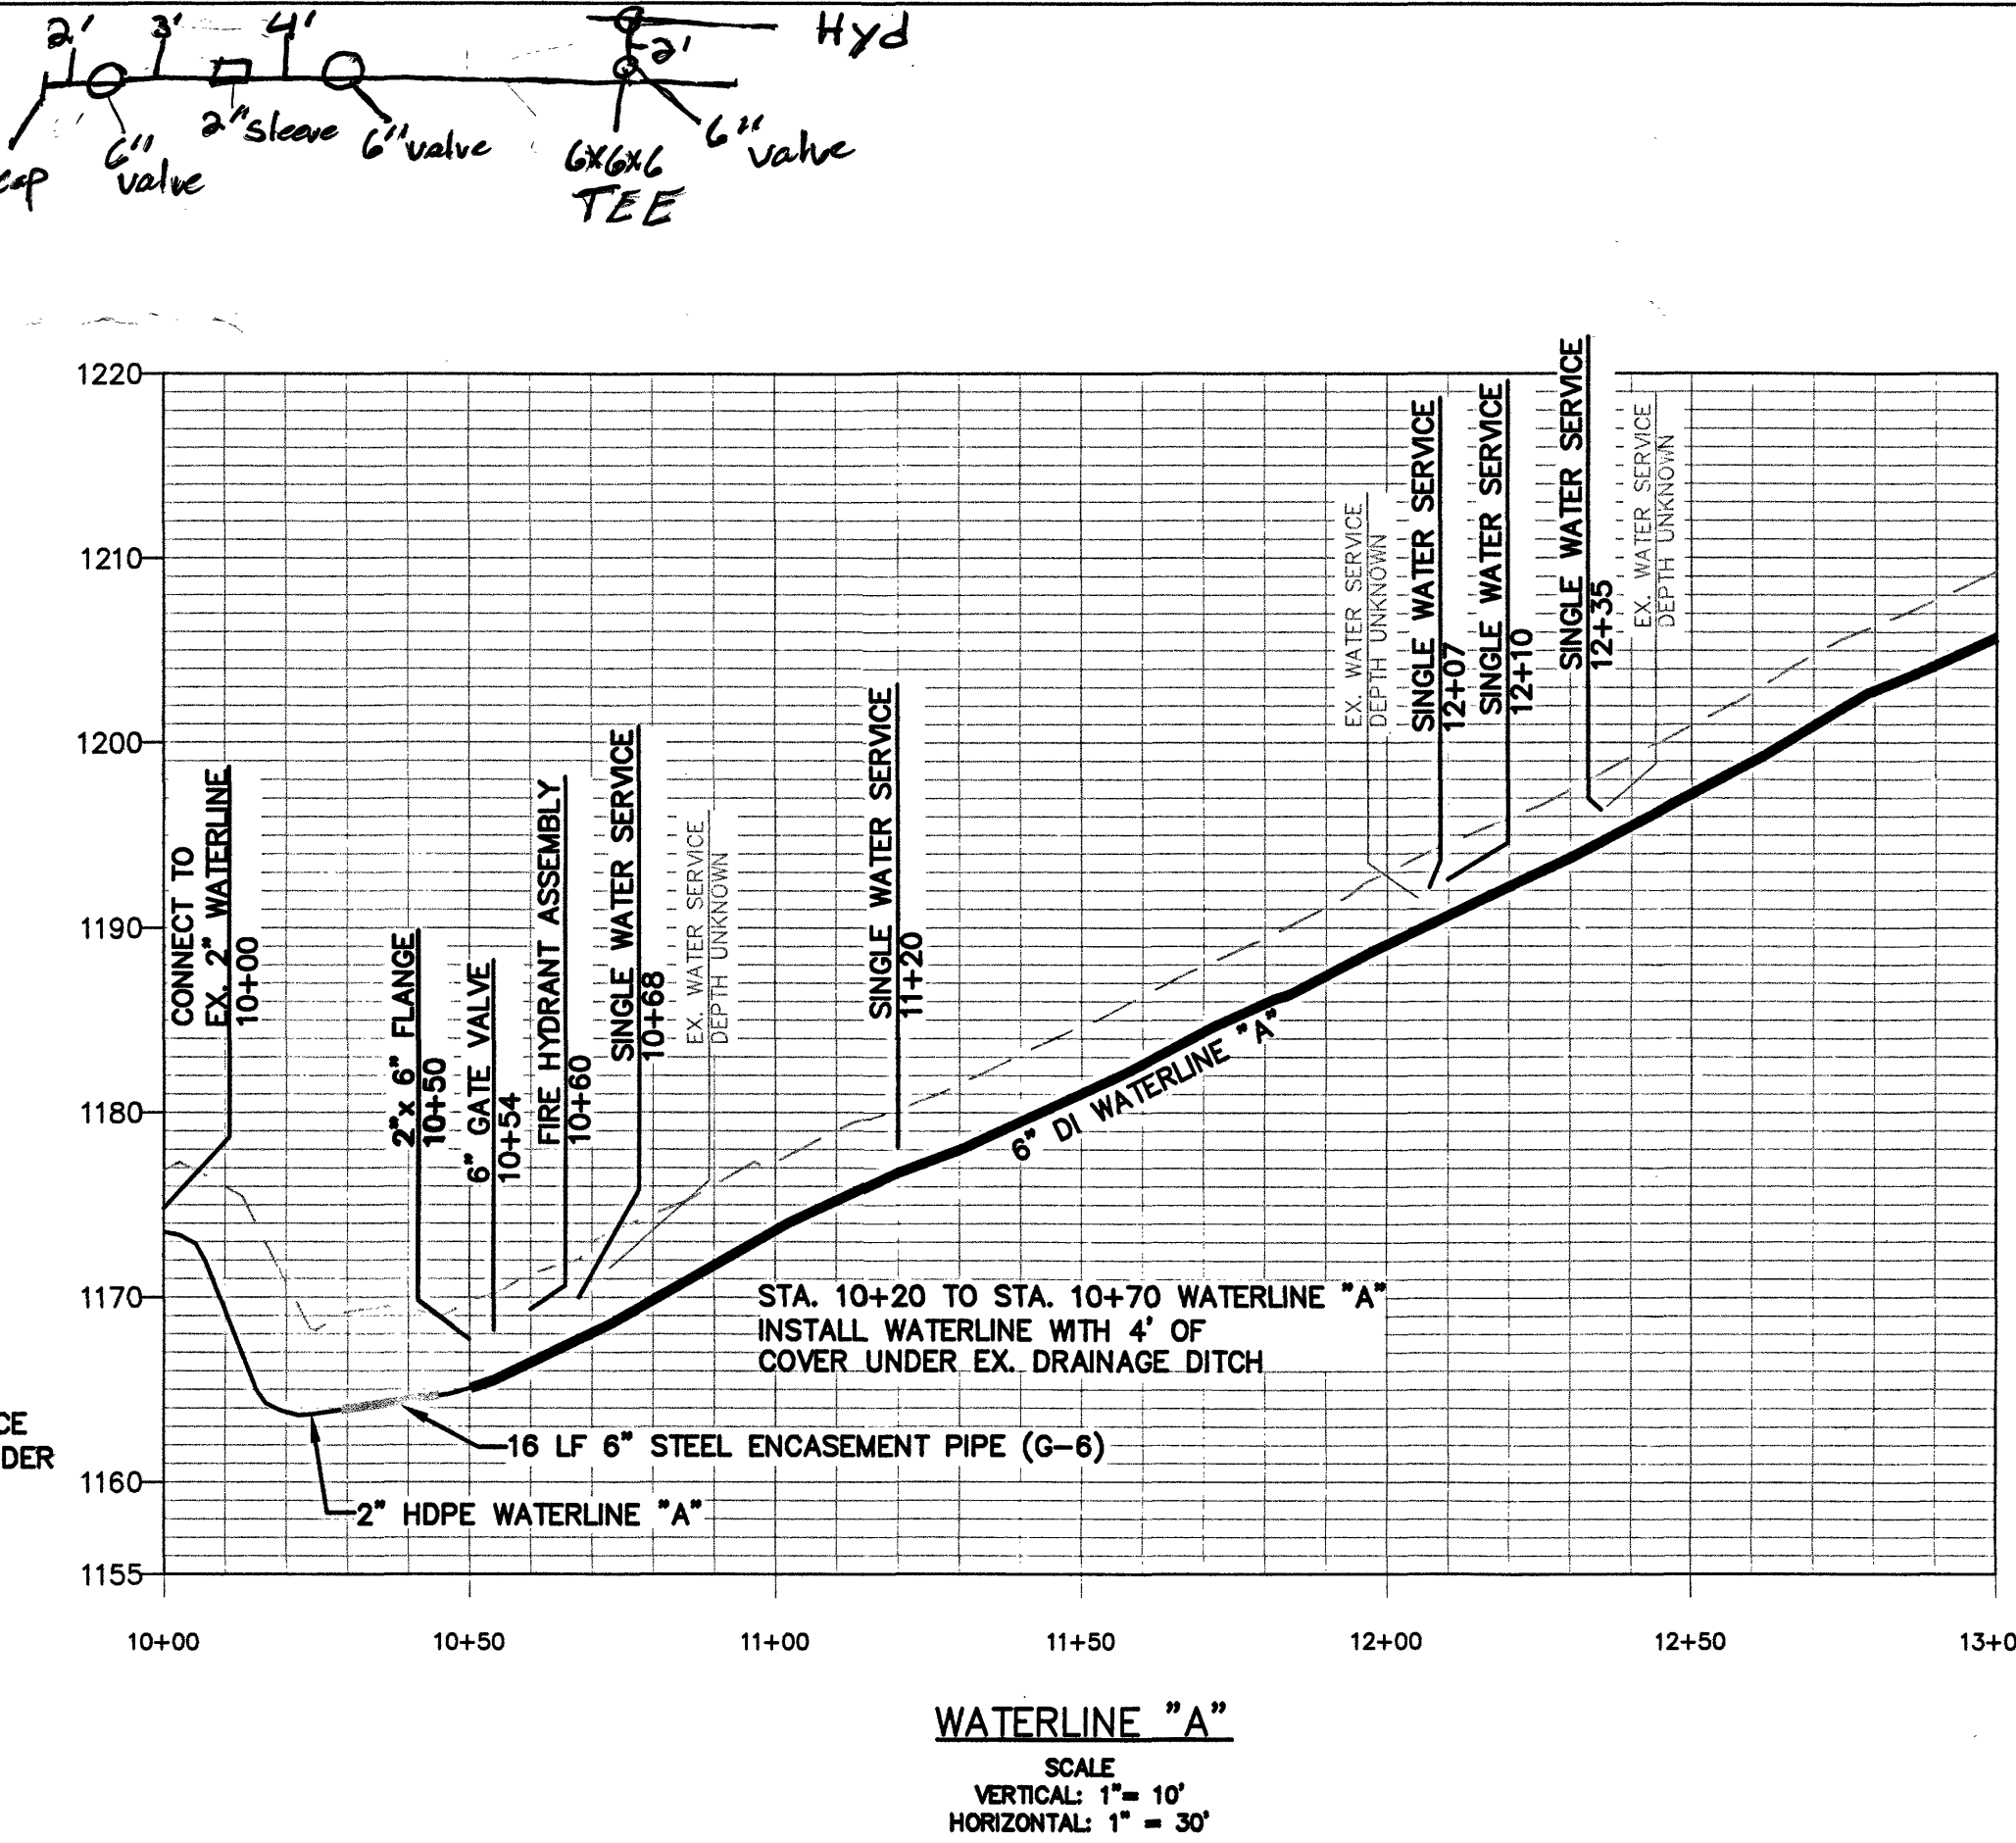

SURVEY NOTES:

- ALL SURVEY FOR THIS PROJECT WAS CONDUCTED USING A COMBINATION OF TOTAL STATION AND RTK GPS EQUIPMENT. THE DATUMS USED FOR THE SURVEY ARE NAD83 & NAVD88. THE COORDINATE SYSTEM USED FOR THE SURVEY IS VIRGINIA STATE PLANE, SOUTH ZONE, US FOOT.
- ALL SURVEY DATA'S GENERAL ACCURACY IS AS FOLLOWS:
-HORIZONTAL ACCURACY: WITHIN 0.5' WITH OCCASIONAL EXCEPTION
-VERTICAL ACCURACY: WITHIN 0.1' WHERE INFORMATION IS PROVIDED ON PLAN
- CONTOUR DATA ON THIS PLAN IS GENERALLY ACCURATE TO WITHIN ±0.5' WHERE CONTOUR DATA IS PROVIDED.
- THIS PLAN WAS PREPARED WITHOUT THE BENEFIT OF A CURRENT TITLE REPORT AND THEREFORE, THERE MAY EXIST ENCUMBRANCES NOT SHOWN HEREON.
- WITH OCCASIONAL EXCEPTION, EDGE OF PAVEMENT, GRAVEL, CONCRETE, & BRICK ARE SHOWN BASED ON GEOREFERENCED AERIAL IMAGERY AND ARE TYPICALLY ACCURATE TO WITHIN 1.0'.
- WITH OCCASIONAL EXCEPTION, EXISTING BUILDINGS SHOWN ARE BASED ON MUNICIPAL GIS DATA AND GEOREFERENCED AERIAL IMAGERY AND ARE TYPICALLY ACCURATE TO WITHIN 5.0'.
- THIS PLAN DOES NOT GUARANTEE THE EXISTENCE, LOCATION, SIZE, MATERIAL OR TYPE OF ANY UNDERGROUND UTILITIES. ALL UNDERGROUND UTILITIES & STRUCTURES SHOWN ON THIS PLAN ARE SHOWN BASED ON SURVEYED ABOVE GROUND STRUCTURES, CCTV SURVEYS, AVAILABLE PUBLIC RECORDS AND BY UTILITY LINE LOCATION MARKINGS ESTABLISHED BY MISS UTILITY OF VIRGINIA TICKET # A000901072-00A. ALL UNDERGROUND UTILITY & STRUCTURE LOCATION SHOULD BE FIELD VERIFIED PRIOR TO THE START OF ANY CONSTRUCTION.

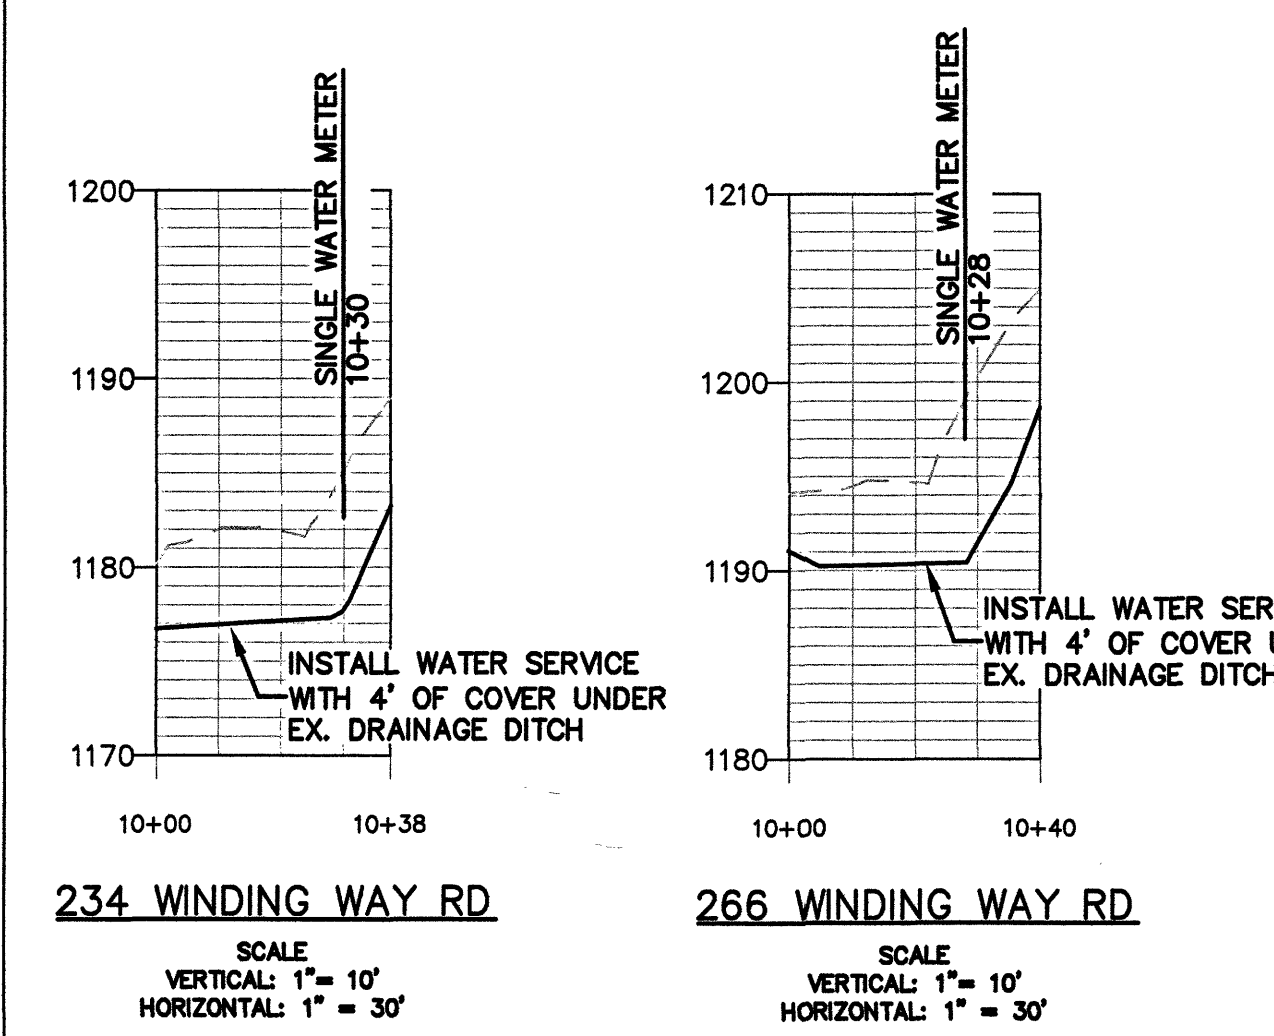

WESTERN VIRGINIA

WATER AUTHORITY
ENGINEERING SERVICES
601 S JEFFERSON ST. SUITE 300
ROANOKE, VA 24011
540-853-5700

PRELIMINARY
(NOT FOR CONSTRUCTION)

WINDING WAY ROAD
WATERLINE EXTENSION

PLAN & PROFILE

Rev	Description	Date	By

Designed: WVWA
Drawn: AJC
Checked: DRJ
Approved: TEC
Date: MAR 2020
Project: CUST. MTN.

2
Sheet 2 of 6