MARKER	OWNER	ADDRESS	METER SIZE	COMMENT
2A	SMITH LELAND W JR. & SARAH F	170 STONYBROOK RD	5/8"	
2	JOHNSON KIMBALL ALLEN & CHAD ALLEN	203 STONYBROOK RD	5/8"	
2B	BOWLES JEFFREY L & CATHY D (TRUSTEES)	238 STONYBROOK RD	5/8"	
2C	DINKLE PAMELA	241 STONYBROOK RD	5/8"	
3A	BOWLES JEFFREY L & CATHY D (TRUSTEES)	270 STONYBROOK RD	5/8"	

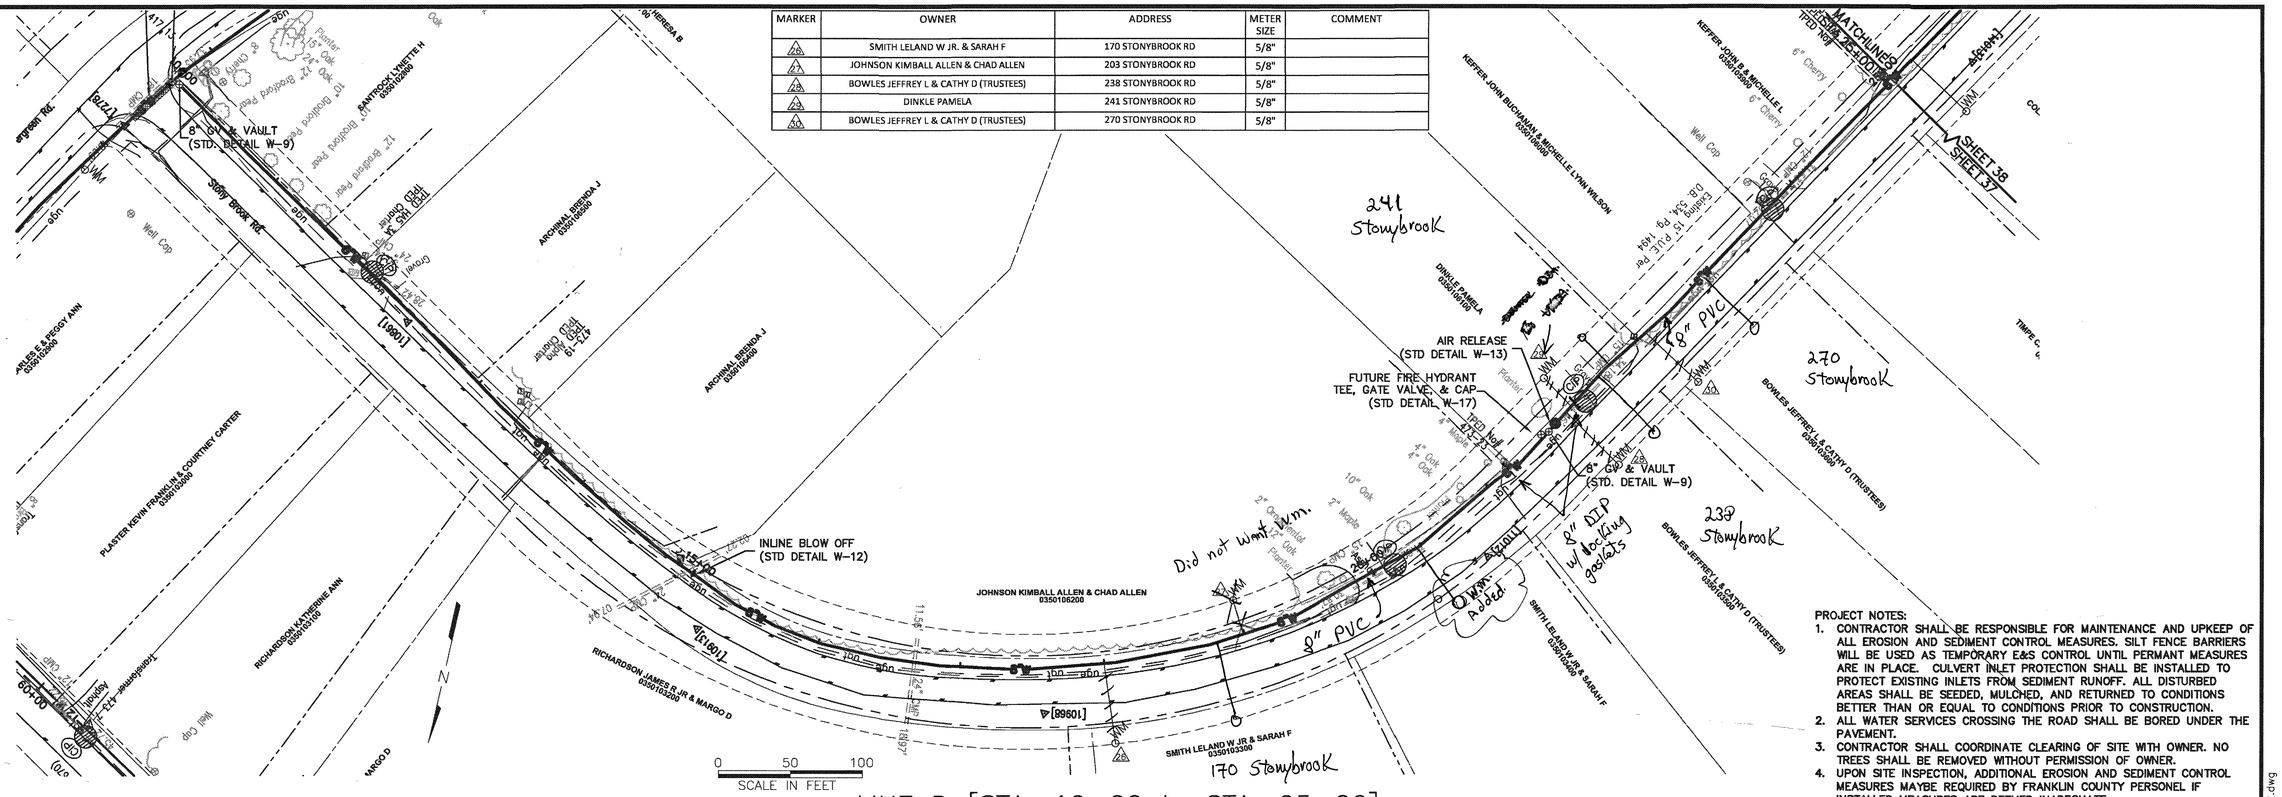

PROJECT NOTES:
1. CONTRACTOR SHALL BE RESPONSIBLE FOR MAINTENANCE AND UPKEEP OF ALL EROSION AND SEDIMENT CONTROL MEASURES. SILT FENCE BARRIERS WILL BE USED AS TEMPORARY E&S CONTROL UNTIL PERMANT MEASURES ARE IN PLACE. CULVERT INLET PROTECTION SHALL BE INSTALLED TO PROTECT EXISTING INLETS FROM SEDIMENT RUNOFF. ALL DISTURBED AREAS SHALL BE SEEDED, MULCHED, AND RETURNED TO CONDITIONS BETTER THAN OR EQUAL TO CONDITIONS PRIOR TO CONSTRUCTION.
2. ALL WATER SERVICES CROSSING THE ROAD SHALL BE BORED UNDER THE PAVEMENT.
3. CONTRACTOR SHALL COORDINATE CLEARING OF SITE WITH OWNER. NO TREES SHALL BE REMOVED WITHOUT PERMISSION OF OWNER.
4. UPON SITE INSPECTION, ADDITIONAL EROSION AND SEDIMENT CONTROL MEASURES MAYBE REQUIRED BY FRANKLIN COUNTY PERSONEL IF INSTALLED MEASURES ARE DEEMED INADEQUATE.

LINE D [STA. 10+00 to STA. 25+00]

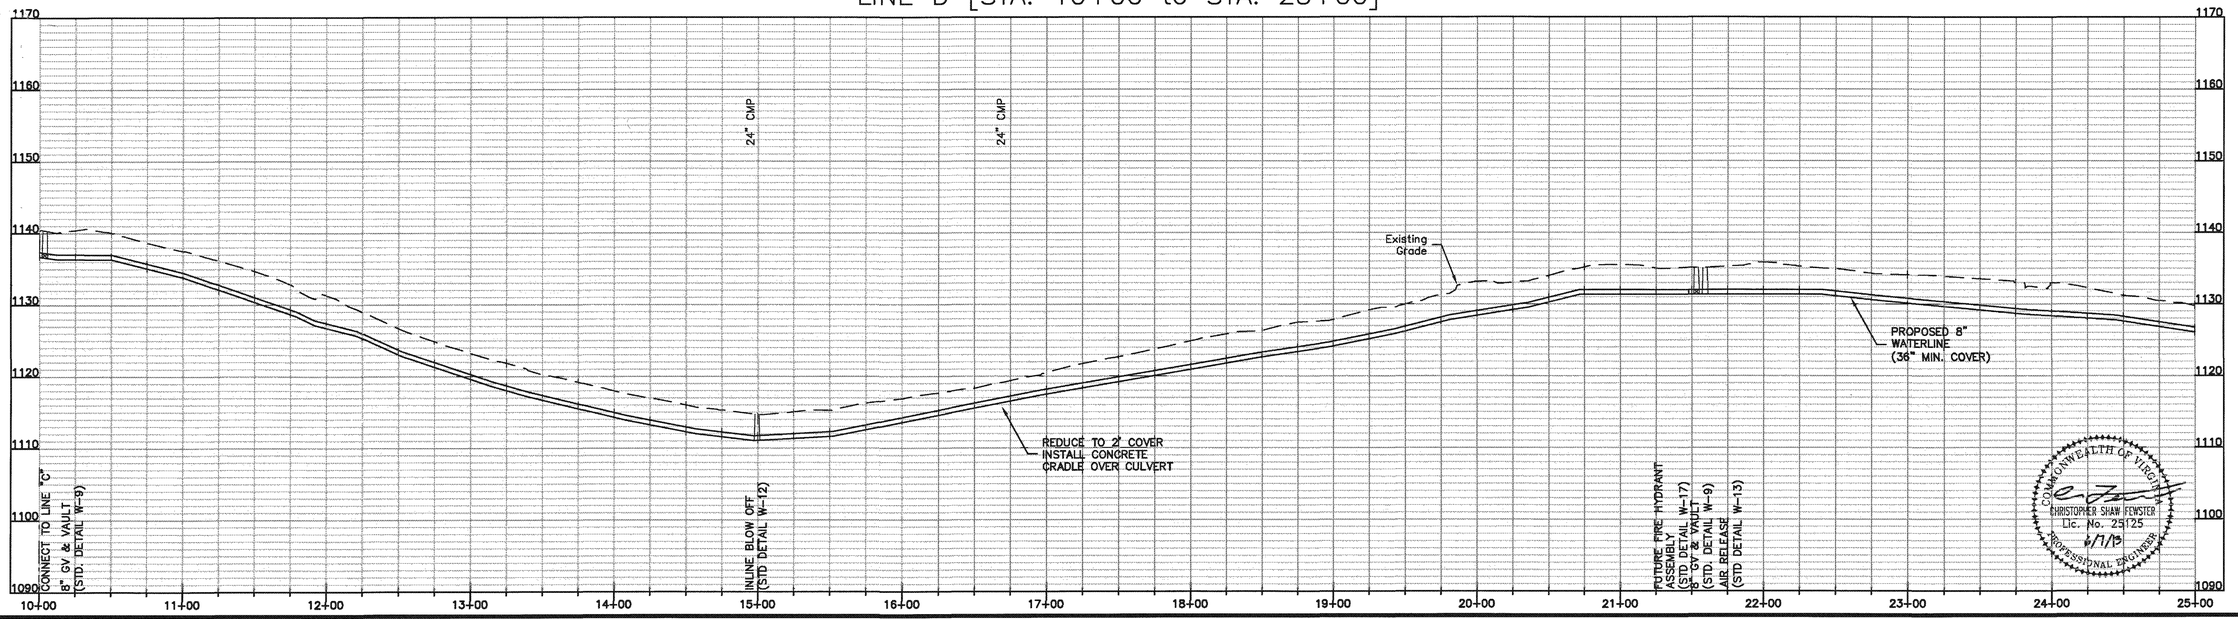

COMMONWEALTH OF VIRGINIA
CHRISTOPHER SHAW FEWSTER
Lic. No. 25125
6/1/13
PROFESSIONAL ENGINEER

ANDERSON & ASSOCIATES, INC. Professional Design Services www.andassoc.com 100 Ardmore St. Blacksburg, Va. 24060 540-552-5592	DATE : 07 JUN 13 DESIGNED: CSF DRAWN : SEC CHECKED : MGG QA / QC : CSF	REV. # COMMENTS DATE	FRANKLIN COUNTY / WESTERN VIRGINIA WATER AUTHORITY BURNT CHIMNEY WATER EXTENSION FRANKLIN COUNTY, VIRGINIA	Line D - Sta 10+00 to 25+00 PLAN AND PROFILE	DOCUMENT NO. 30337 – 002 SHEET 37 OF 44

As-Built 12.10.13 Wells Construction

Coldwell, Shawn / 6/7/2013 4:17 PM / \\oaprojects\projects\30\30337\30337_engineering\design\plans\30337_prelim2.dwg