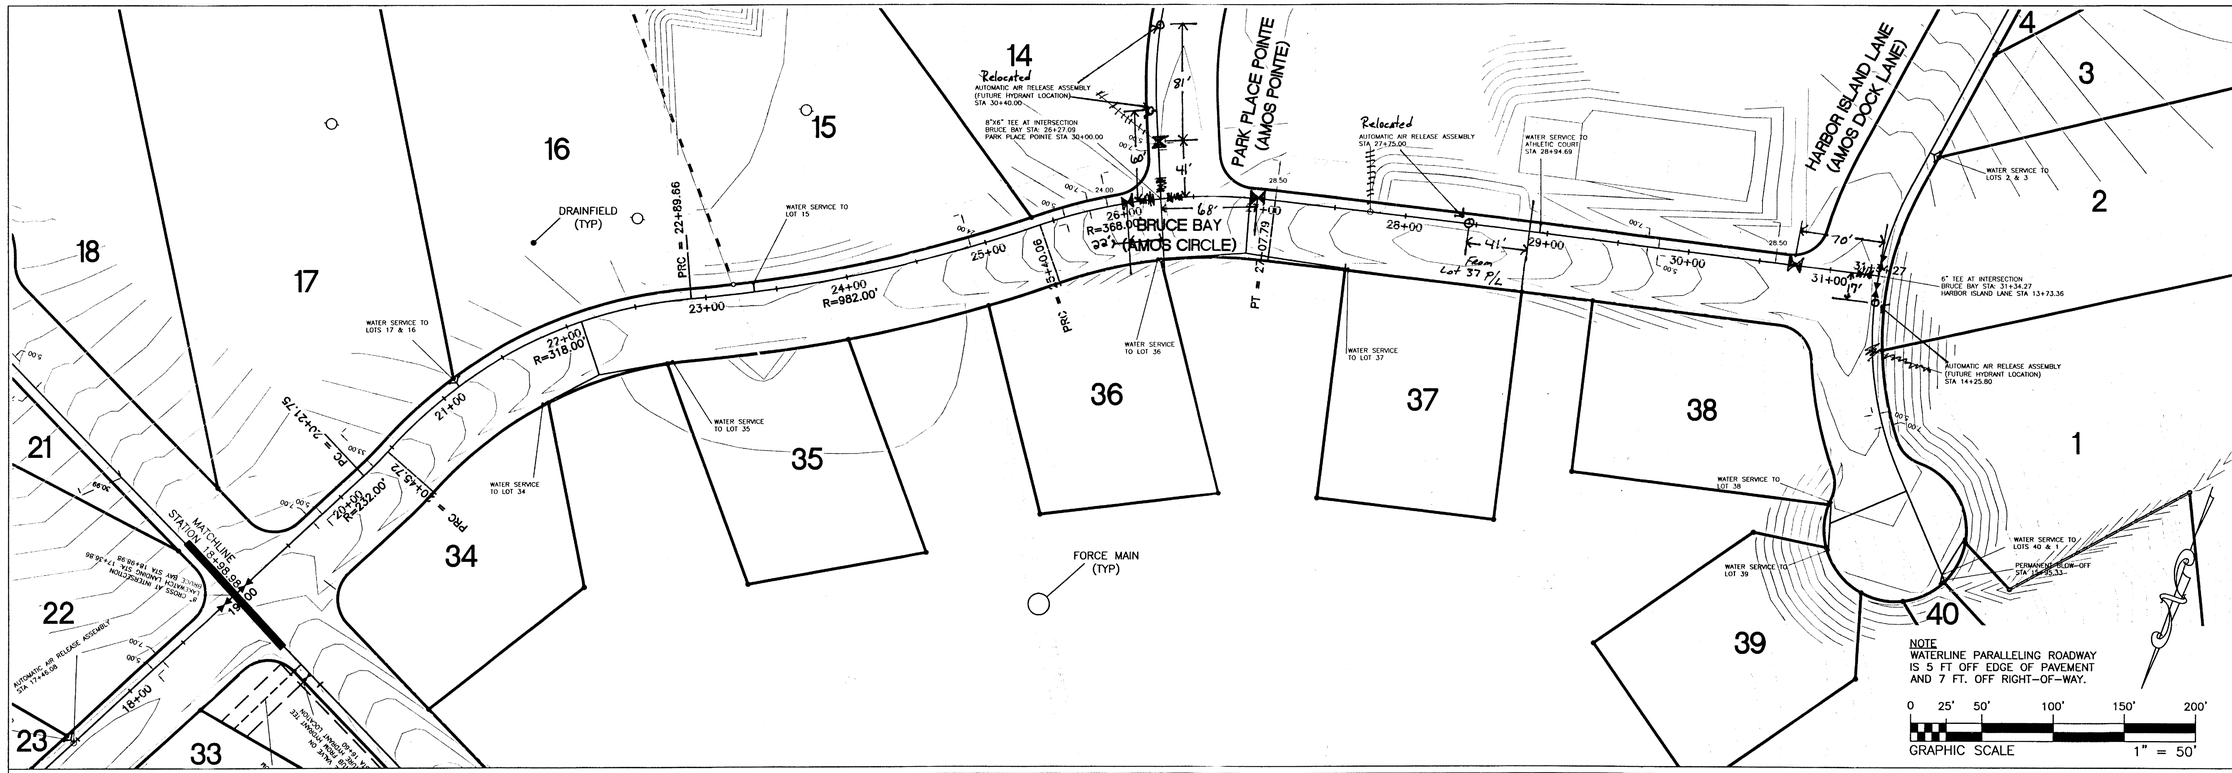

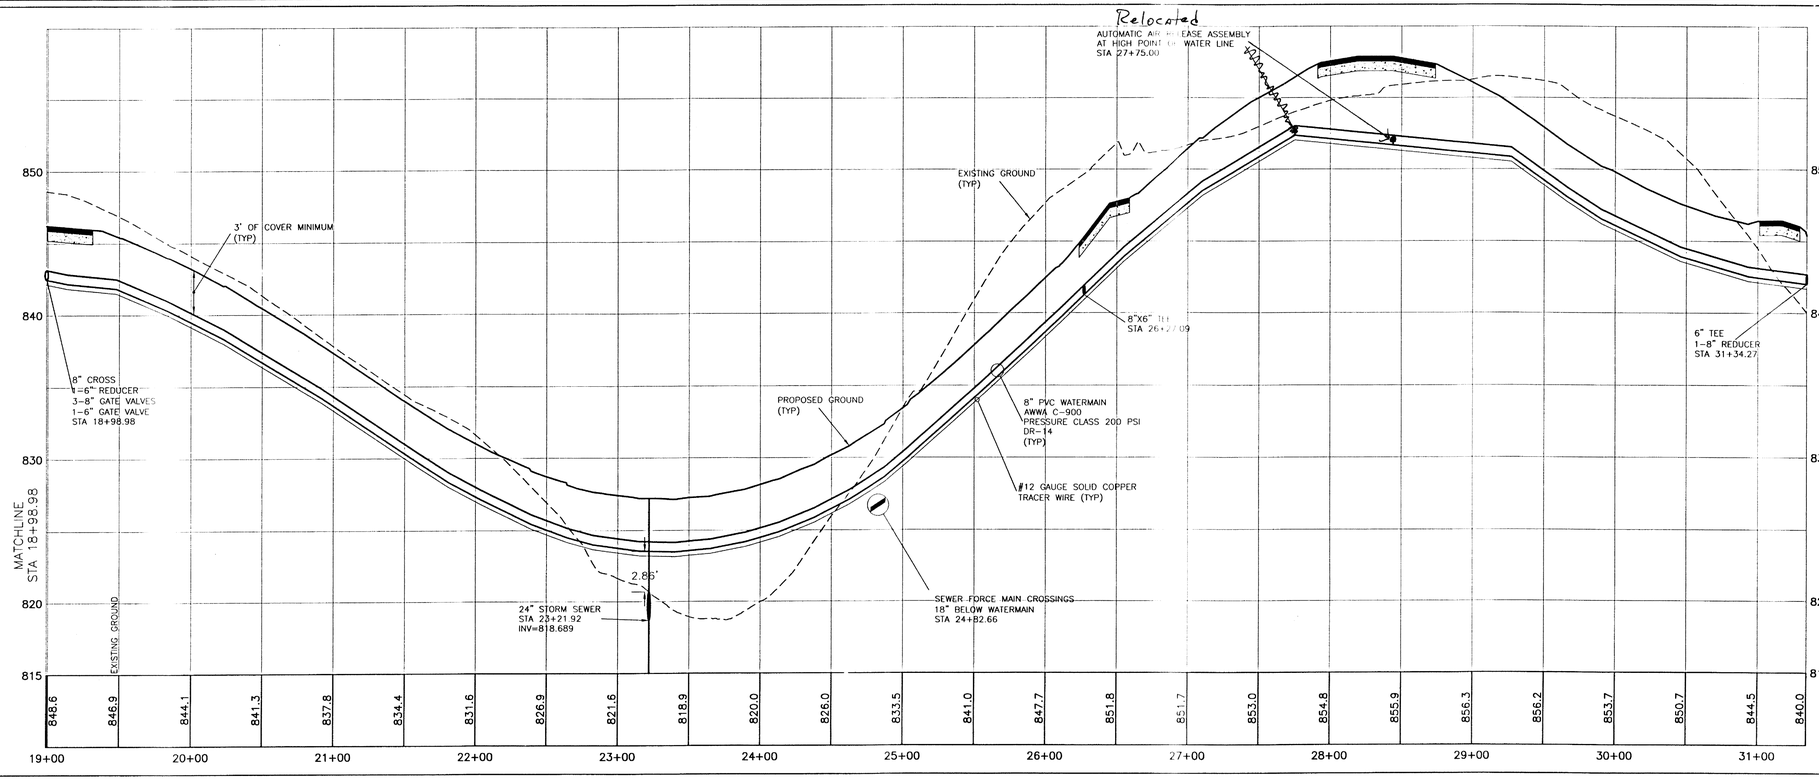

As-Built's

SCALE
1" = 50' HORIZ.
1" = 5' VERT.

REVISIONS			
DESCRIPTION	DATE	APPROVAL	

Stone Engineering
P.O. BOX 1058
Rocky Mount, Virginia 24151
(540) 483-0078
(540) 483-5250 fax

DESIGN	CDS
DRAFT	CDS
CHECK	RDS

PLAN & PROFILE - BRUCE BAY
THE LAKEWATCH CLUB
LOCATED ON DUDLEY AMOS ROAD - S.R. 601
GILLS CREEK MAGISTERIAL DISTRICT
FRANKLIN COUNTY, VIRGINIA

DATE	07/10/09
SCALE	AS SHOWN
SHEET	7 OF 13
PROJECT NUMBER	08094

F:\Projects\2008\08094 The Lakewatch Club\08094 The Lakewatch Club.dwg