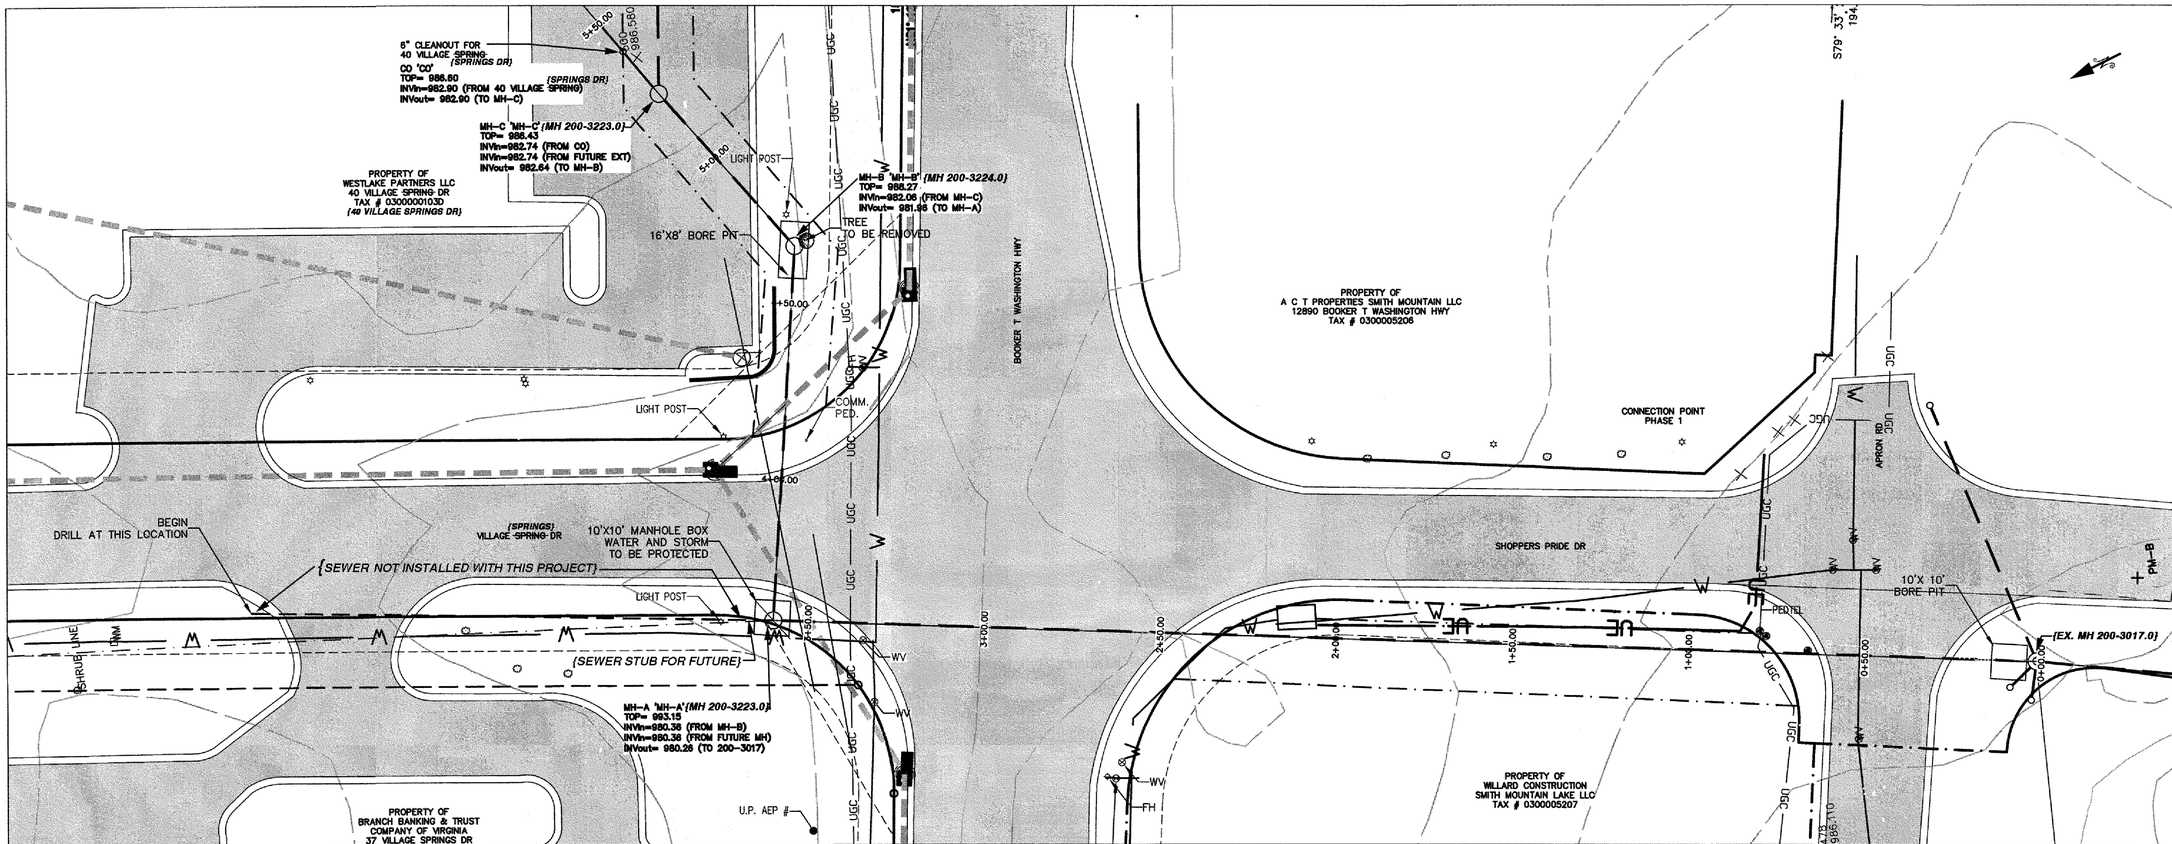

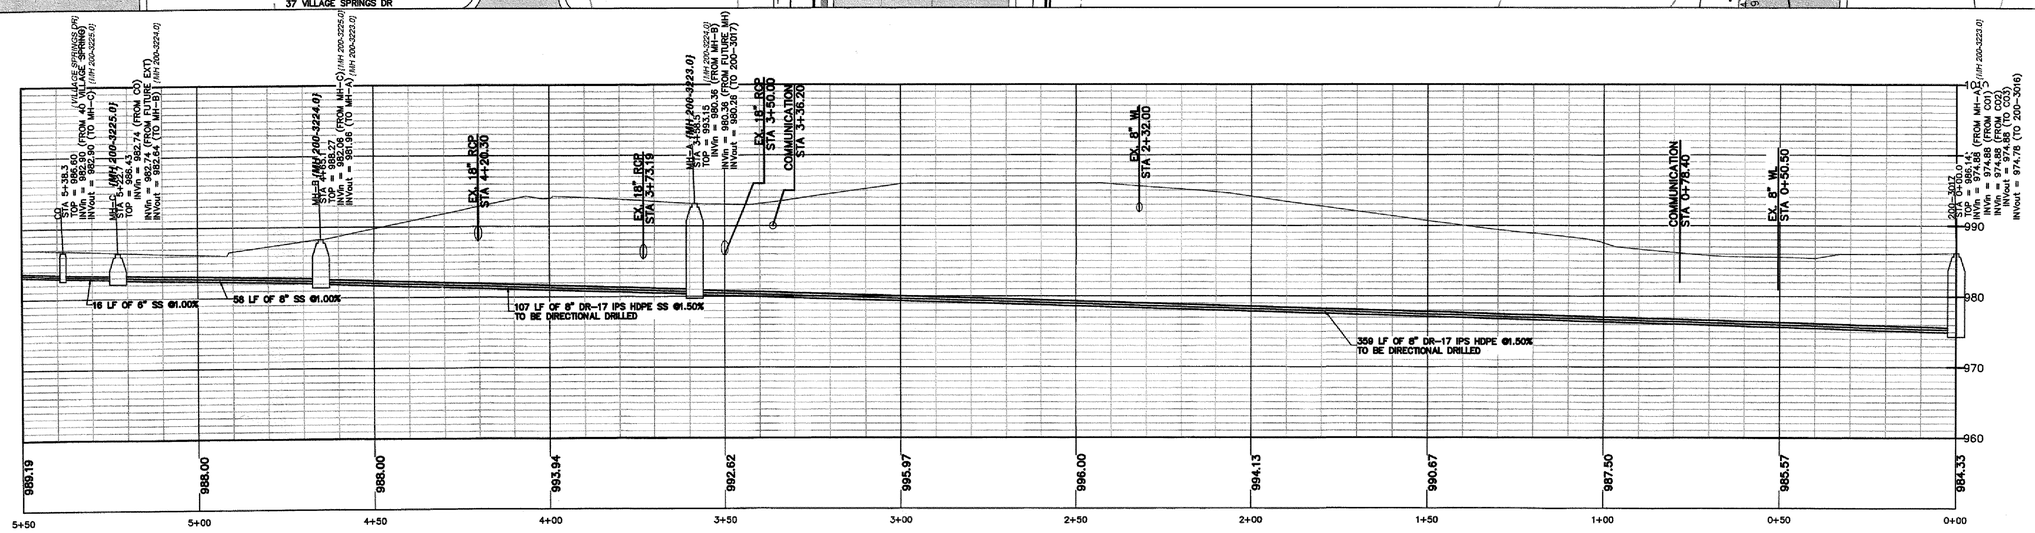

WESTLAKE SEWER
SCALE
VERTICAL: 1" = 10'
HORIZONTAL: 1" = 20'

WESTERN VIRGINIA WATER AUTHORITY
ENGINEERING SERVICES
601 S JEFFERSON ST, SUITE 300
ROANOKE, VA 24011
540-853-5641 or 540-853-5770

COMMONWEALTH OF VIRGINIA
DAVID M. VOGELSONG
Lic. No. 023274
REGISTERED PROFESSIONAL ENGINEER

WESTLAKE SEWER
{FIELD CONFIRMATION}

SEWER CONCEPT PLAN

Rev	Description	Date	By

Designed: AAS
Drawn: AAS
Checked: DMV
Approved:
Date: 6-12-14
Project:

1
Sheet 1 of 1

{UPDATED: 10/06/2021}

{10/19-20/2010} Installed by Field Ops (Taft Beasley) ~~{per plan}~~
{07/29/2014 ***GPS'ed BY WESTERN VIRGINIA WATER AUTHORITY ENGINEERING DEP'T}***