SS-100 SEWER PLAN

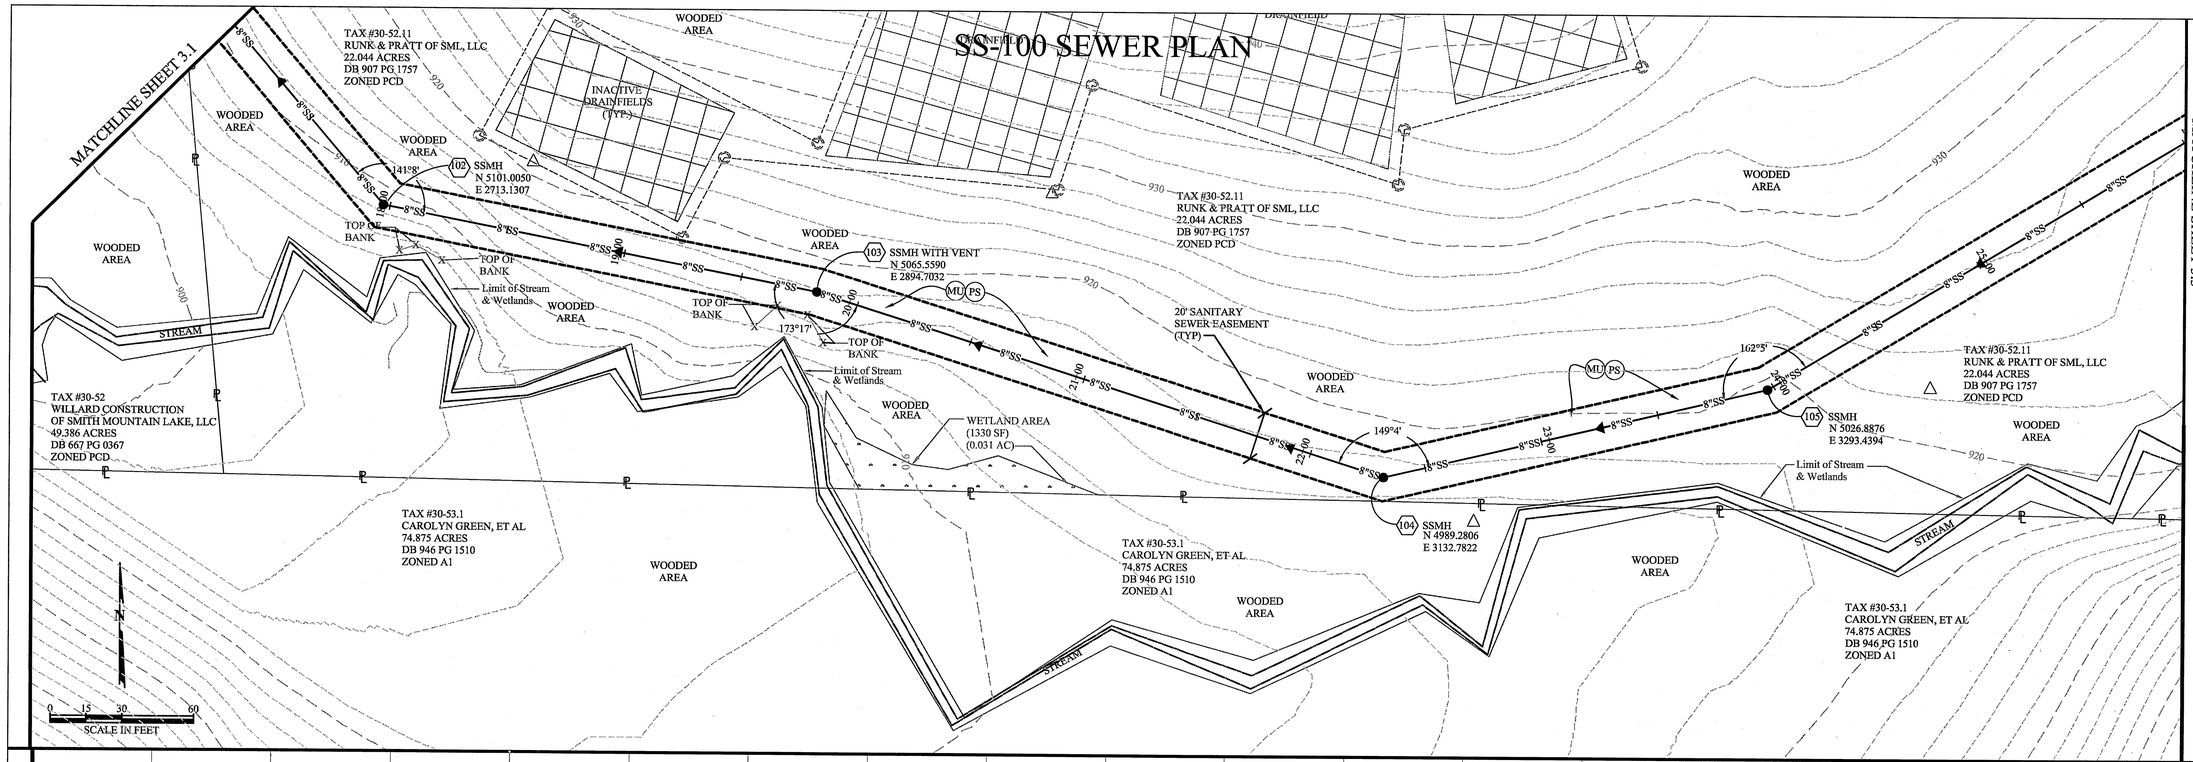

SS-100 SEWER PROFILE

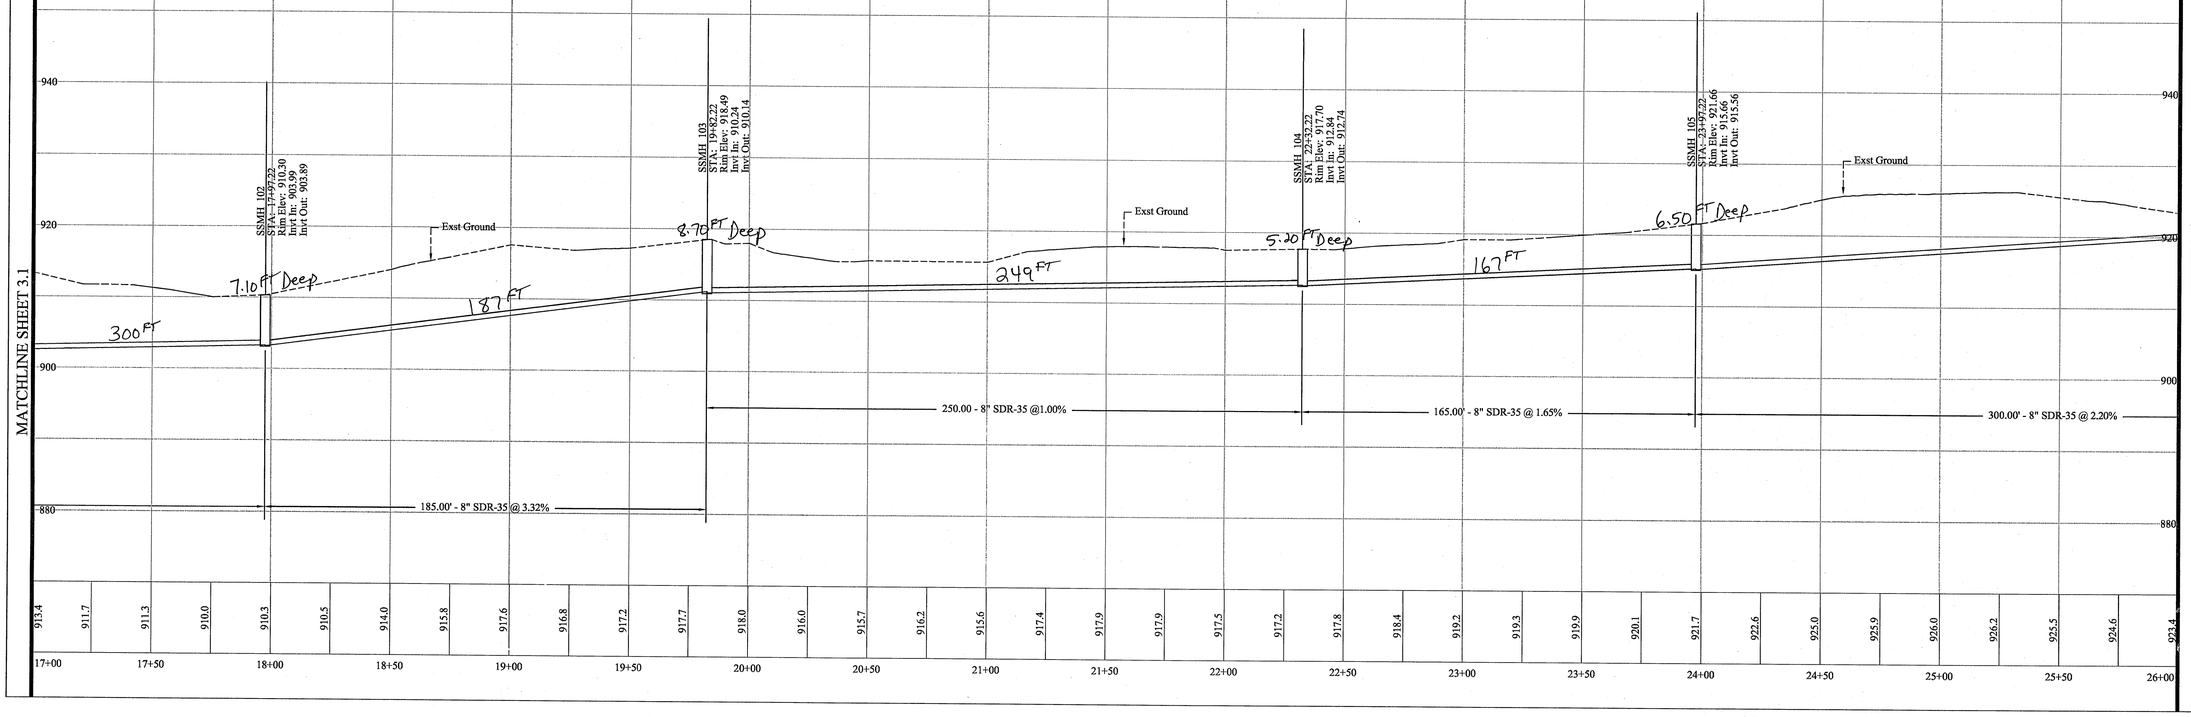

WESTERN VIRGINIA WATER AUTHORITY
ENGINEERING SERVICES
601 S JEFFERSON ST, SUITE 300
ROANOKE, VA 24011
540-853-5641

COMMONWEALTH OF VIRGINIA
DAVID M. VOGELSONG
Lic. No. 023274
PROFESSIONAL ENGINEER

WESTLAKE SEWER EXTENSION PHASE 1

GRAVITY SEWER SS100 PLAN & PROFILE

Rev	Description	Date	By

Designed: DMV
Drawn: LBR
Checked: JGR
Approved: DMV
Date: 4/27/12
Project: WSE

C3.2
Sheet 5 of 10