SS-100 SEWER PLAN

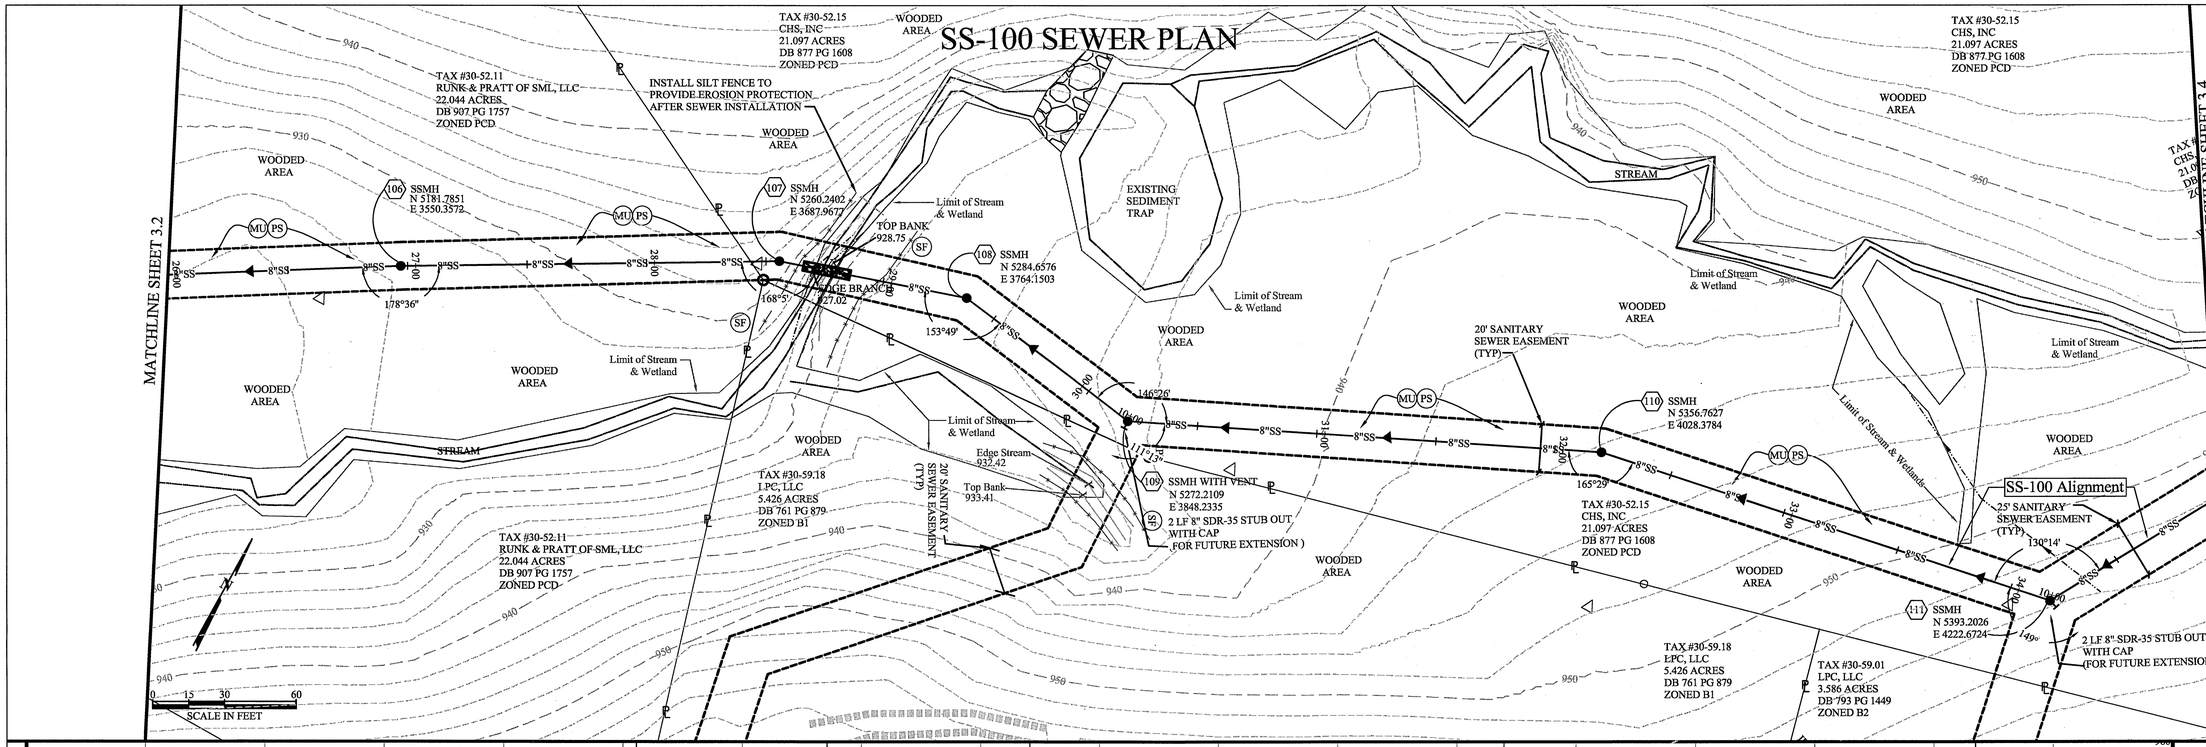

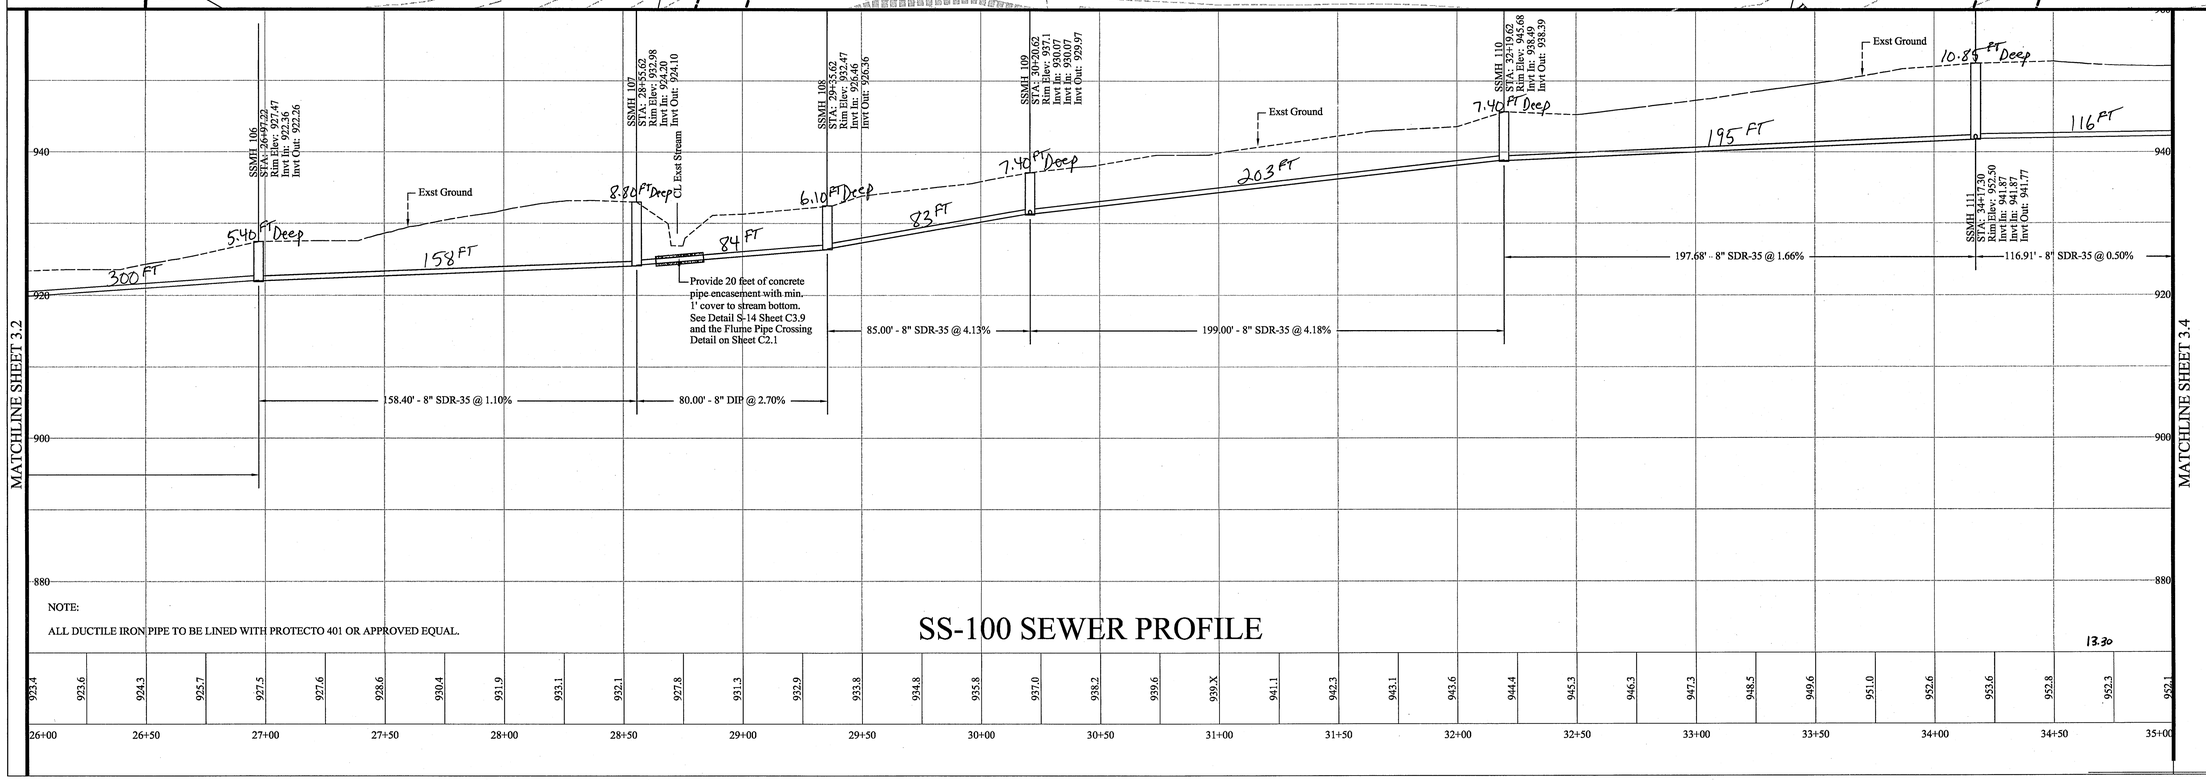

NOTE:

ALL DUCTILE IRON PIPE TO BE LINED WITH PROTECTO 401 OR APPROVED EQUAL.

SS-100 SEWER PROFILE

WESTERN VIRGINIA WATER AUTHORITY
ENGINEERING SERVICES
601 S JEFFERSON ST, SUITE 300
ROANOKE, VA 24011
540-853-5641

COMMONWEALTH OF VIRGINIA
DAVID M. VOGELSONG
Lic. No. 023274
PROFESSIONAL ENGINEER

WESTLAKE SEWER EXTENSION
PHASE 1

GRAVITY SEWER SS100
PLAN & PROFILE

Rev	Description	Date	By
1	Chg'd Coord MH107 Angle MH11	6/19/12	

Designed: DMV
Drawn: LBR
Checked: JGR
Approved: DMV
Date: 4/27/12
Project: WSE

C3.3
Sheet 6 of 10