



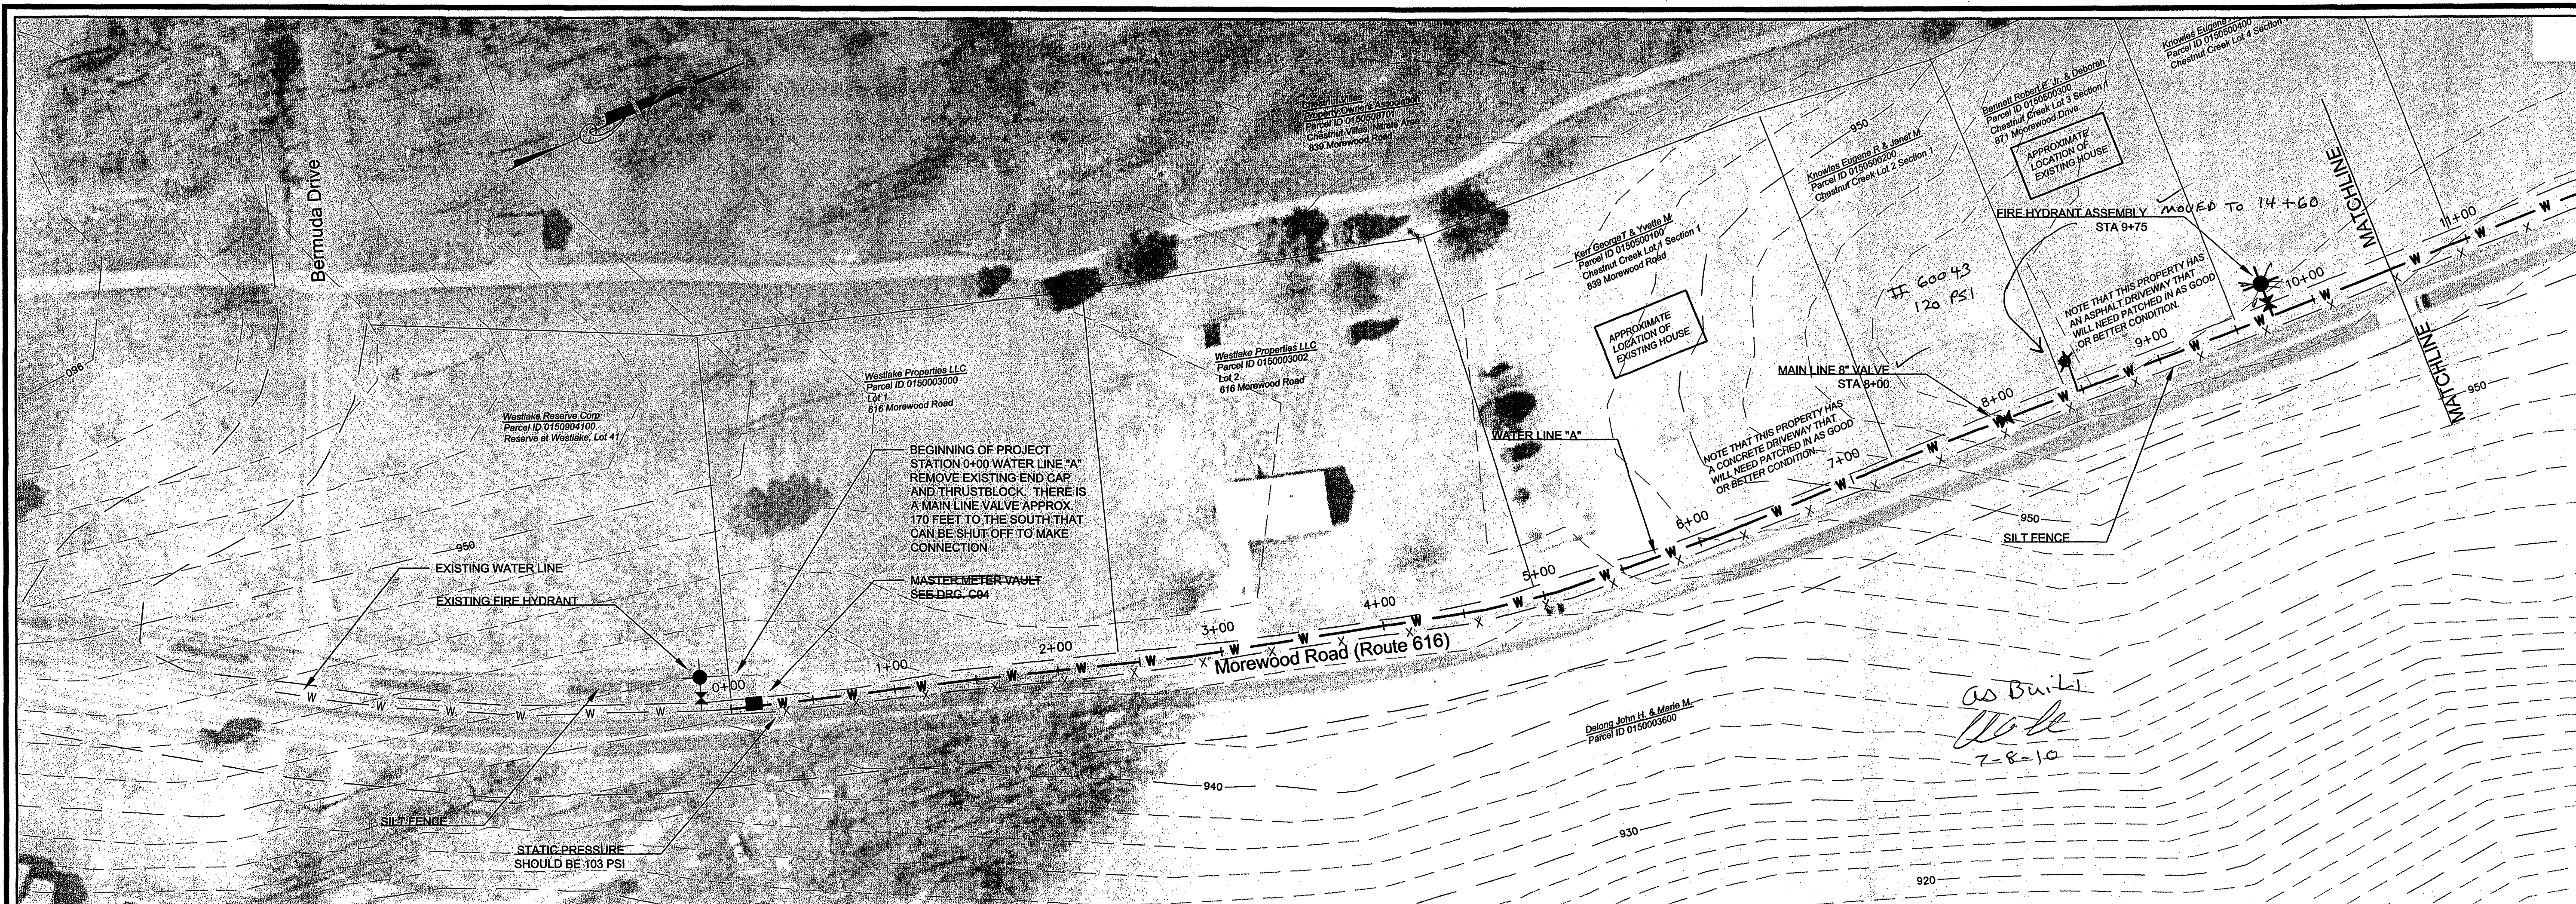


WATER LINE "A" PROFILE

SCALE: HORZ. 1" = 50' VERT. 1" = 10'

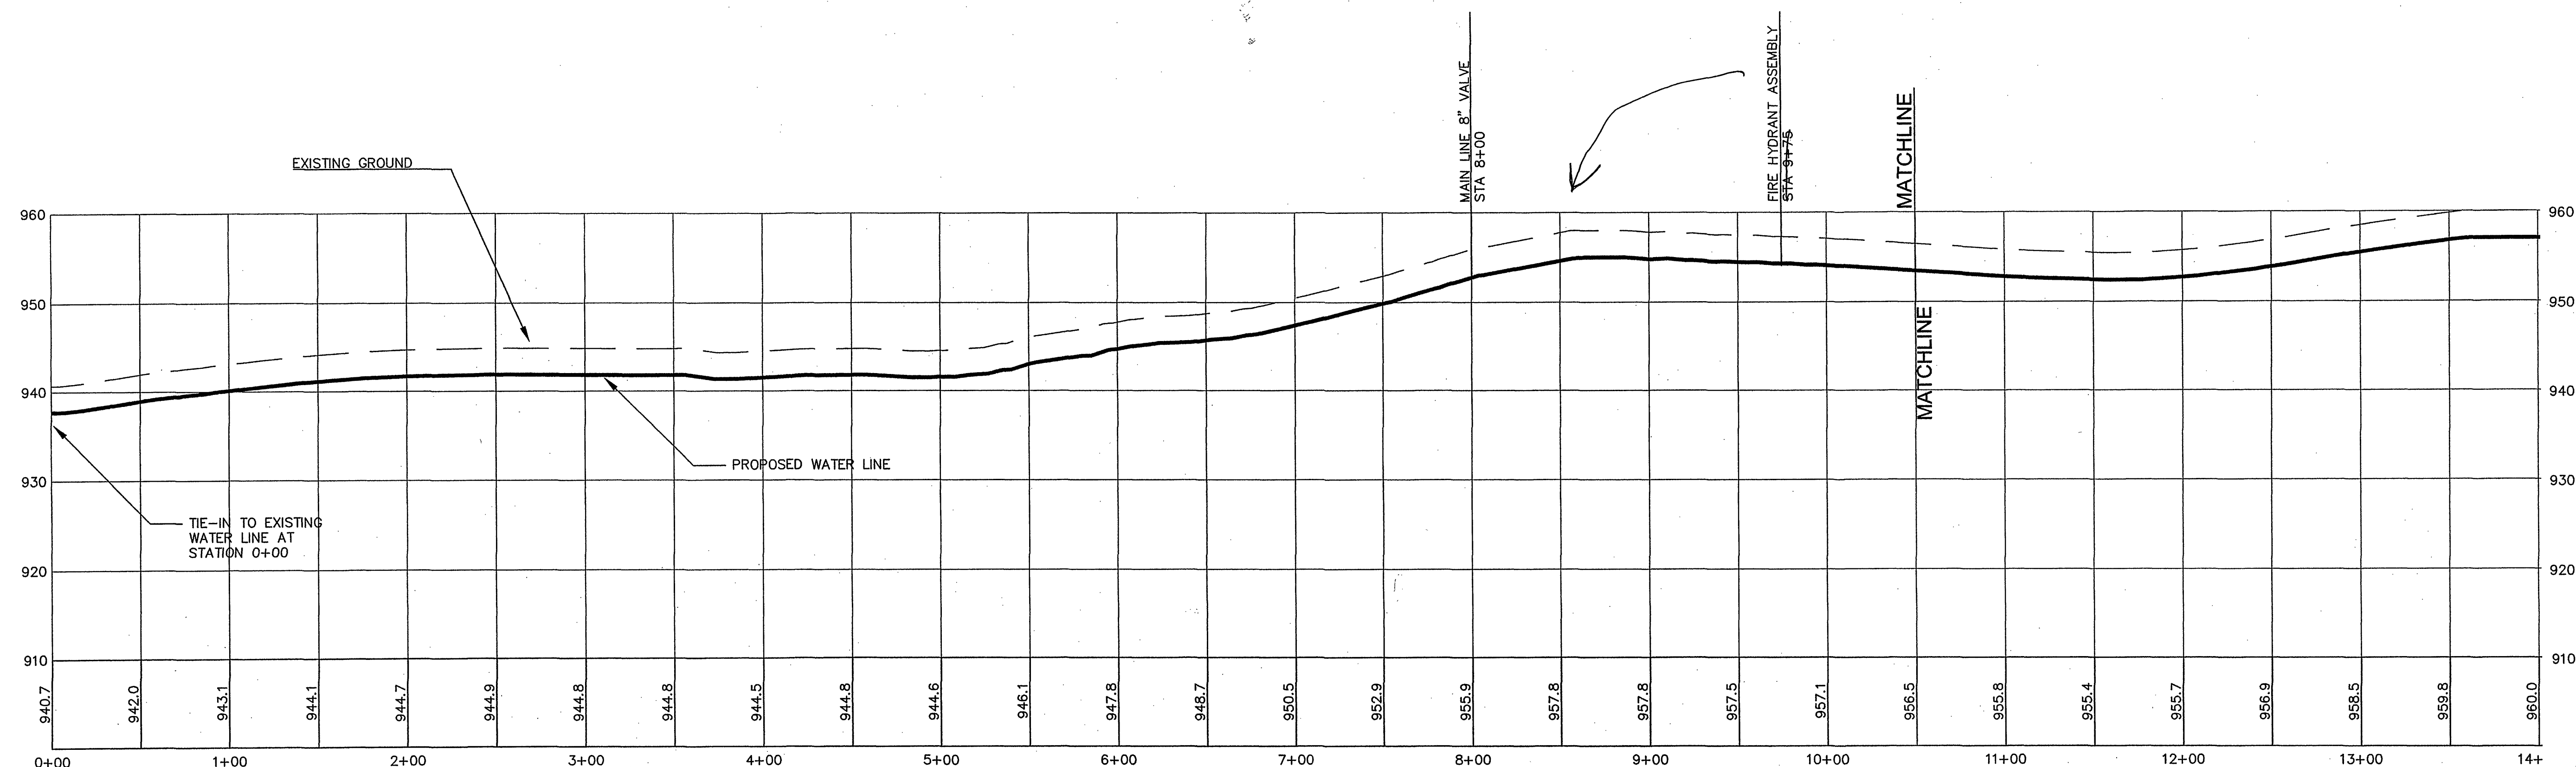

WATER LINE IS 8" DIP, CLASS 50
WATER LINE TO BE BURIED A MINIMUM OF 36" TO TOP OF PIPE
MAINTAIN A MINIMUM OF 7.5' TO EDGE OF PAVEMENT


MAPPING IS ACCUMULATION OF GOOGLE MAPS TOPOGRAPHIC INFORMATION,
FRANKLIN COUNTY GIS INFORMATION AND VARGIS IMAGERY. NO ACTUAL FIELD
SURVEY WORK WAS COMPLETED.

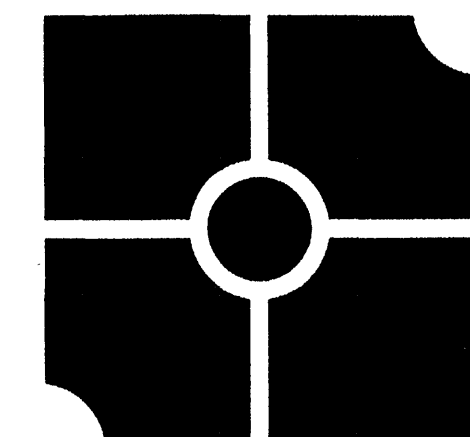

parker
DESIGN GROUP

ENGINEERS • SURVEYORS • PLANNERS • LANDSCAPE ARCHITECTS
816 Boulevard
Salem, Virginia 24153
Phone: 540-387-1153
Fax: 540-389-5767
www.parkerdg.com

These documents are the property of Parker Design Group (PDG) and may not be reproduced or used without the express permission of PDG. Any reuse of these documents without authorization of PDG will be at the sole risk of the individual or entity utilizing said documents.

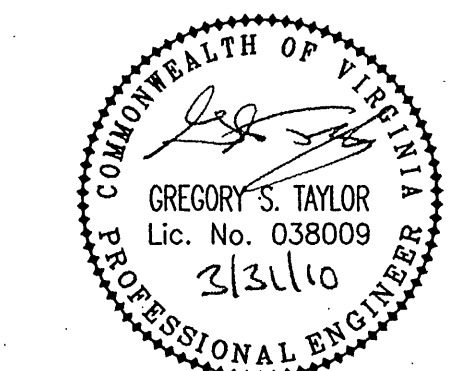

Westlake Water Company
Water System Modifications

Franklin County, Virginia

REVISIONS:

DESIGNED BY: GST

DRAWN BY: GST

CHECKED BY: GST

SCALE: As Noted

DATE: March 30, 2010

SHEET TITLE:

Water Line
1st Section

C02

02 OF 07

PROJECT NUMBER:

09-0154-01