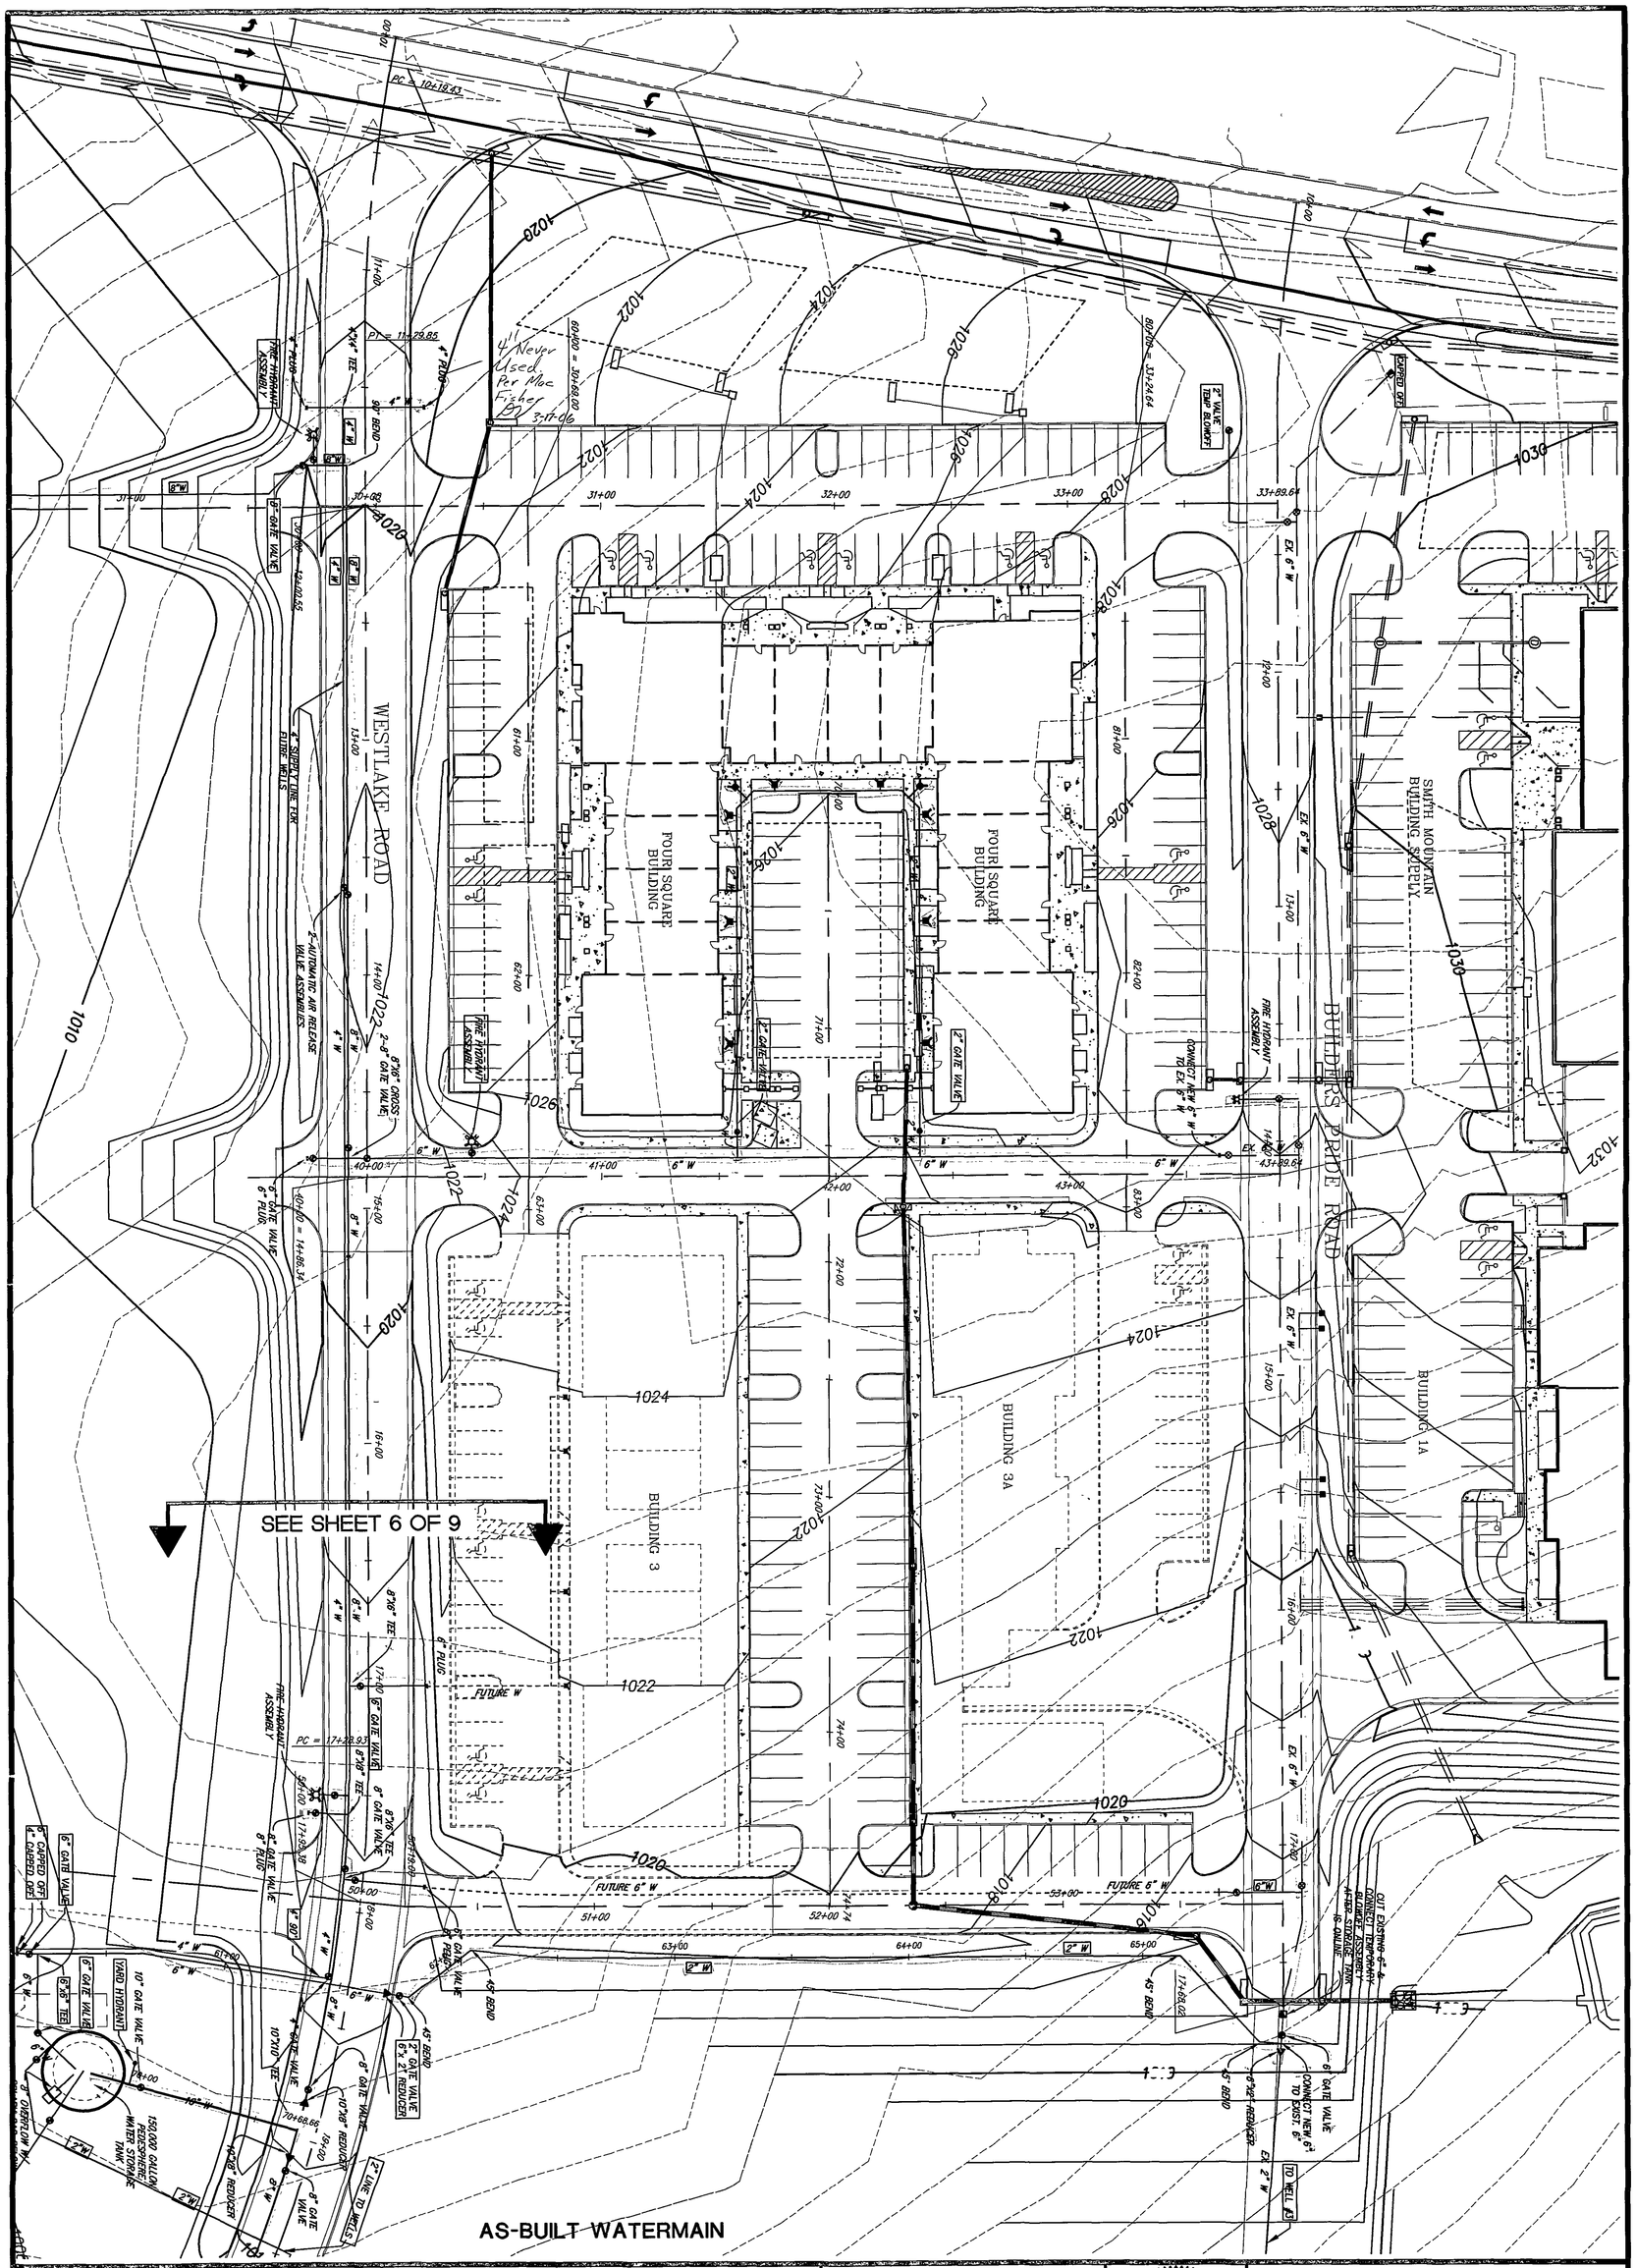

REVISIONS		
NO.	DATE	DESCRIPTION
1	02/15/06	AS-BUILT WATER MAINS
2		
3		
4		
5		

DATE: JANUARY 10, 2002
SCALE: 1" = 30'
COMMISSION NO. 00-050
CADD FILE: C:\WESTLAKE\WESTLAKE.DWG
SHEET 5 OF 10

PHASE 2 WATER LINE PLANS FOR

"WESTLAKE TOWNE CENTER"

PREPARED FOR

WILLARD CONSTRUCTION OF SMITH MOUNTAIN LAKE, LLC

GILLS CREEK MAGISTERIAL DISTRICT
FRANKLIN COUNTY, VIRGINIA

PLAN

COMMONWEALTH OF VIRGINIA
MICHAEL S. WEBB
No. 012656
PROFESSIONAL ENGINEER

LUMSDEN ASSOCIATES, P.C.
ENGINEERS-SURVEYORS-PLANNERS
ROANOKE, VIRGINIA

4664 BRAMBLETON AVENUE
P.O. BOX 20669
ROANOKE, VIRGINIA 24018

PHONE: (540) 774-4411
FAX: (540) 772-9445
E-MAIL: MAIL@LUMSDENPC.COM