
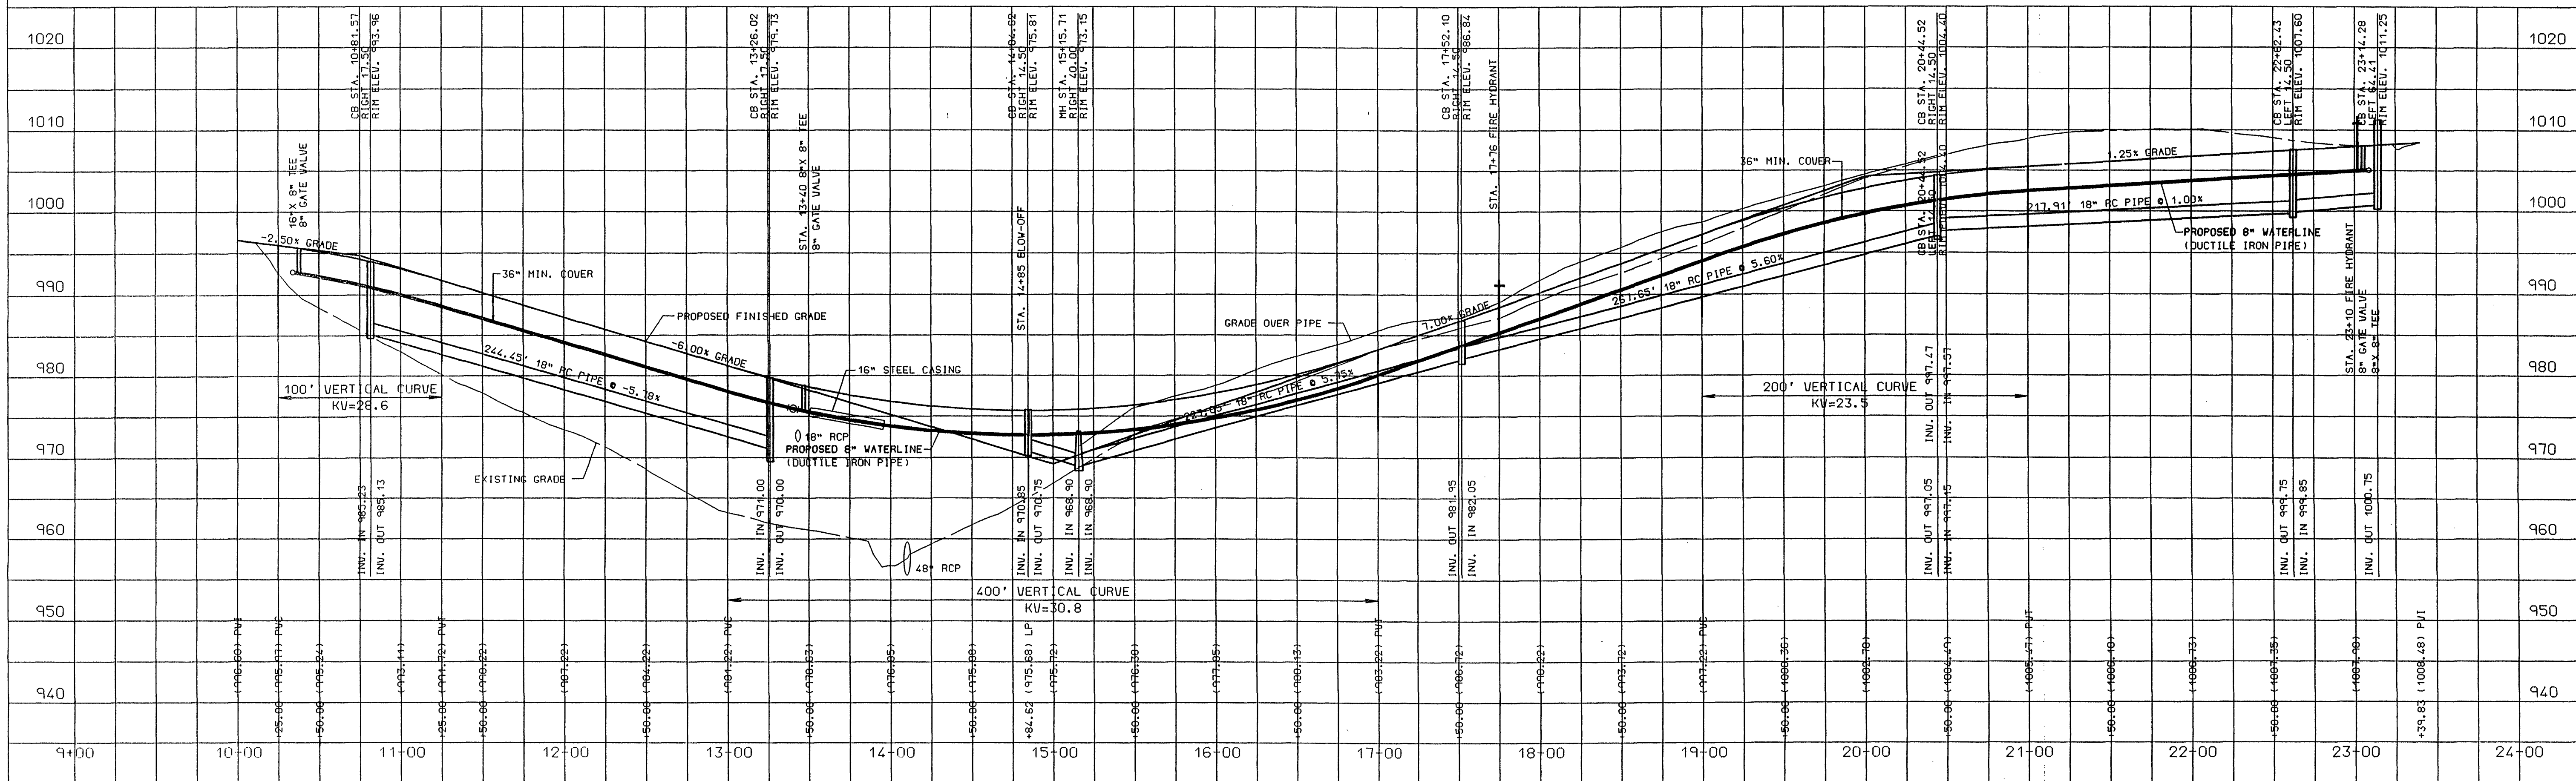


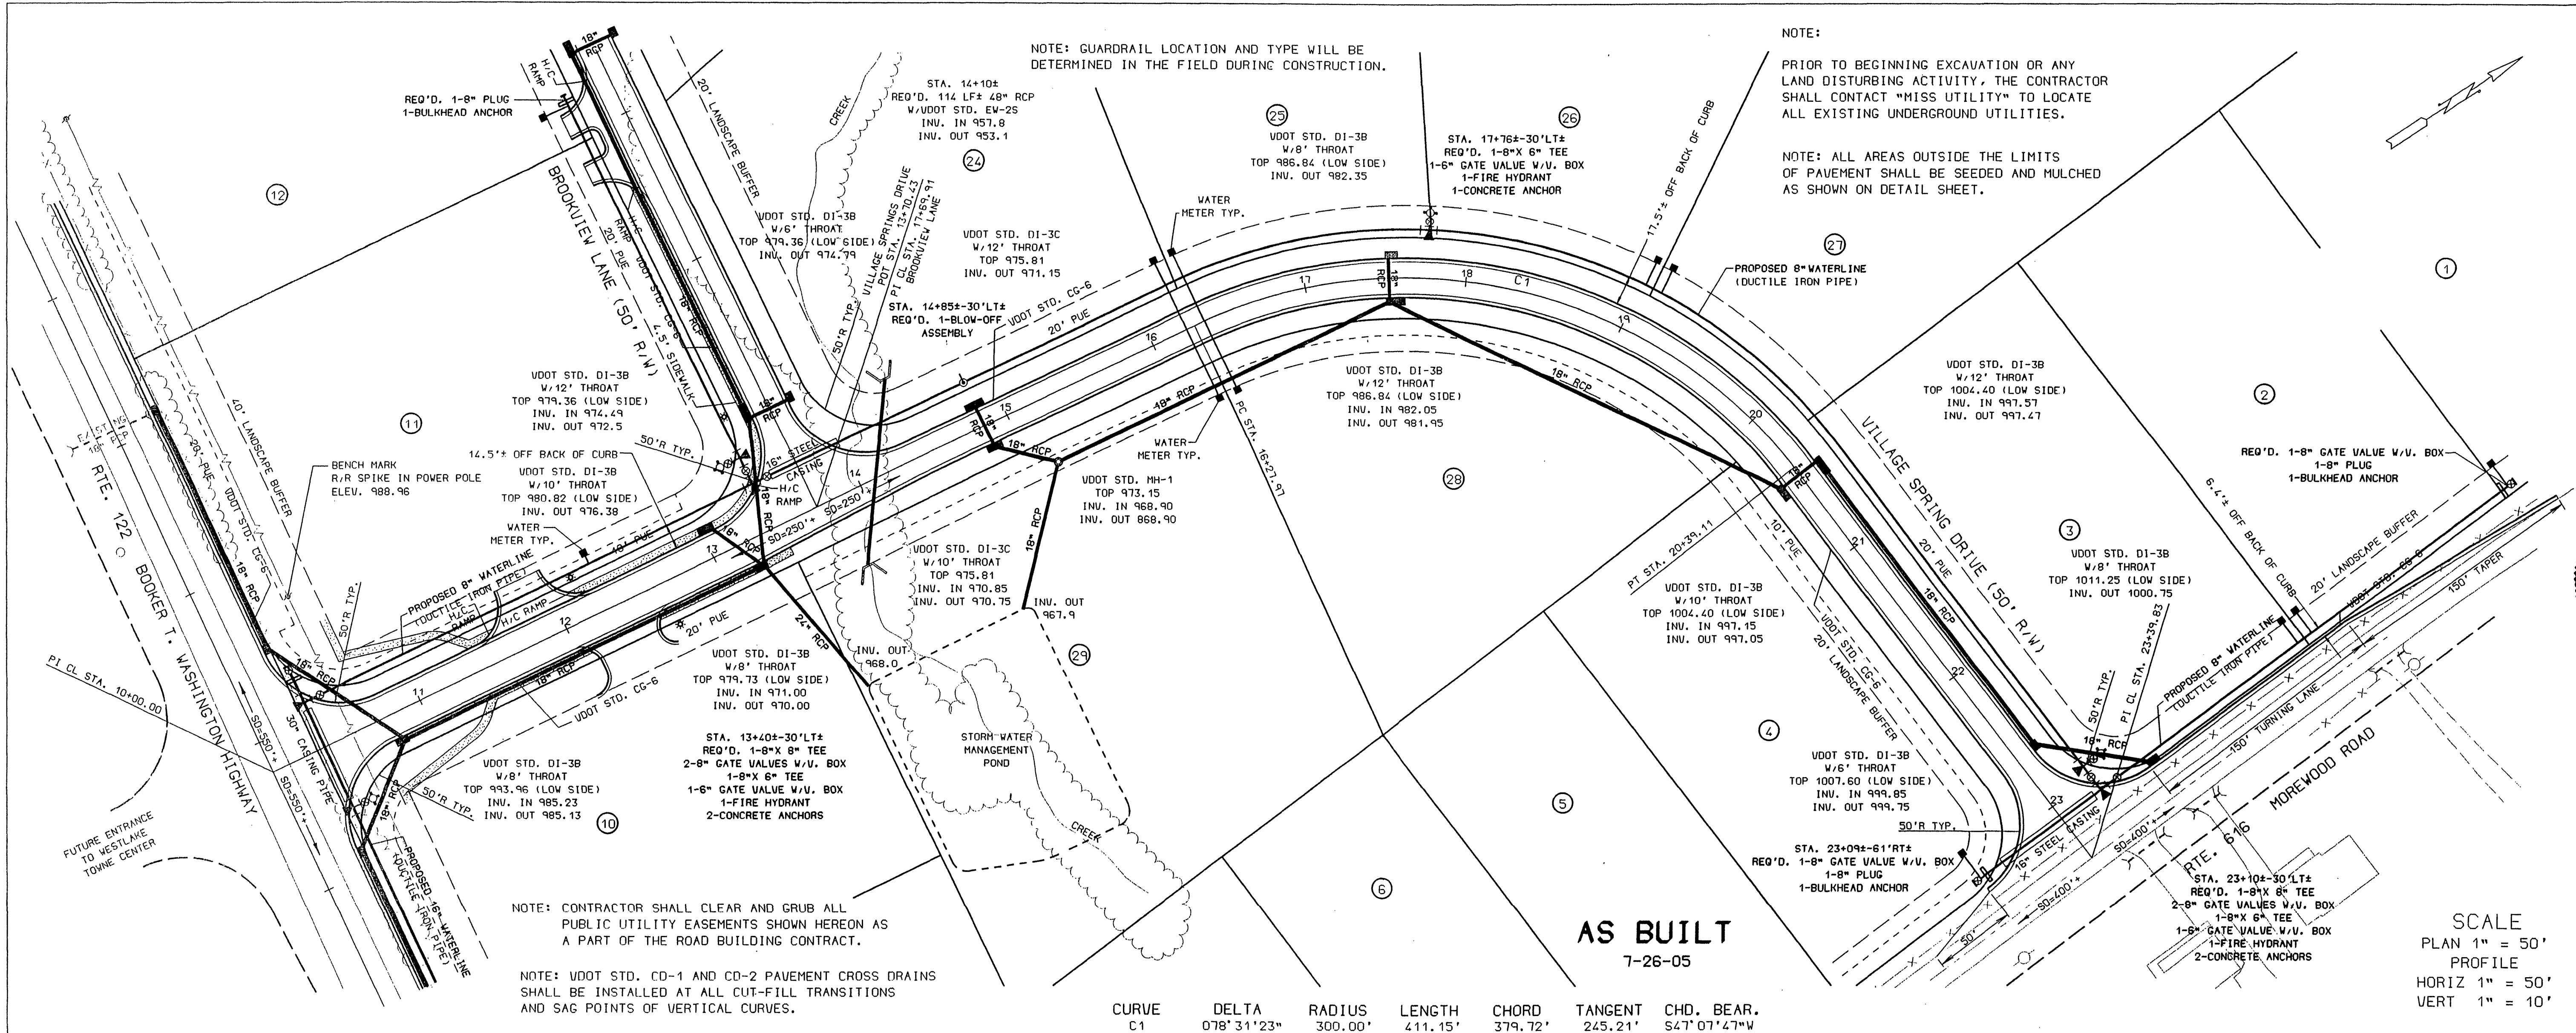

BERKLEY HOWELL & ASSOC., P.C.
ENGINEERS • SURVEYORS • PLANNERS
305 ENTERPRISE DRIVE, SUITE C
FOREST, VIRGINIA 22551
PH: (434) 385-7548 FAX: (434) 385-6178

COMMONWEALTH OF VIRGINIA
W. BERKLEY JR.
No. 00759
Professional Seal

WESTLAKE VILLAGE
BUSINESS PARK
PHASE I
WATER SYSTEM
GILLS CREEK DISTRICT FRANKLIN CO., VA.

DATE: 7-15-04

TECHNICIAN:

CHECKED BY:

REVISIONS

NO. DATE

SCALES AS SHOWN

PROJ. NO. 030066 DIV.

SHEET NO. 3 OF 6

DRAWING NO. ROAD2REV

MANUSCRIPT DRAWING NUMBER: _____ VIEWS TO CREATE THIS DRAWING: _____ FIELDBOOK IDENTIFICATION: _____ SURVEY DATUM USED: _____