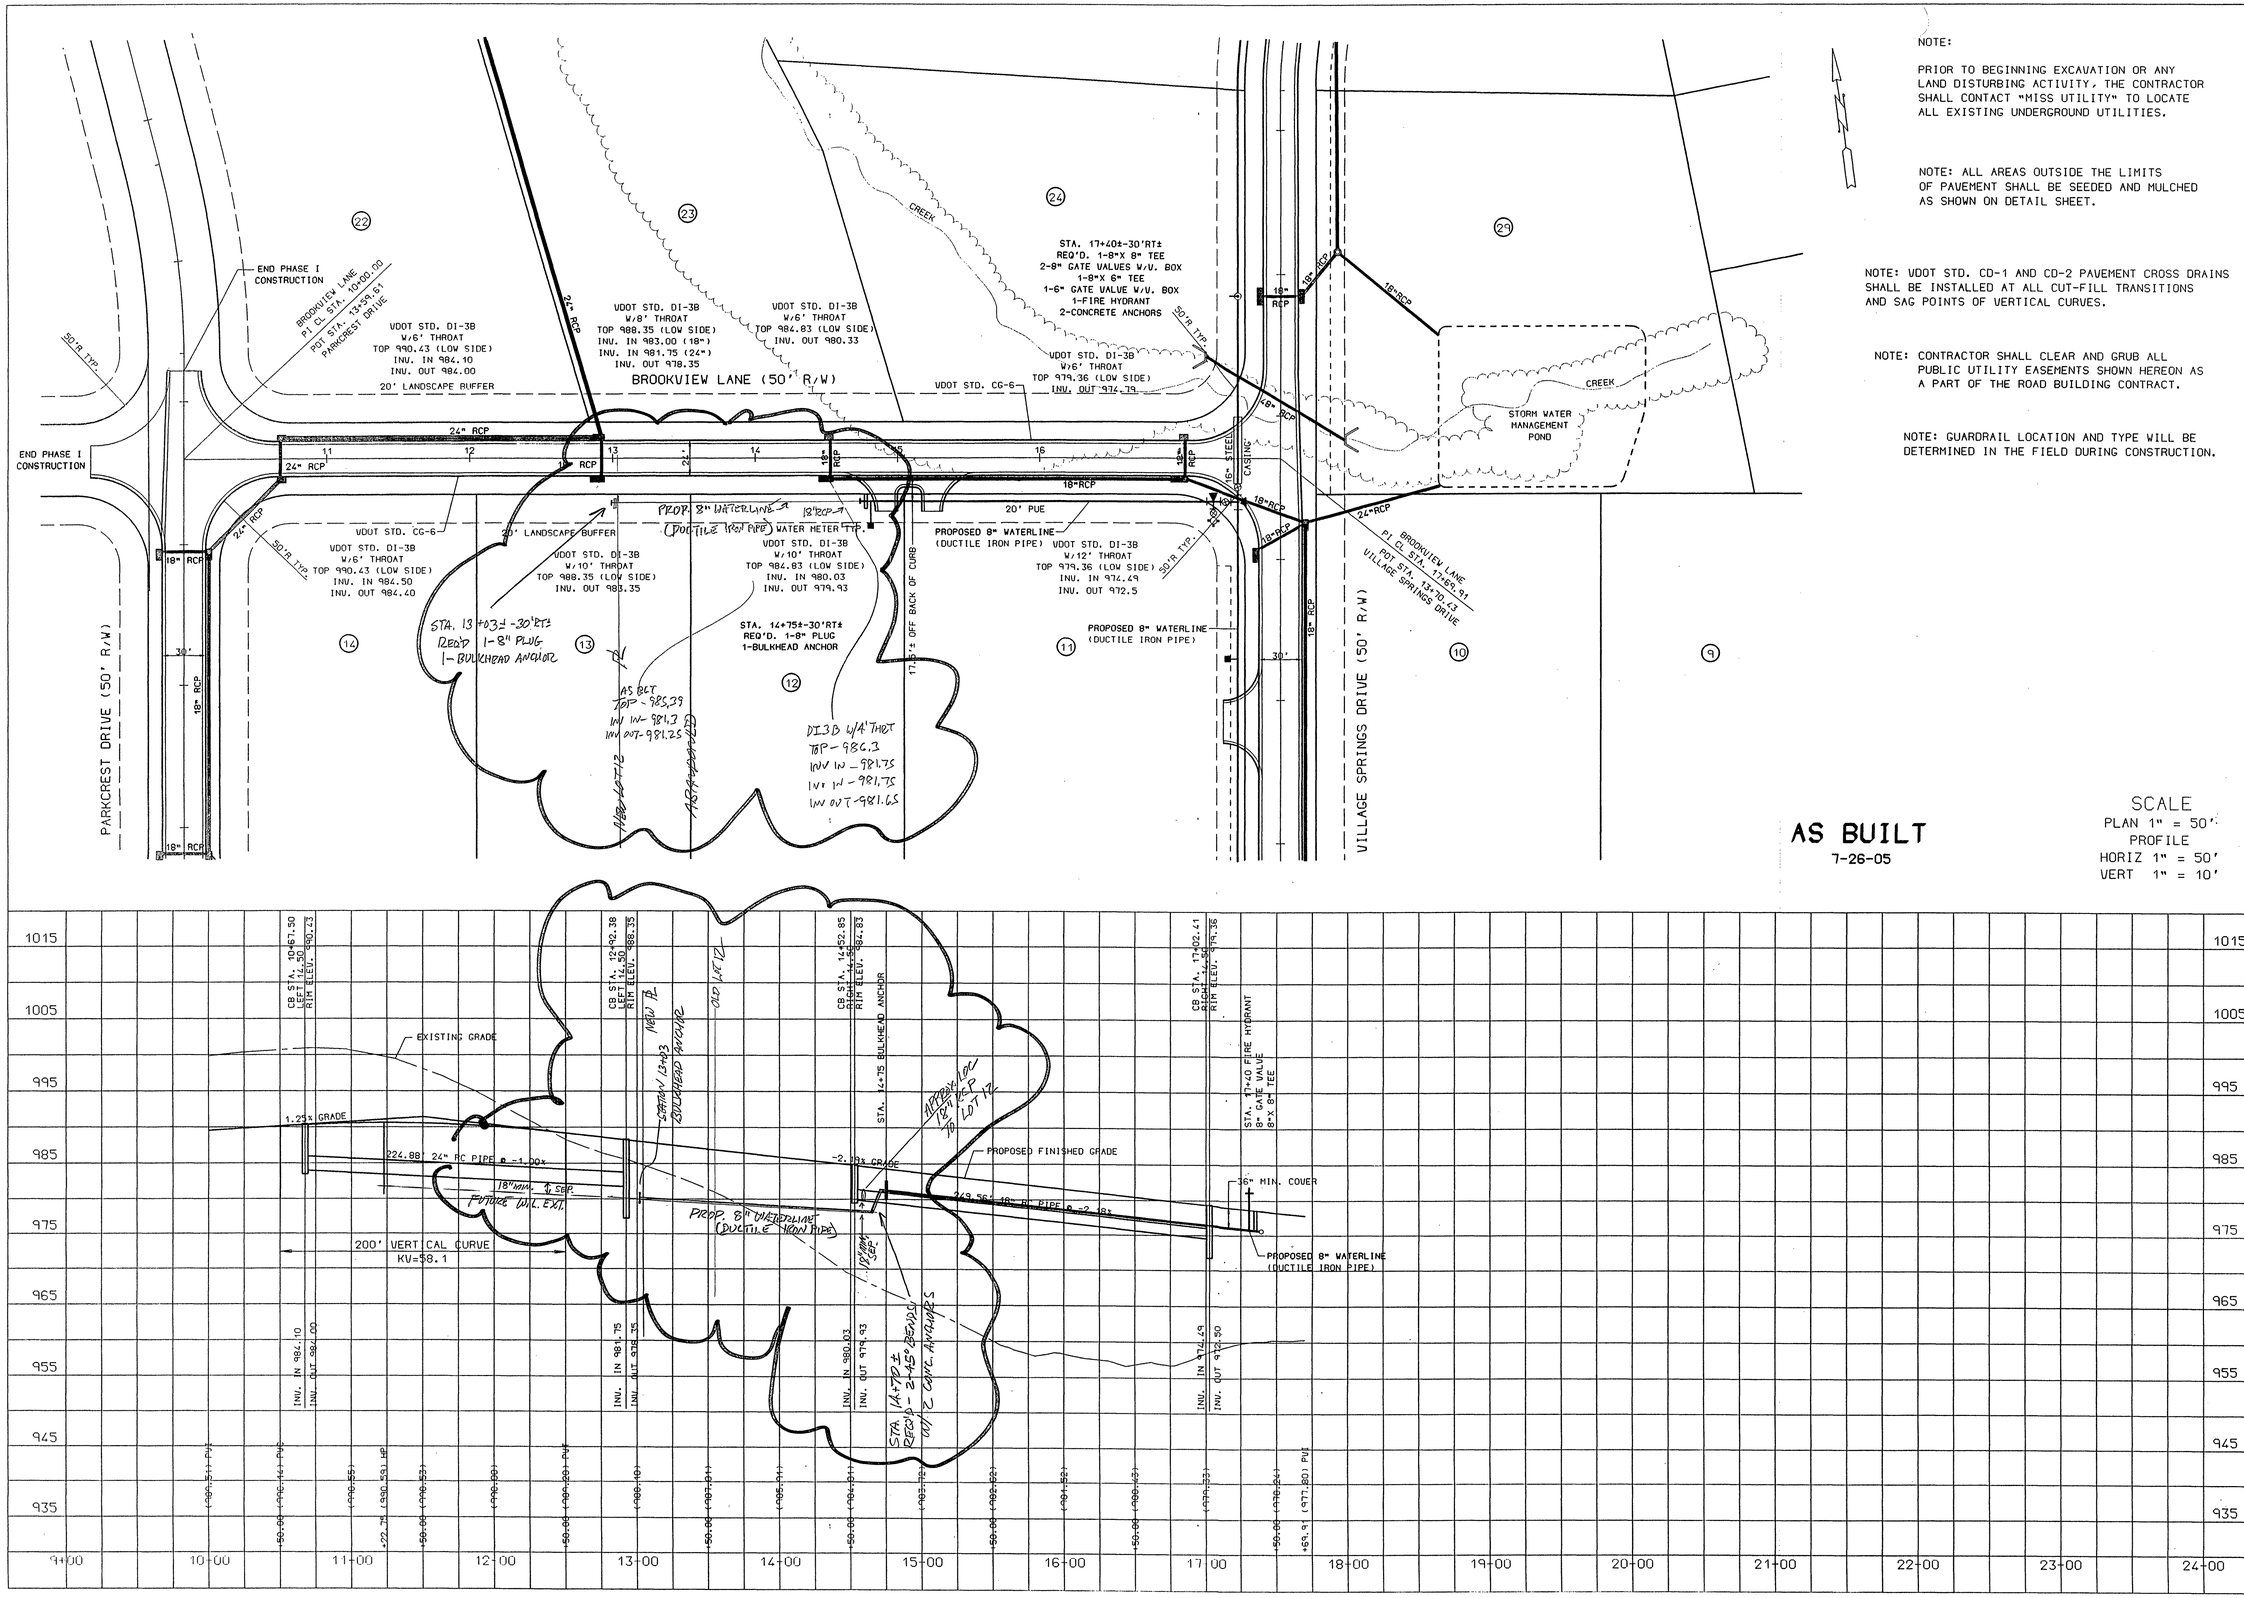

NOTE:

PRIOR TO BEGINNING EXCAVATION OR ANY LAND DISTURBING ACTIVITY, THE CONTRACTOR SHALL CONTACT "MISS UTILITY" TO LOCATE ALL EXISTING UNDERGROUND UTILITIES.

NOTE: ALL AREAS OUTSIDE THE LIMITS OF PAVEMENT SHALL BE SEEDED AND MULCHED AS SHOWN ON DETAIL SHEET.

NOTE: VDOT STD. CD-1 AND CD-2 PAVEMENT CROSS DRAINS SHALL BE INSTALLED AT ALL CUT-FILL TRANSITIONS AND SAG POINTS OF VERTICAL CURVES.

NOTE: CONTRACTOR SHALL CLEAR AND GRUB ALL PUBLIC UTILITY EASEMENTS SHOWN HEREON AS A PART OF THE ROAD BUILDING CONTRACT.

NOTE: GUARDRAIL LOCATION AND TYPE WILL BE DETERMINED IN THE FIELD DURING CONSTRUCTION.

BERKLEY HOWELL & ASSOC., P.C.
ENGINEERS • SURVEYORS • PLANNERS
306 ENTERPRISE DRIVE, SUITE C
FOREST, VIRGINIA 24551
PH: (434) 385-7548 FAX: (434) 385-6178

COMMONWEALTH OF VIRGINIA — No. 10759 — PROFESSIONAL ENGINEER — 7-26-05

WESTLAKE VILLAGE BUSINESS PARK PHASE I WATER SYSTEM

GILLS CREEK DISTRICT FRANKLIN CO., VA.

PLAN & PROFILE

DATE: 7-15-04

TECHNICIAN:

CHECKED BY:

REVISIONS

NO.	DATE

SCALES AS SHOWN

PROJ. NO. 030066 | DIV.

SHEET NO. 4 OF 6

DRAWING NO. ROAD3

SURVEY DATUM USED:

FIELDBOOK IDENTIFICATION:

VIEWS TO CREATE THIS DRAWING:

MANUSCRIPT DRAWING NUMBER: