




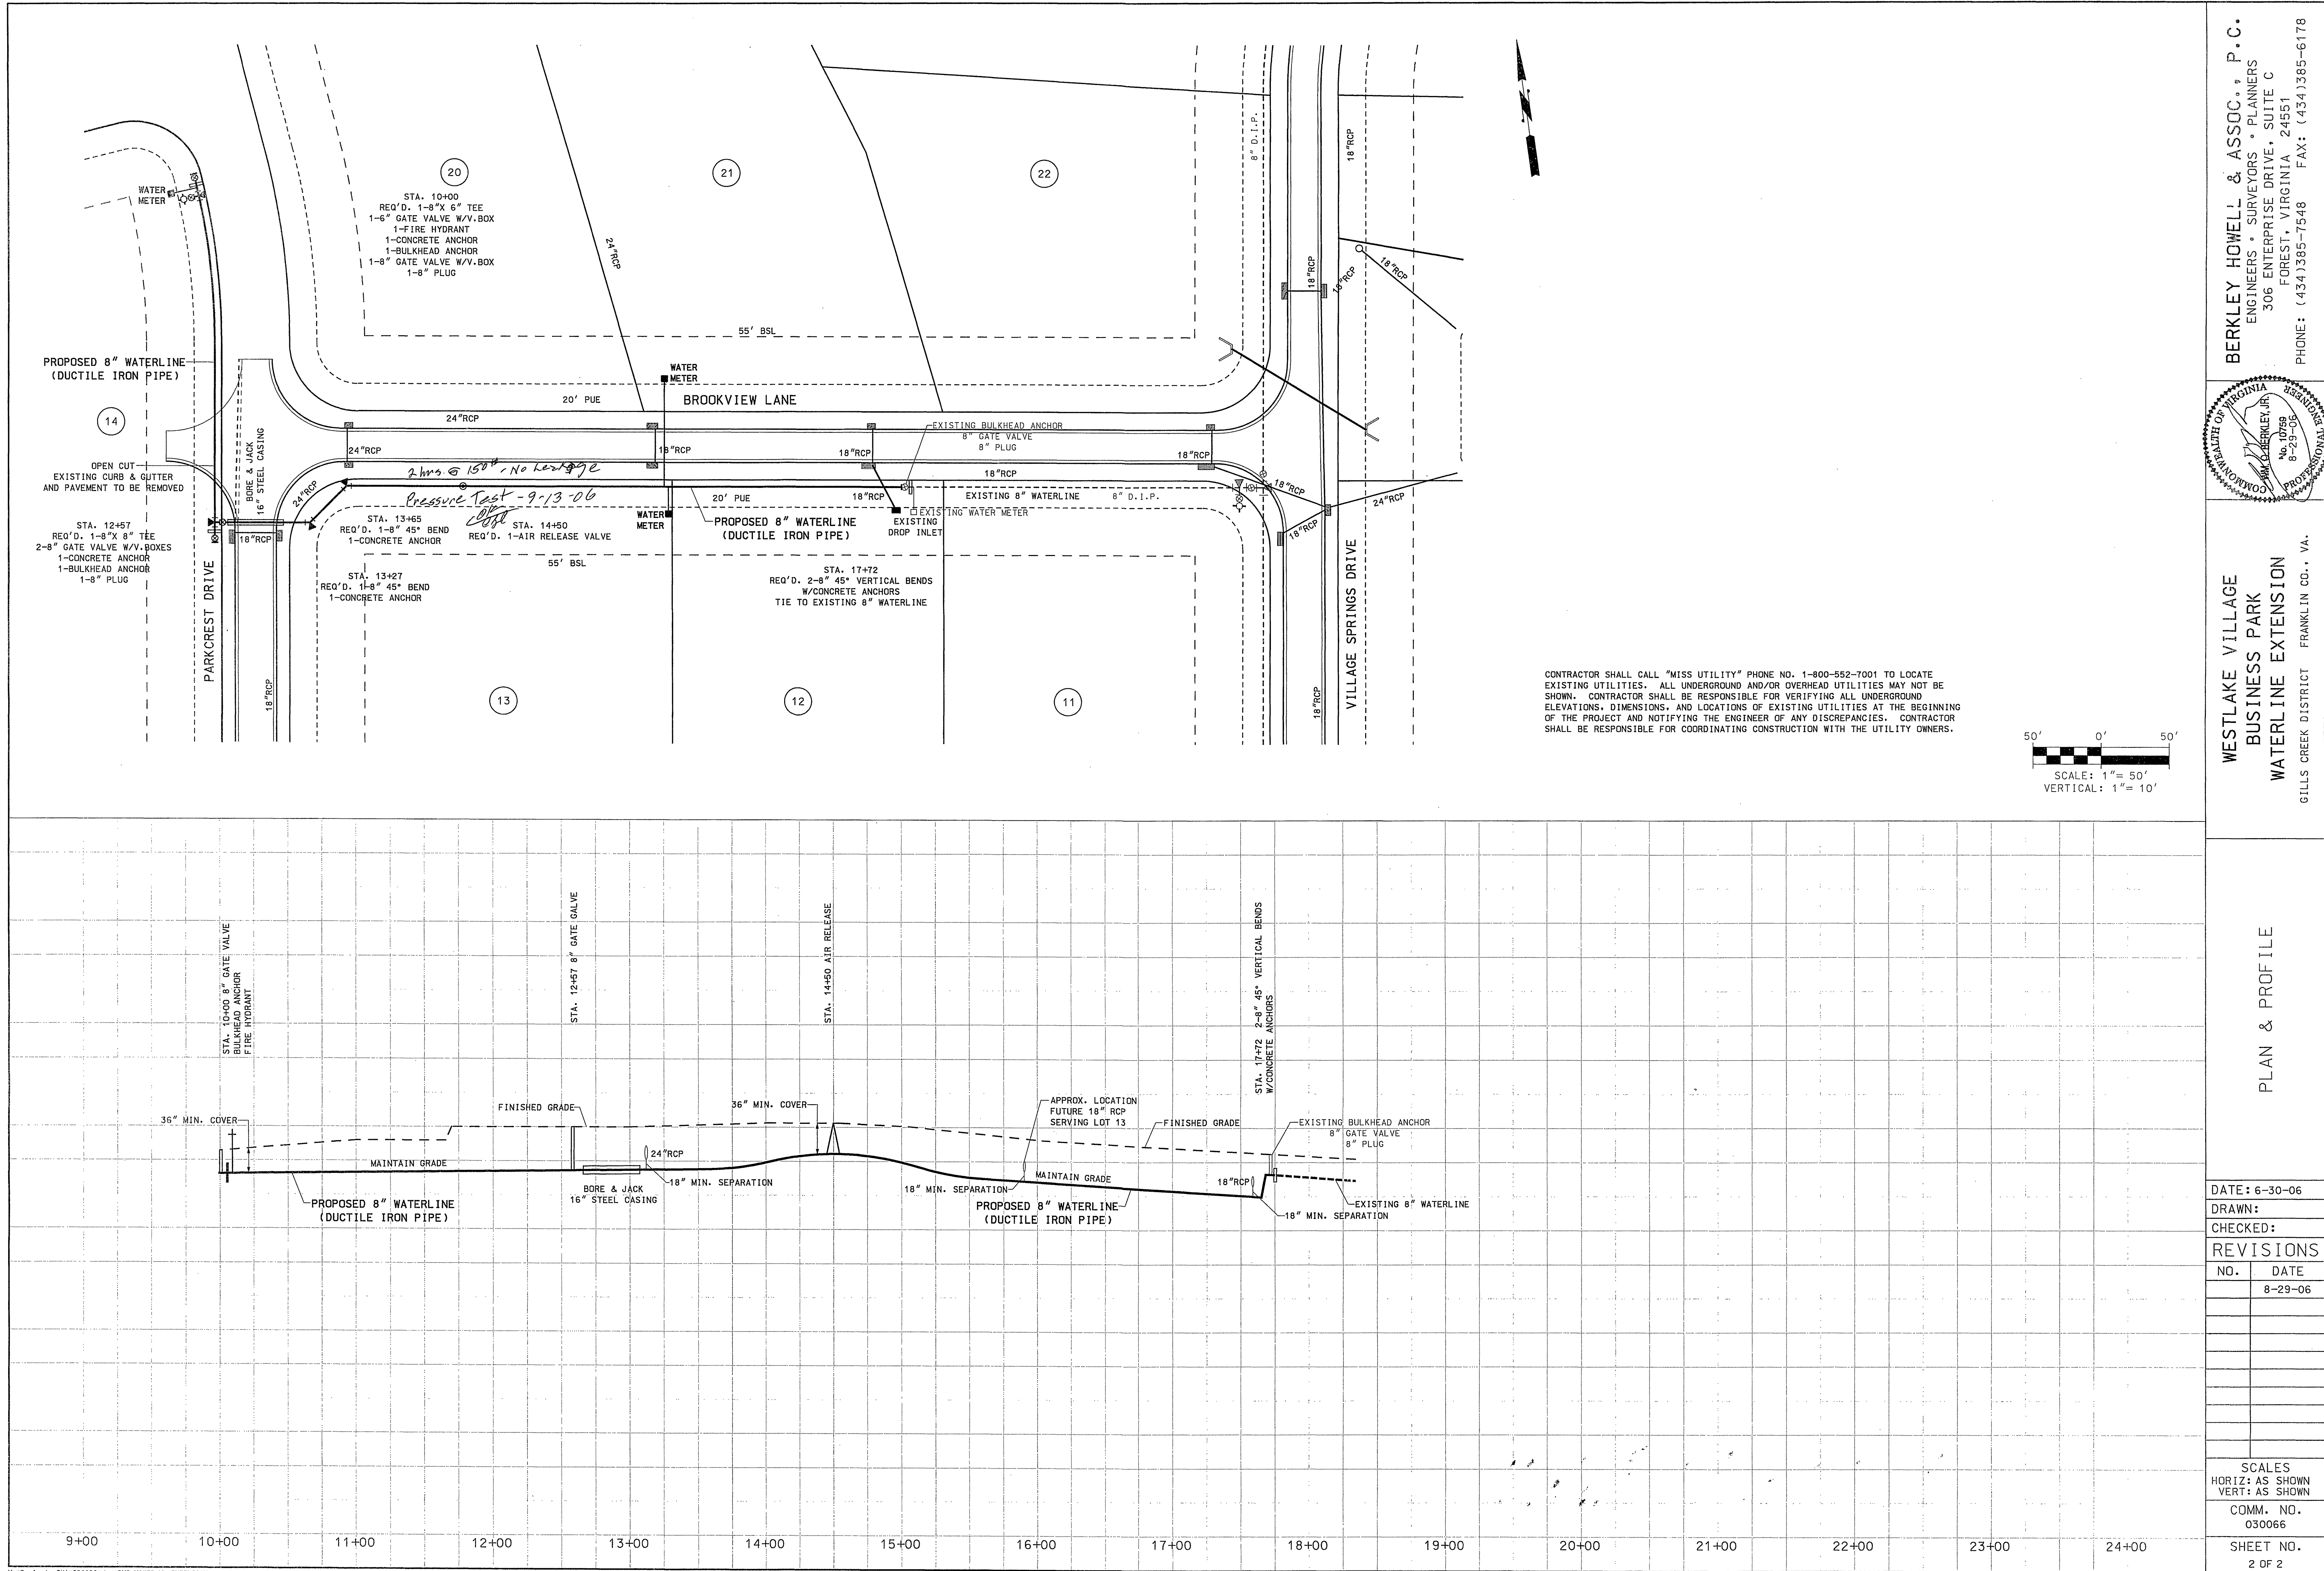

CONTRACTOR SHALL CALL "MISS UTILITY" PHONE NO. 1-800-552-7001 TO LOCATE EXISTING UTILITIES. ALL UNDERGROUND AND/OR OVERHEAD UTILITIES MAY NOT BE SHOWN. CONTRACTOR SHALL BE RESPONSIBLE FOR VERIFYING ALL UNDERGROUND ELEVATIONS, DIMENSIONS, AND LOCATIONS OF EXISTING UTILITIES AT THE BEGINNING OF THE PROJECT AND NOTIFYING THE ENGINEER OF ANY DISCREPANCIES. CONTRACTOR SHALL BE RESPONSIBLE FOR COORDINATING CONSTRUCTION WITH THE UTILITY OWNERS.

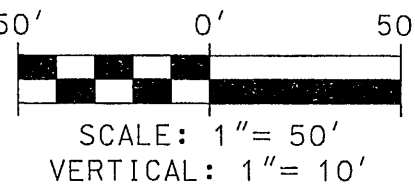

BERKLEY HOWELL & ASSOC., P.C.
ENGINEERS • SURVEYORS • PLANNERS
306 ENTERPRISE DRIVE, SUITE C
FOREST, VIRGINIA 24551
PHONE: (434) 385-7548 FAX: (434) 385-6178

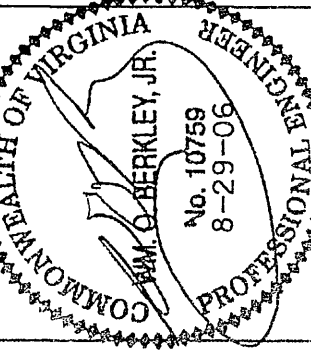

**WESTLAKE VILLAGE
BUSINESS PARK
WATERLINE EXTENSION**
GILLS CREEK DISTRICT FRANKLIN CO., VA.

PLAN & PROFILE

DATE: 6-30-06	
DRAWN:	
CHECKED:	
REVISIONS	
NO.	DATE
1	8-29-06

SCALES
HORIZ: AS SHOWN
VERT: AS SHOWN
COMM. NO.
030066
SHEET NO.
2 OF 2