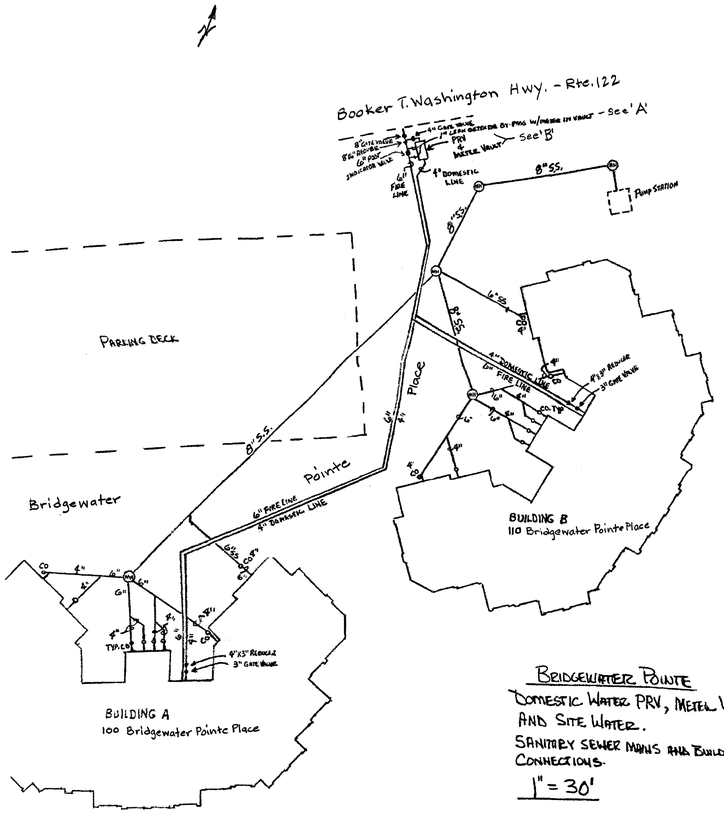

BRIDGEWATER POINTE
DOMESTIC WATER PRV, METER VAULT AND SITE WATER.
SANITARY SEWER MAINS AND BUILDING CONNECTIONS.
1" = 30'

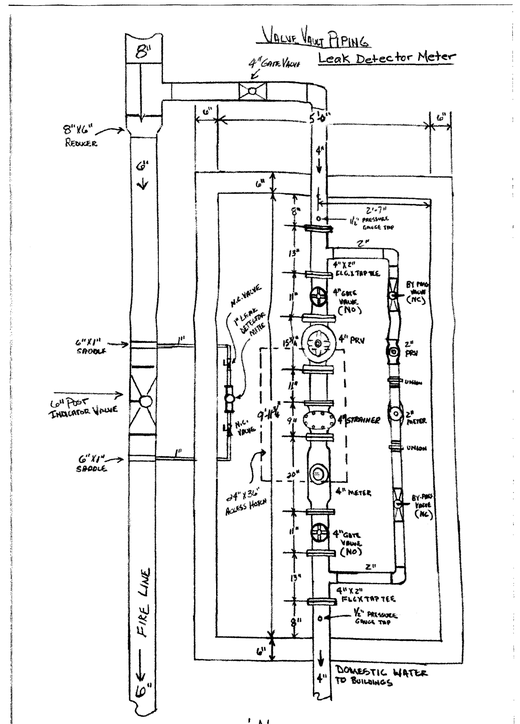

'A'
Leak Detector Meter

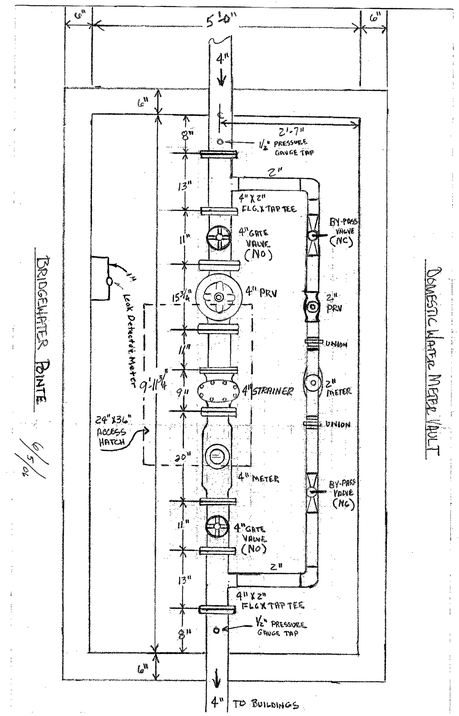

'B'
PRV and Meter Vault

PLAN & DETAIL SHEET - WATER - SEWER
FOR BRIDGEWATER POINTE
LOCATED ON SMITH MOUNTAIN LAKE
GILLS CREEK MAGISTERIAL DISTRICT
FRANKLIN COUNTY, VIRGINIA

DATE:	3/17/05
SCALE:	AS SHOWN
SHEET	6A OF 10
PROJECT NO.	04117