



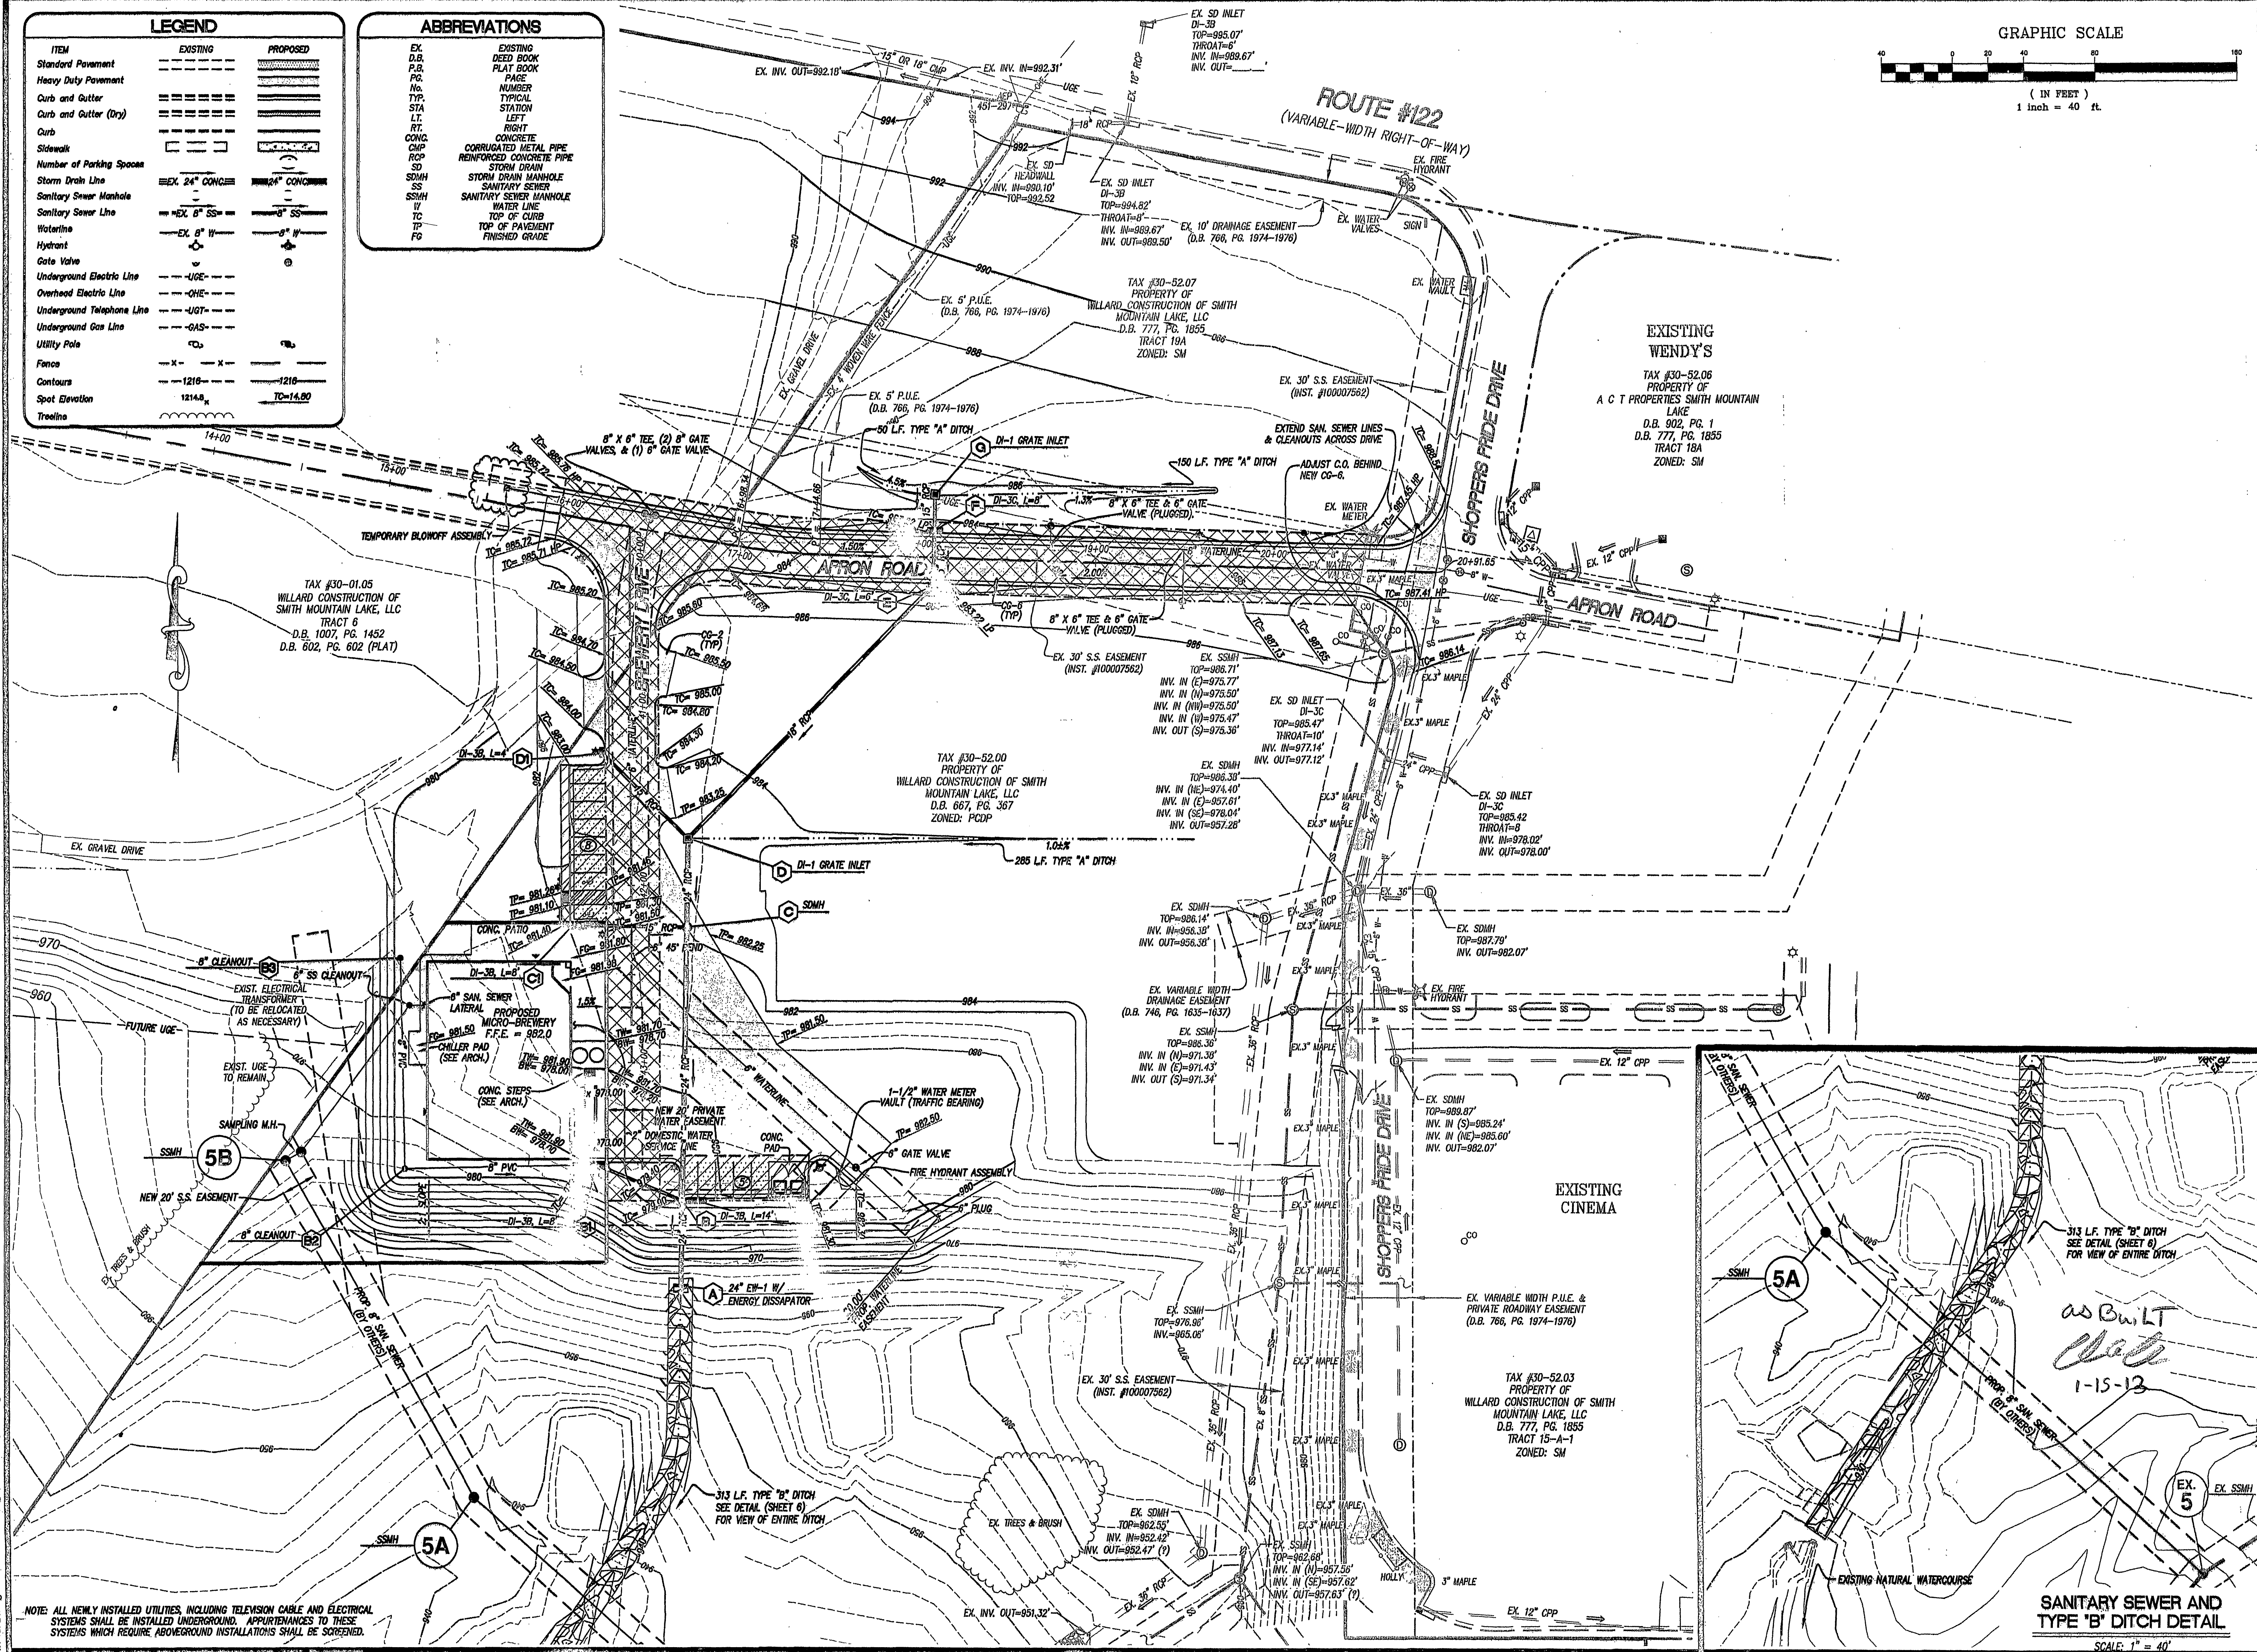

LUMSDEN ASSOCIATES, P.C.
ENGINEERS-SURVEYORS-PLANNERS
ROANOKE, VIRGINIA

4661 BRIMBLETON AVENUE
PO BOX 1000
ROANOKE, VIRGINIA 24018
PHONE: (540) 774-4411
FAX: (540) 772-8445
E-MAIL: NAIL@LUMSDENPC.COM

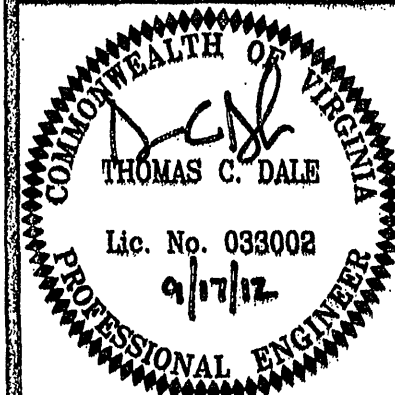

DAM LAGER MICRO-BREWERY WESTLAKE TOWNE CENTER
PREPARED FOR
WILLARD CONSTRUCTION OF SMITH MOUNTAIN LAKE, LLC
GILLS CREEK MAGISTERIAL DISTRICT
FRANKLIN COUNTY, VIRGINIA

NO.	DATE	REVISIONS
1	8/21/12	REVISOR: INSTALL TEMPORARY
2	9/17/12	REVISOR: BUILDING LOCATION & SIDEWALK
3		REVISOR: AROUND BUILDING REVISION
4		
5		
6		

DATE: August 15, 2012
SCALE: 1" = 40'
COMMISSION NO: 11-023
SHEET 6 OF 14